(MW)

ICHD - ENVIRONMENTAL HEALTH DIVISION

Statesville Office (704) 878-5305 Mooresville Office (704) 660-3625 PERMIT # 2023-20255

SEPTIC: IMPROVEMENT PERMIT / AUTHORIZATION TO CONSTRUCT / OPERATION PERMIT / EXISTING SYSTEM

PIN # 4639 -- 13 -- 3867 ✓

APPLICANT/OWNER: Troy Reeker APPLICANT ADDRESS: 226 Bullfinch Rd, Mooresville

SITE ADDRESS: 226 Bullfinch Rd Mooresville 28117 ✓ PHONE: 805-708-0876 ALT. PHONE

SITE DIRECTIONS: Perth - Fern Hill - Bullfinch SAP CONTROLLED: ☐ YES ☐ NO

SUBDIVISION: Beacon Pointe ✓ SECTION: - LOT # 5 ✓ LOT AREA: 0.7 acres DESIGN FLOW: 480 gpd L.T.A.R.: EX


Septic Tank	1000	(gal)	STB		Date		☒ New System	☐ Repair	☐ Expansion	System Type: I II III (IV) V VI	
Pump Tank	1000	(gal)	PT		Date		System Description:	LP Panel Black			
Pump Make			Model		Serial #		Repair System Description:	Same			
# Nitrification Fields	1		# Lines	4	Linear Ft	EX	Maintenance Agreement Required:	☒ YES	☐ NO		
Trench Width	EX		Trench Bottom Depth(Low side)		EX	Gravel Depth	EX	☐ GRAVITY	☒ PRESSURE		

☒ Residence	No. Bedrooms	4	**Water Supply**
☐ Business	No. Persons	8	☐ Private
☐ Other	No. Employees		☐ Public
☐ Slab	☐ Crawl Space		☒ Community
☒ Basement w/plumbing			☐ Basement w/o plumbing

Comments / Conditions: Purpose of this permit is to relocate tanks.
* 30' buffer must be marked during time of install *

Pump, crush, & fill old tanks.

INITIAL SITE SKETCH

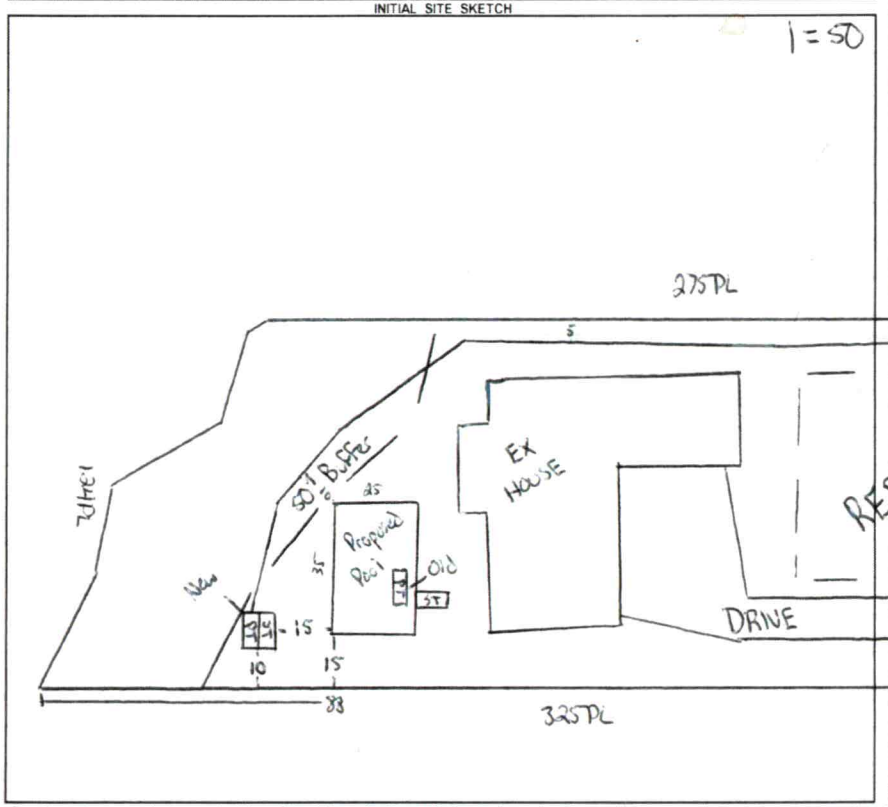

AS BUILT SKETCH

FOR SEPTIC FINAL INSPECTION CALL: 704-664-3703 between 8am-9am
the day the inspection is needed. Be sure to speak with an inspector to confirm your time.

Tanks - SH 10/6/23
* Make sure old tanks are pump, crushed, filled.
Owners out of town & needed to stay connected.

10-11-2023
BCW
- ELECTRICAL
- ALARM
- OLD TANK GONE

10/12/2023
FLOATS
PRESSURE
MAINTENANCE CONTRACT

Permit can be suspended or revoked if any false information is supplied toward securing the permit / any unauthorized changes are made to the site / any unauthorized changes are made in the installation of the system. **CONTACT A LOCATOR SERVICE PRIOR TO ANY EXCAVATION**

☐ **IMPROVEMENT PERMIT** *with plat* valid without expiration. ☒ **IMPROVEMENT PERMIT** *with site plan* valid for 60 mos. ☒ **AUTHORIZATION TO CONSTRUCT** valid for period equal to IMPROVEMENT PERMIT--not to exceed 60 mo.

Owner / Applicant Signature: Online Signature Date: Installed by: Abernathy

IMPROVEMENT PERMIT by: Cory Whit Date: 4/11/23 OPERATION PERMIT by: Sarah Williams Date: 10/26/2023

AUTHORIZATION TO CONSTRUCT by: Cory Whit Date: 4/11/23 Existing System Inspected by: Date:

FOR SEPTIC FINAL INSPECTION: CALL 704-664-3703 between 8am-9am the day the inspection is needed.

MW

ICHD - ENVIRONMENTAL HEALTH DIVISION

Statesville Office (704) 878-5305 Mooresville Office (704) 660-3625 PERMIT # 2023-20255

SEPTIC: IMPROVEMENT PERMIT / AUTHORIZATION TO CONSTRUCT / OPERATION PERMIT / EXISTING SYSTEM

PIN # 4639 -- 13 -- 3867

APPLICANT/OWNER: Troy Reiken APPLICANT ADDRESS: 226 Bullfinch Rd, Mooresville

SITE ADDRESS: 226 Bullfinch Rd, Mooresville 28117 PHONE: 805-708-0876 ALT. PHONE

SITE DIRECTIONS: Perth - Fern Hill - Bullfinch SAP CONTROLLED: ☐ YES ☐ NO

SUBDIVISION: Beacon Pointe SECTION: - LOT # 5 LOT AREA: 0.7 acres DESIGN FLOW: 480 gpd L.T.A.R.: EX

Septic Tank 1000 (gal) STB Date

Pump Tank 1000 (gal) PT Date

Pump Make Model Serial #

Nitrification Fields 1 # Lines 4 Linear Ft EX

Trench Width EX Trench Bottom Depth(Low side) EX Gravel Depth EX

☒ New System ☐ Repair ☐ Expansion System Type: I II III (IV) V VI

System Description: LP Panel Black

Repair System Description: Same

Maintenance Agreement Required: ☒ YES ☐ NO ☐ GRAVITY ☒ PRESSURE

☒ Residence No. Bedrooms 4

☐ Business No. Persons 8

☐ Other No. Employees

☐ Slab ☐ Crawl Space

☒ Basement w/plumbing ☐ Basement w/o plumbing

Water Supply

☐ Private

☐ Public


☒ Community

Comments / Conditions: Purpose of this permit is to relocate tanks.
* 30' buffer must be marked during time of install *

Pump, crush, & fill old tanks.

INITIAL SITE SKETCH

1 = 50

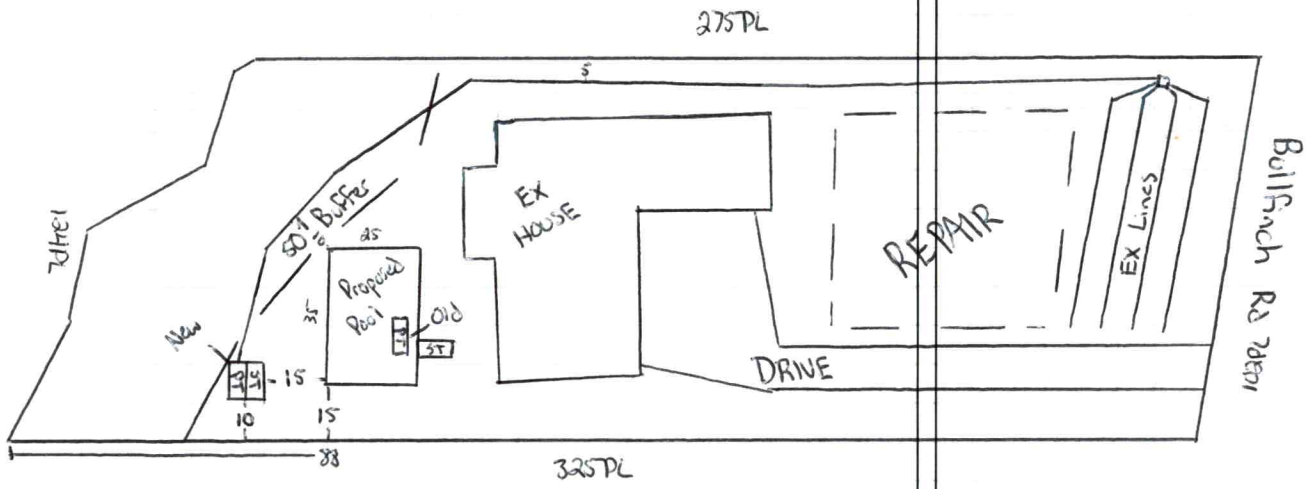

AS BUILT SKETCH

FOR SEPTIC FINAL INSPECTION CALL: 704-664-3703 between 8am-9am
the day the inspection is needed. Be sure to speak with an inspector to confirm your time.

Tanks - STH 10/6/23
* Make sure old tanks are pump, crushed, filled.
Owners out of town & need to stay connected.

Permit can be suspended or revoked if any false information is supplied toward securing the permit / any unauthorized changes are made to the site / any unauthorized changes are made in the installation of the system. **CONTACT A LOCATOR SERVICE PRIOR TO ANY EXCAVATION**


☐ **IMPROVEMENT PERMIT** ***with plat*** *valid without expiration.* ☒ **IMPROVEMENT PERMIT** ***with site plan*** *valid for 60 mos.* ☒ **AUTHORIZATION TO CONSTRUCT** *valid for period equal to IMPROVEMENT PERMIT--not to exceed 60 mo.*

Owner / Applicant Signature: Online Signature Date: Installed by: Abernathy

IMPROVEMENT PERMIT by: Cory Whit Date: 4/11/23 OPERATION PERMIT by: Date:

AUTHORIZATION TO CONSTRUCT by: Cory Whit Date: 4/11/23 Existing System Inspected by: Date:

FOR SEPTIC FINAL INSPECTION: CALL 704-664-3703 between 8am-9am the day the inspection is needed.

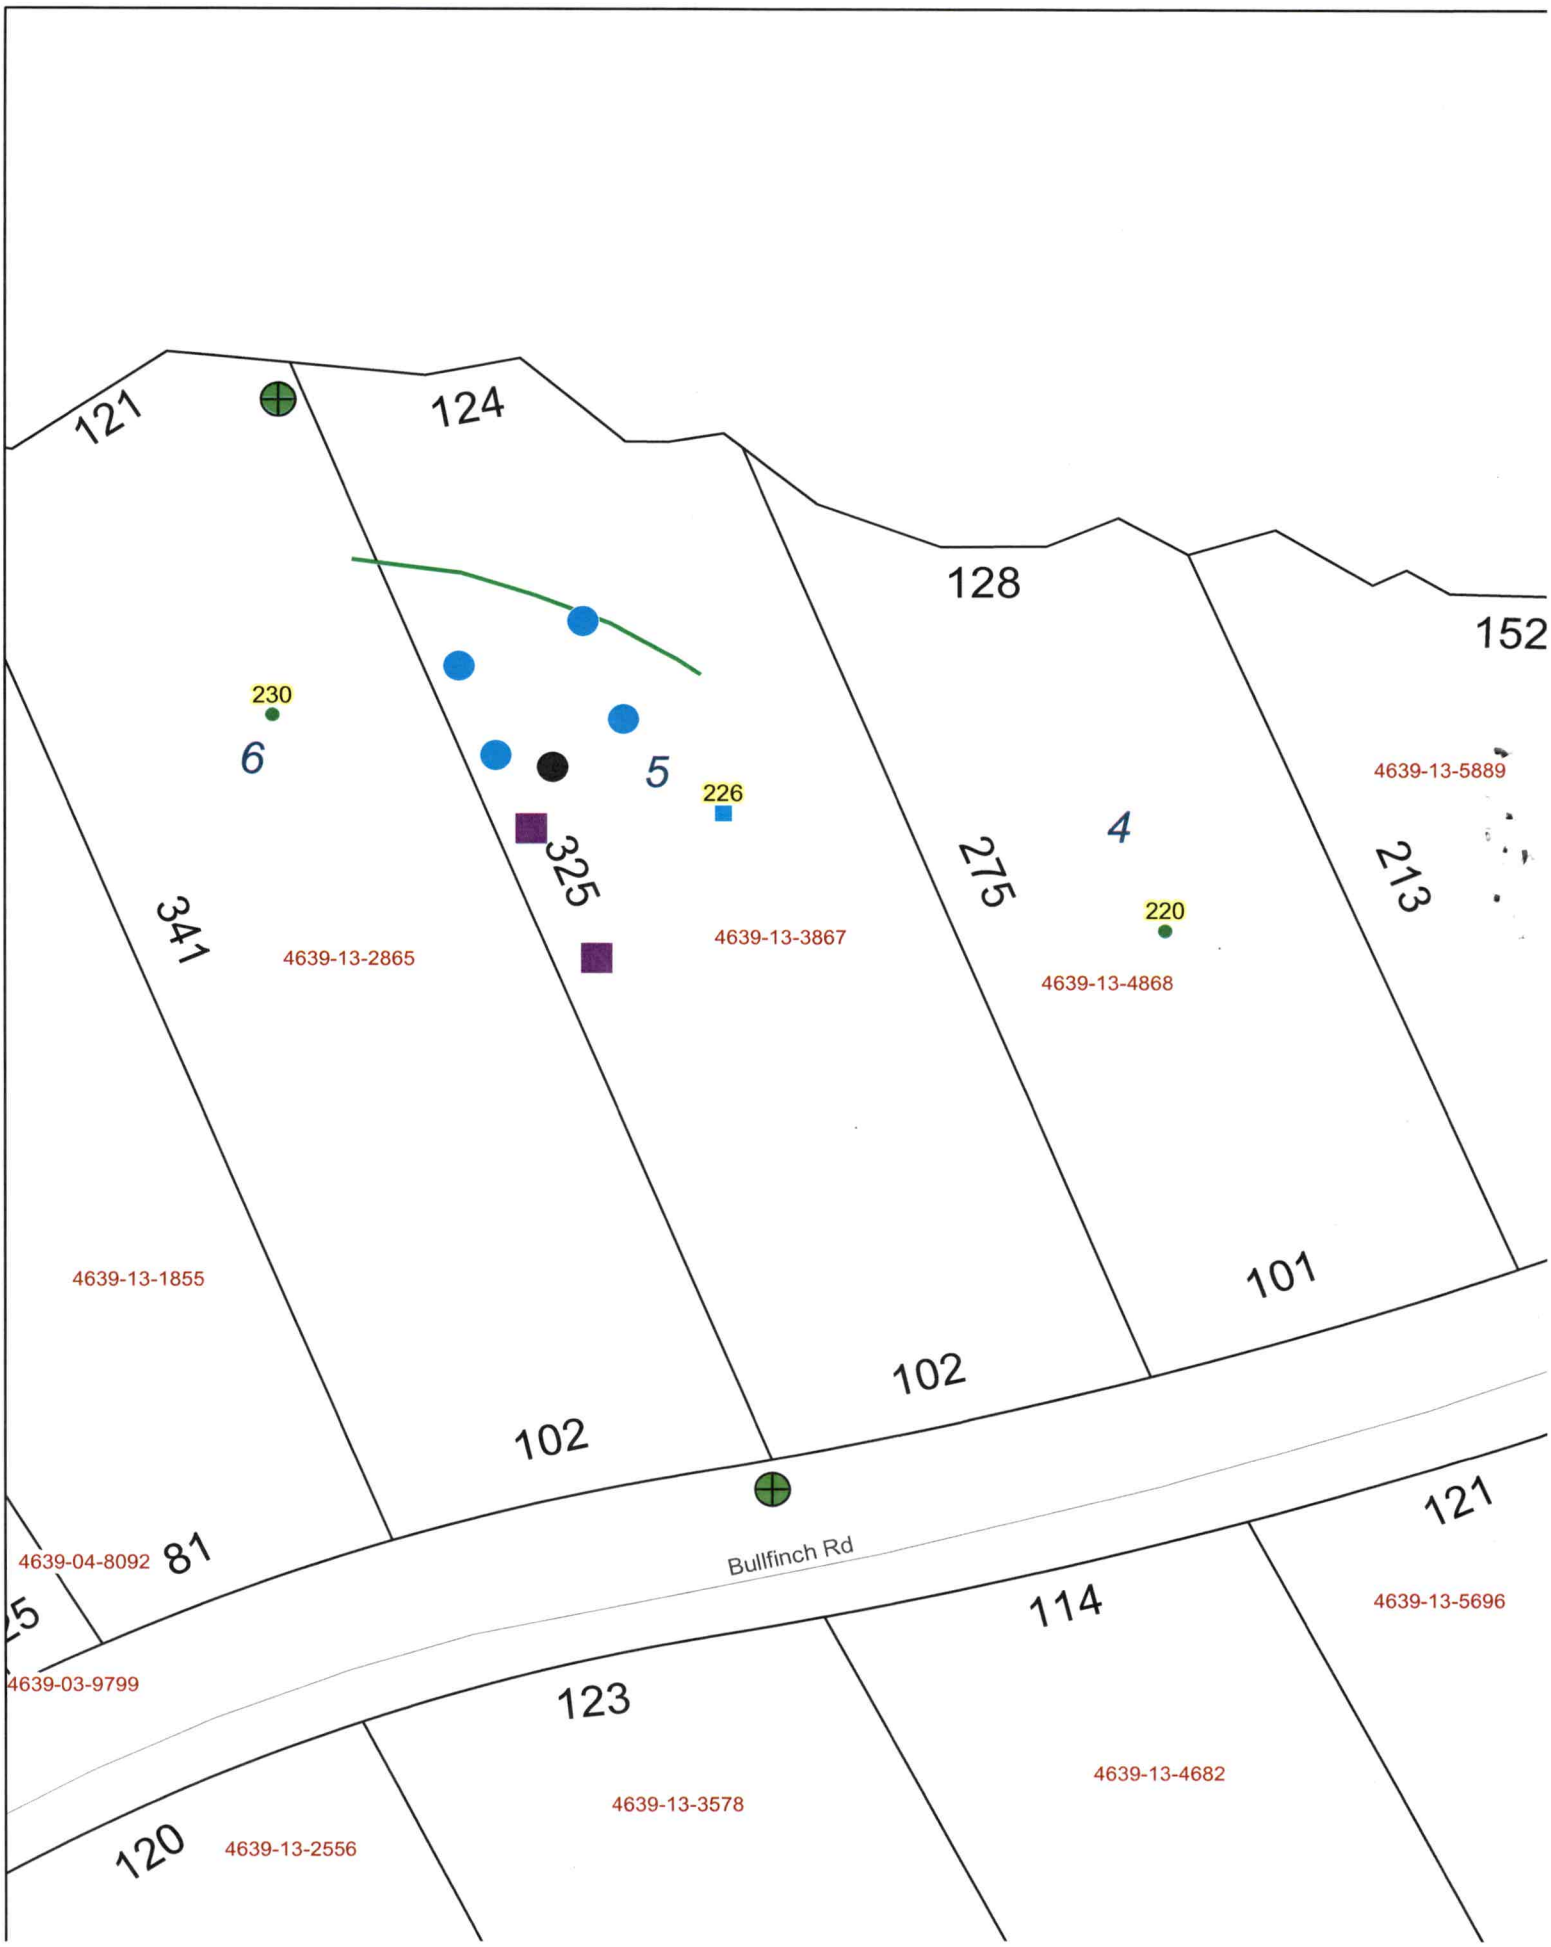
121
124
128
152
230
6
5
226
4
4639-13-5889
325
275
213
341
4639-13-2865
4639-13-3867
220
4639-13-4868
4639-13-1855
101
102
102
121
4639-04-8092
81
Bullfinch Rd
114
4639-13-5696
4639-03-9799
123
4639-13-4682
4639-13-3578
120
4639-13-2556