IREDELL COUNTY HEALTH DEPARTMENT

STATESVILLE 704-878-5305 MOORESVILLE 704-664-5281

IMPROVEMENT PERMIT / CERTIFICATE OF COMPLETION / OPERATION PERMIT / EXISTING SYSTEM INSPECTION

PROPERTY DESCRIPTION NO. 18881 DATE Dec 2 '94 TAX MAP NO. 25A51 4639137732 Watershed: ☒ Yes ☐ No WSIV

OWNER OR CONTRACTOR Crescent Resources Inc PHONE: Business Home

ADDRESS PO Box 1003 Charlotte

LOCATION Fern Hill Road TR Bullfinch 2nd lot on left after entering Beacon Pt

SUBDIVISION Beacon Pointe BLOCK / SECTION LOT 24 LOT AREA 1Ac SITE CLASS B per 1956 DESIGN FLOW 360 gpd L.T.A.R. .3

Septic Tank: 1000 Gallons; STB 794 Date 9-13-95

Pump Tank: 1000 Gallons; PT 27 Date 10-29-95

Pump Make: Goulds Model WE0711H Serial No. E9534711

Nitrification Field: No Fields 1 Square Feet Linear Feet 200

No Lines 2 Trench Width 24" Max Trench Bottom Depth 28" Gravel Depth NA

☒ New System ☐ Repair System Type: I, II, III, ☒ V, VI

System Description: LP PPBPS

Repair System Description: SAME

Maintenance Agreement Required: ☒ Yes ☐ No

☒ House/Mod. Home No. Bedrooms 3

☐ Mobile Home No. Bathrooms 3

☐ Business No. Employees

☐ Other

☐ Slab ~~Crawl~~ Space ☒ Basement w/plumbing ☐ Basement wo/plumbing


Water Supply: ☐ Individual ☒ Community ☐ Public

Comments: House site in old Roadbed Complex topo


Comments: DEVELOPER PERMIT 5/17/95 OK to have full basement. Where house is positioned the basement has a negligible effect on the nitification fall area. ORA

INITIAL SITE SKETCH

1"=50'

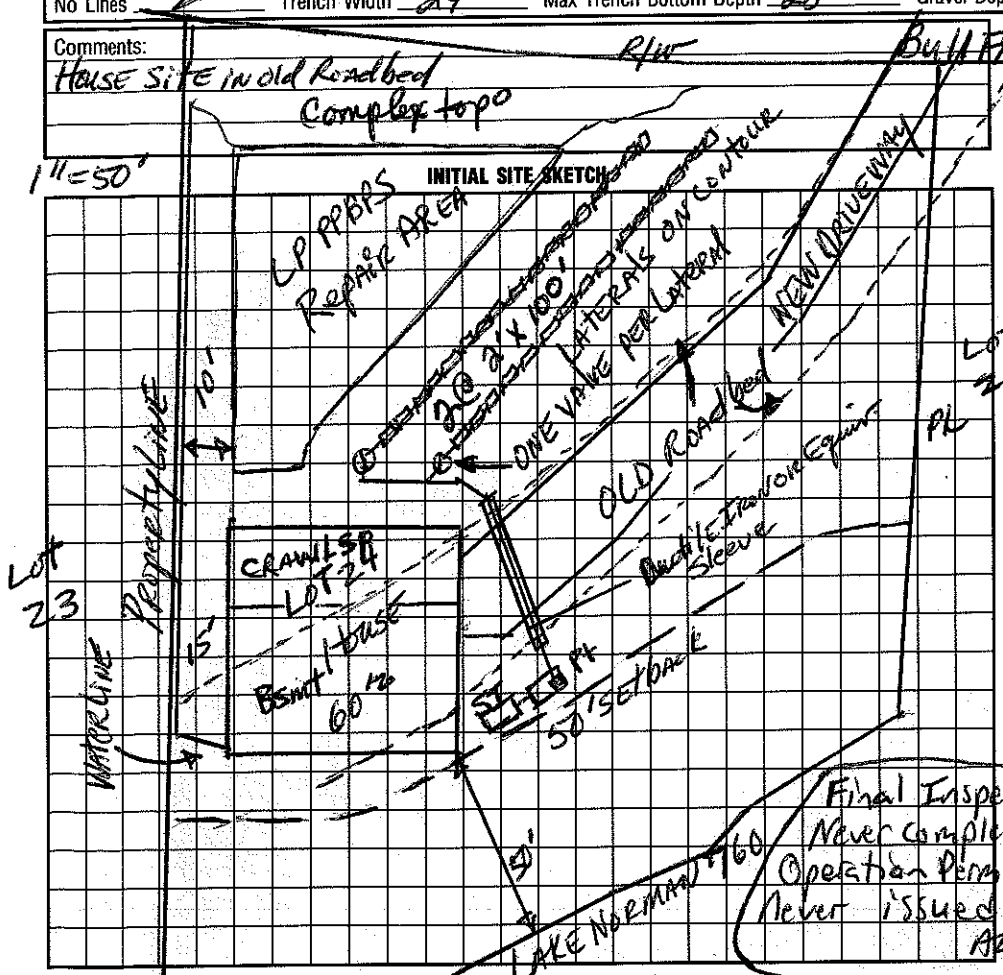

AS BUILT SKETCH

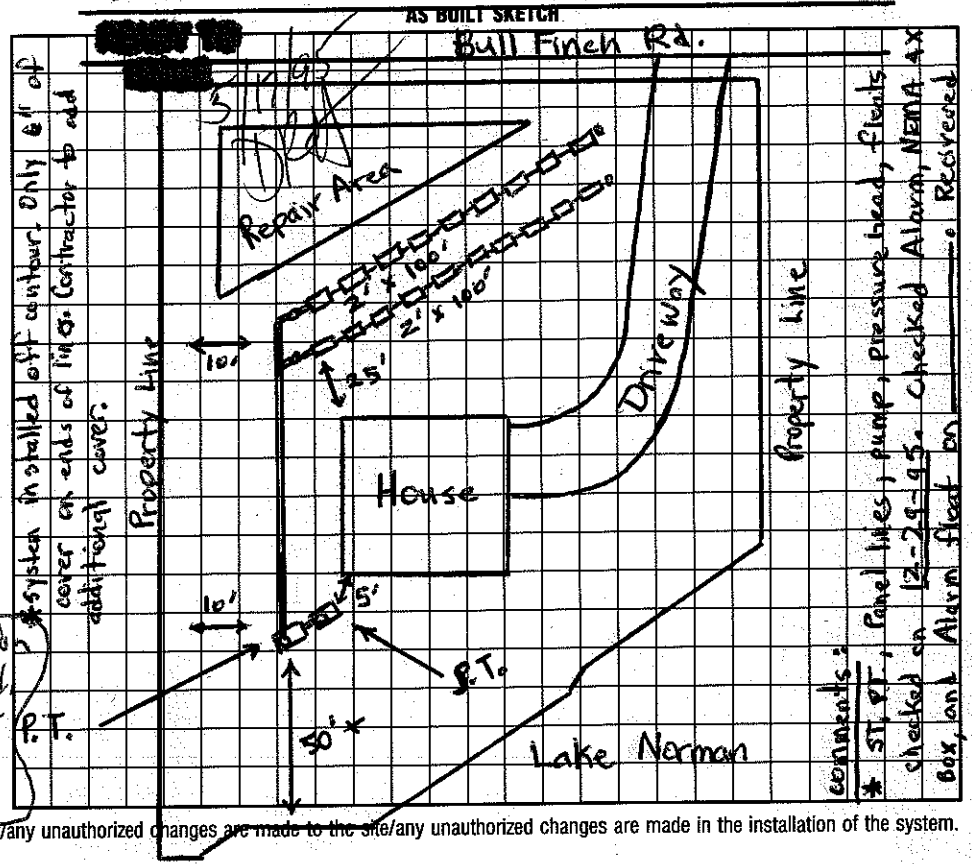

I understand that this permit can be suspended or revoked if any false information is supplied toward securing the permit/any unauthorized changes are made to the site/any unauthorized changes are made in the installation of the system. Improvement Permit is ~~valid for 60 months~~ from date of issuance.

Signed: date 12/5/94

Improvement Permit by: date 12/2/94

Existing System Inspection by: date

Installed by: F.J. Ervin

Certificate of Completion by: date

Operation Permit by: date

HEALTH DEPT. COPY: WHITE INSPECTION COPY (FINAL): GREEN OWNER COPY (FINAL): YELLOW INSPECTION COPY (INITIAL): PINK OWNER COPY (INITIAL): GOLD