IREDELL COUNTY HEALTH DEPARTMENT


ENVIRONMENTAL HEALTH DIVISION

PAGE 2: *SITE PLAN WORKSHEET*

SEE THE "SAMPLE SITE PLAN" BELOW. *INCOMPLETE SITE PLANS WILL BE RETURNED TO YOU FOR COMPLETION AND MAY RESULT IN A DELAY IN THE ISSUANCE OF YOUR SEPTIC SYSTEM PERMIT!!*

Place an (X) beside each item as you complete the site plan:

- (X) Property Line measurements are clearly identified
- ( ) All proposed structures are indicated
- ( ) Front and side setbacks from property line
- ( ) Preferred driveway location and well location
- ( ) Area you prefer your septic system to be placed
- ( ) North arrow, or other sufficient indicator of direction

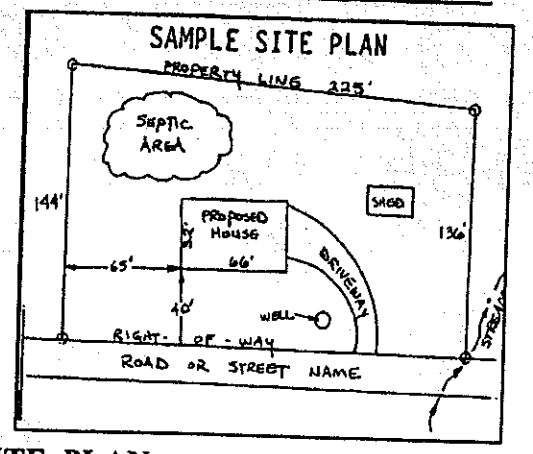

Circle N/A on the following if appropriate:

Location of septic systems and wells within 100' of your property	N/A
Location of easements and rights of ways on your property	N/A
Location of any designated wetlands on the property	N/A

USE THIS SPACE TO DRAW YOUR SITE PLAN

Show: proposed house or business footprint, wells, water lines, patios, pools and decks, and any other item that will occupy space on the site

Existing System Tank is 10' from existing deck
deck will be extended 4' 2nd Story added to
Right side of house
My Cell - 704-791-1945 would like to meet for inspection

Signature John A. Wolfe

Property owner or owner's legal representative signature (SIGNATURE REQUIRED)

9-2-15

DATE

IREDELL COUNTY HEALTH DEPARTMENT

STATESVILLE 704-878-5305 MOORESVILLE 704-664-5281

IMPROVEMENT PERMIT / AUTHORIZATION TO CONSTRUCT / OPERATION PERMIT / EXISTING SYSTEM INSPECTION

PERMIT# Repair PIN# 4639143646 DATE 8/21/02

OWNER OR CONTRACTOR John Webb PHONE: Business Home 704-791-1945

ADDRESS 328 Marietta Rd Troutman NC 28166

LOCATION Perth, TL Fern Hill, TR Bullfinch, TR Marietta, on Lt #328

SUBDIVISION C.L.T BLOCK / SECTION 16 LOT 25 LOT AREA 0.994C SITE CLASS. P5 DESIGN FLOW 360 L.T.A.R.

Septic Tank: 1000 Gallons; STB 794 Date 3/21/01

Pump Tank: Gallons; PT Date

Pump Make: Model Serial No.

Nitrification Field: No Fields Square Feet 540 Linear Feet

No Lines 9"x60' Trench Width Max Trench Bottom Depth Gravel Depth

☐ New System ☒ Repair System Type: I, II, III, IV, V

System Description: 25% Reduction Bed

Repair System Description:

Maintenance Agreement Required: ☐ Yes ☒ No

☒ House/Mod. Home No. Bedrooms 3

☐ Mobile Home No. Bathrooms 2

☐ Business No. Employees

☐ Other


☐ Slab ☒ Crawl Space ☐ Basement w/plumbing ☐ Basement wo/plumbing

Water Supply: ☒ Individual ☐ Public ☐ Community


Comments/Conditions: Pump, Crush, + Fill Old Septic Tank - Bed can be 12' wide if possible - Property Line Not clearly Marked at Inspection.

Comments/Conditions: Existing bed can be used if a Terra-Lift is Done

INITIAL SITE SKETCH NOT TO SCALE

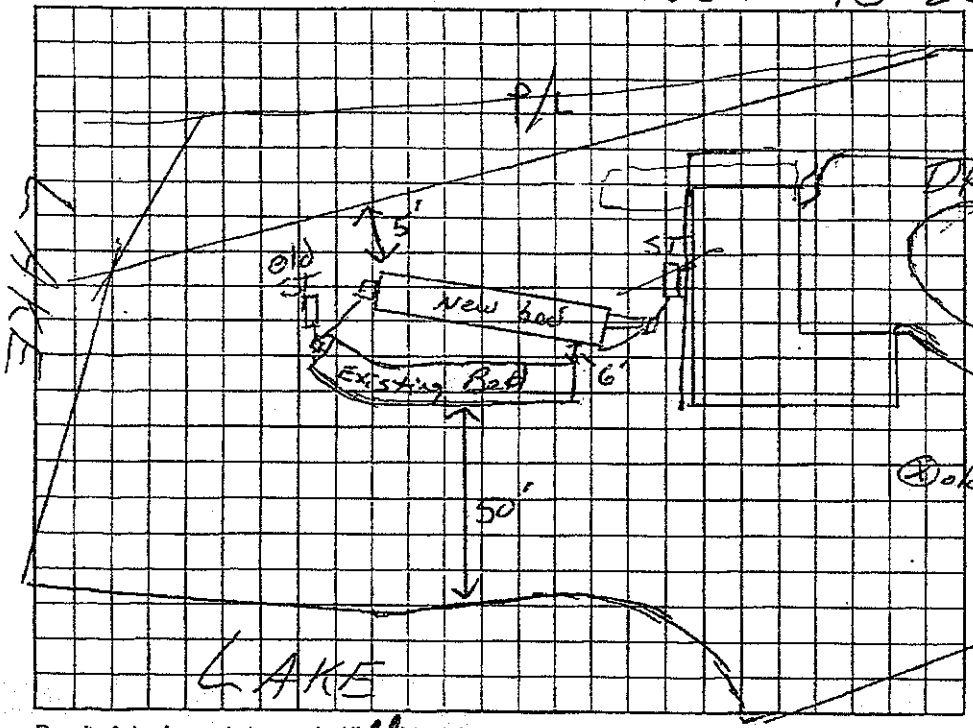

AS BUILT SKETCH

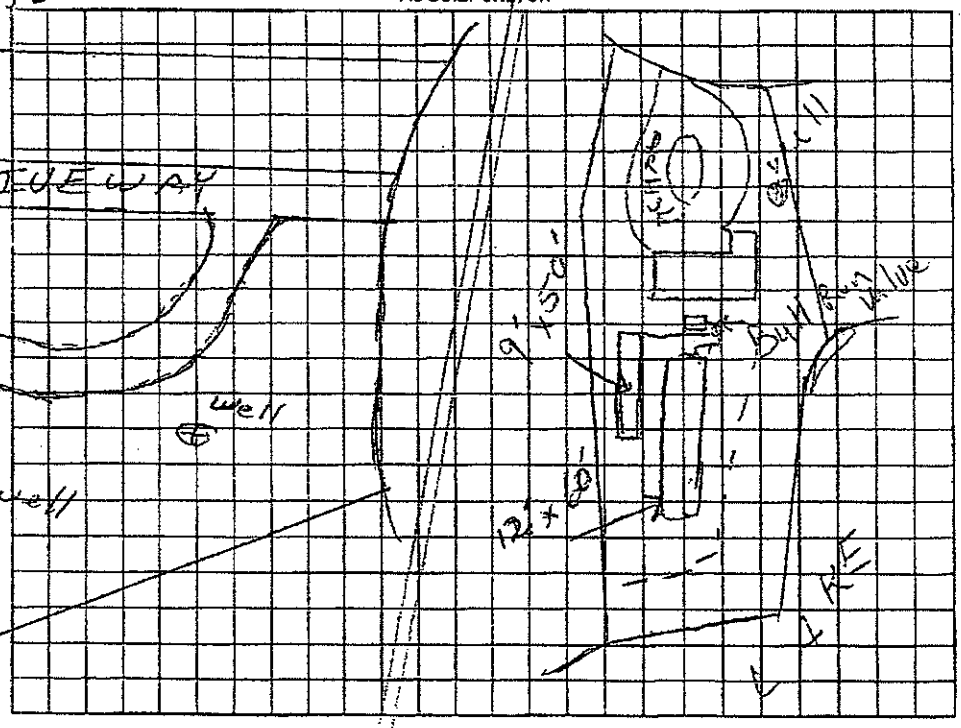

Permit can be suspended or revoked if any false information is supplied toward securing the permit/any unauthorized changes are made to the site/any unauthorized changes are made in the installation of the system. Improvement Permit with plat valid without expiration. Improvement Permit with site plan valid for sixty months. Authorization to Construct is valid for a period equal to that of Improvement Permit – not to exceed sixty months.

Signed: John A. Webb date 8/21/02 Installed by: Richard Abernathy

Improvement Permit by: RS date 8/21/02 Operation Permit by: RS date 9/28/05

Authorization to Construct by: RS date 8/21/02 Existing System Inspection by: date

HEALTH DEPT. COPY: WHITE OWNER COPY (FINAL): YELLOW OWNER COPY (INITIAL): PINK