IREDELL COUNTY HEALTH DEPARTMENT

Statesville Phone TR 3-7271 Mooresville Phone NO 3-1271

PERMIT TO INSTALL SEPTIC TANK

Permit No. 71 Permit Date 5-9 19 7-

Owner CARL JOHNSON Address STATESVILLE, N.C.

Installed By CARL JOHNSON Address STATESVILLE, N.C.

Location of Property


SECTION 16 - LOT 24

Tank		Capacity		Length of Lines		Fixtures	
Block	( )	1000	(✓)	225'	(✓)	No. of Baths	(1)
Precast	(✓)	1250	( )	250'	( )	Dishwasher	( )
		1500	( )	Other 240		Garbage Grdr.	( )
		Other				Other	

NOTIFY HEALTH DEPARTMENT AT LEAST EIGHT HOURS BEFORE TANK IS TO BE INSPECTED.

Final Inspection 5-9 19 7- Approved (✓) Disapproved ( )

Remarks WATER SUPPLY FROM NEXT LOT

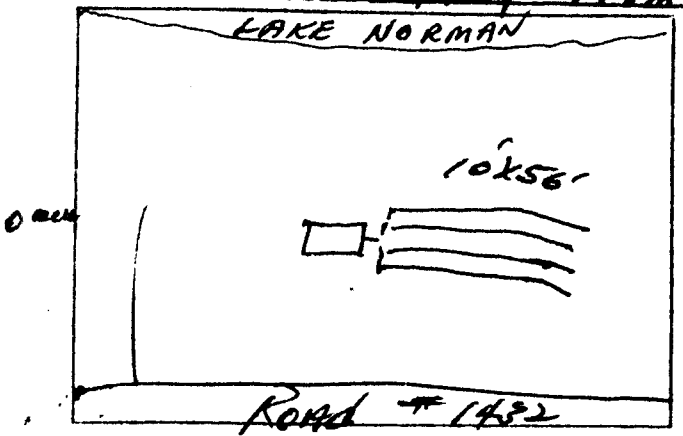

Sketch of Installation

Sanitarian