IREDELL COUNTY HEALTH DEPARTMENT

STATESVILLE 704-878-5305 50.00 Paid MOORESVILLE 704-664-5281 4:00

IMPROVEMENT PERMIT / AUTHORIZATION TO CONSTRUCT / OPERATION PERMIT / EXISTING SYSTEM INSPECTION

PERMIT# 078844 PIN# 4639 14 8842 704 799-7544 DATE 4/12/2002

OWNER OR CONTRACTOR Doug Haney (Flagship Builders) PHONE: Business 980 721-1249 Home 980 721-1249

ADDRESS 111 Angler Plz Mooresville, NC 28117

LOCATION Perth Rd North TL Fern Hill TR Bull Finch TR Marietta on right 331 Marietta

SUBDIVISION Beacon Pointe BLOCK / SECTION II LOT 12 LOT AREA _____ SITE CLASS. _____ DESIGN FLOW _____ L.T.A.R. _____

Septic Tank: 1000 Gallons; STB 10/2 Date 5-18-02
Pump Tank: 1000 Gallons; PT 7 Date 7-14-02
Pump Make: _____ Model _____ Serial No. _____
Nitrification Field: No Fields 1 Square Feet 1200' Linear Feet 400'
No Lines 30 33 Trench Width 36" Max Trench Bottom Depth 36" Gravel Depth 12"

☒ New System ☐ Repair System Type: I, II, III, IV, V, VI
System Description: Pump (Pm) - Conventional
Repair System Description: Same
Maintenance Agreement Required: ☐ Yes ☒ No


☒ House/Mod. Home No. Bedrooms 3
☐ Mobile Home No. Bathrooms 2.5
☐ Business No. Employees _____
☐ Other _____
☐ Slab ☒ Crawl Space ☐ Basement w/plumbing ☐ Basement wo/plumbing

Water Supply: ☐ Individual ☒ Public ☒ Community


Comments/Conditions: Keep Septic System at least 10' From PL. (House may be closer than 120' From Marietta Rd)

Comments/Conditions: Checked tanks & lines 8/20/2002 TMP
Press, elect & alarm 11/15/2002

INITIAL SITE SKETCH Scale 1:50'

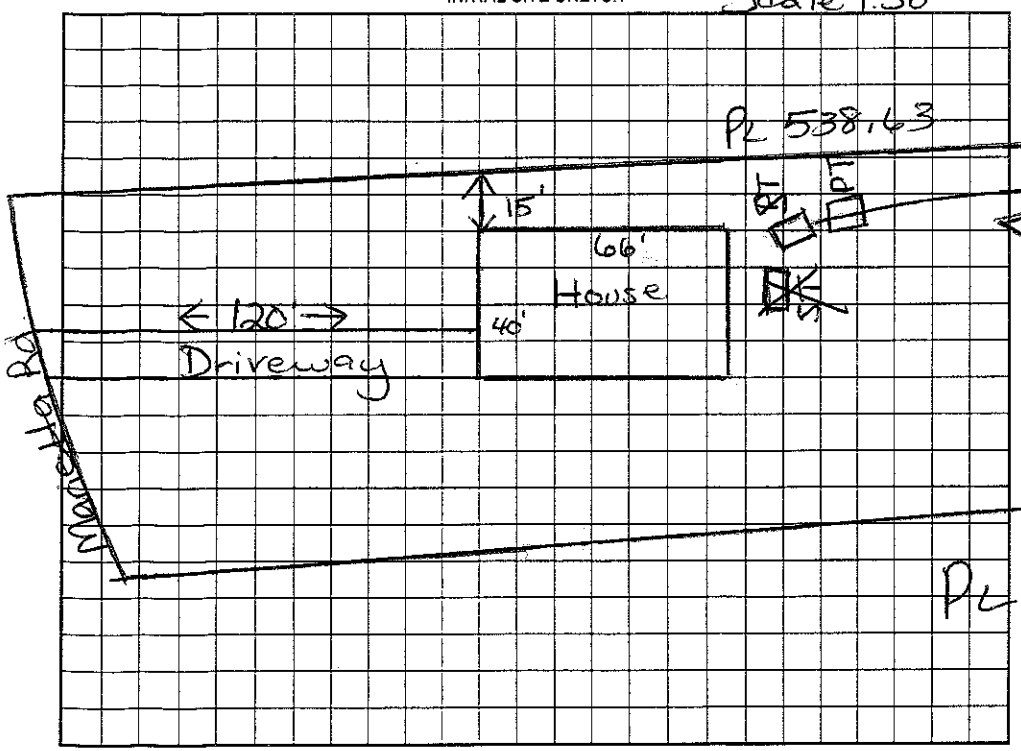

AS BUILT SKETCH

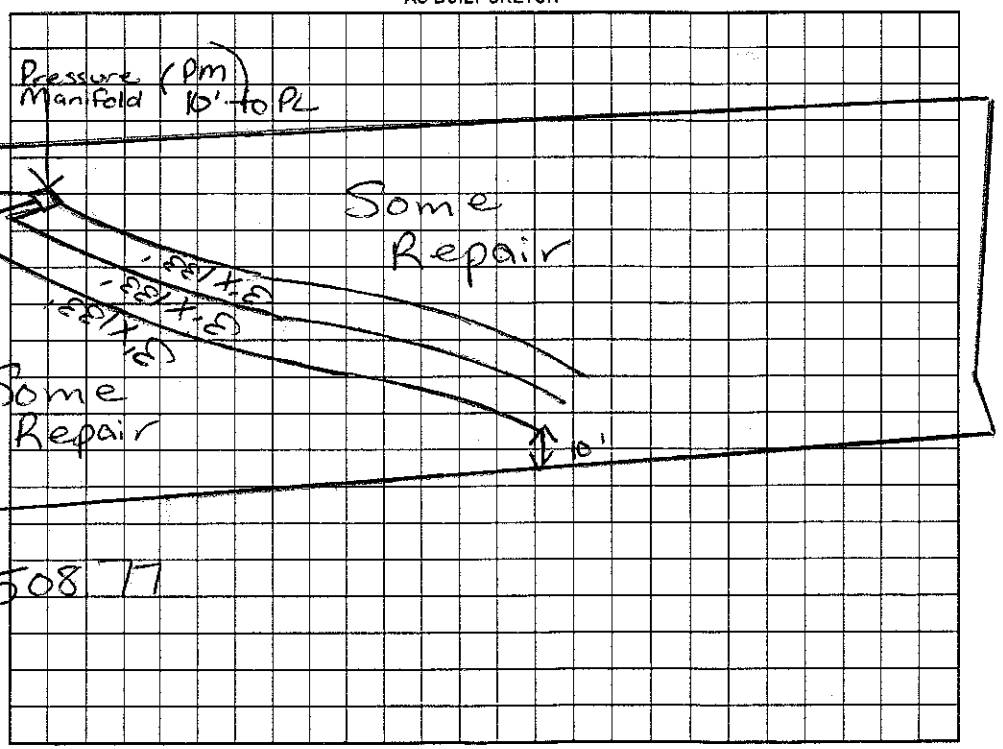

Permit can be suspended or revoked if any false information is supplied toward securing the permit/any unauthorized changes are made to the site/any unauthorized changes are made in the installation of the system. Improvement Permit with plat valid without expiration. Improvement Permit with site plan valid for sixty months. Authorization to Construct is valid for a period equal to that of Improvement Permit – not to exceed sixty months.

Signed: X Douglas A. Haney date 4/15/02 Installed by: Richard Abernathy

Improvement Permit by: Maria H. Dotson RS date 4/12/2002 Operation Permit by: Maria H. Dotson RS date 11/15/2002

Authorization to Construct by: Maria H. Dotson RS date 4/12/2002 Existing System Inspection by: _____ date _____

HEALTH DEPT. COPY: WHITE OWNER COPY (FINAL): YELLOW OWNER COPY (INITIAL): PINK