IREDELL COUNTY HEALTH DEPARTMENT

STATESVILLE 704-878-5305 MOORESVILLE 704-664-5281

IMPROVEMENT PERMIT / AUTHORIZATION TO CONSTRUCT / OPERATION PERMIT / EXISTING SYSTEM INSPECTION

PERMIT# D78842 PIN# 4639149688 DATE 5/13/99

OWNER OR CONTRACTOR Crescent Resources PHONE: Business 664-1010 Home

ADDRESS P.O. Box 1003 Charlotte NC 28201

LOCATION Perth Rd TR Fern Hill TR Marrietta Rd lot on left (341 Marietta Rd.)

SUBDIVISION Beacon Pt. BLOCK / SECTION II LOT 10 LOT AREA 1.03 Acre SITE CLASS. PS DESIGN FLOW 480gpd L.T.A.R. .3

Septic Tank: 1000 Gallons; STB 825 Date 3/23/01

Pump Tank: 1000 Gallons; PT 302 Date 9/9/01

Pump Make: Zoeller Model N137 Serial No. 12/5/2000

Nitrification Field: No Fields 1 Square Feet 1605' Linear Feet 535'

No Lines 5 at 107' Trench Width 36" Max Trench Bottom Depth 36" Gravel Depth 12"

☒ New System ☐ Repair System Type: I II (III) IV. V. VI

System Description: Pump to Conventional

Repair System Description: Pump to Conventional

Maintenance Agreement Required: ☐ Yes ☐ No

☒ House/Mod. Home No. Bedrooms 4

☐ Mobile Home No. Bathrooms 4

☐ Business No. Employees

☐ Other


☐ Slab ☒ Crawl Space ☐ Basement w/plumbing ☐ Basement wo/plumbing

Water Supply: ☐ Individual ☒ Public ☒ Community


Comments/Conditions: Keep Septic System at least 10' From PL & 5' from House. Driveway switched to other side of lot. Plans reviewed & okayed 4/23/2001

Comments/Conditions: Okay to move Drainfield closer to houses in repair area.

INITIAL SITE SKETCH Scale = 1:50

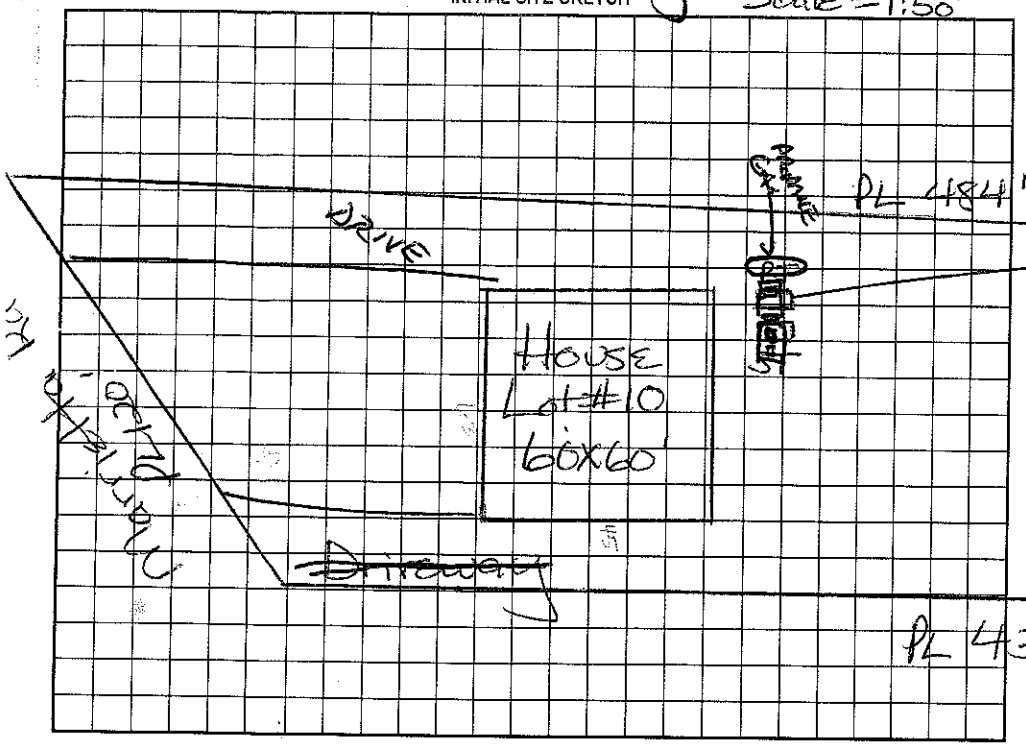

AS BUILT SKETCH

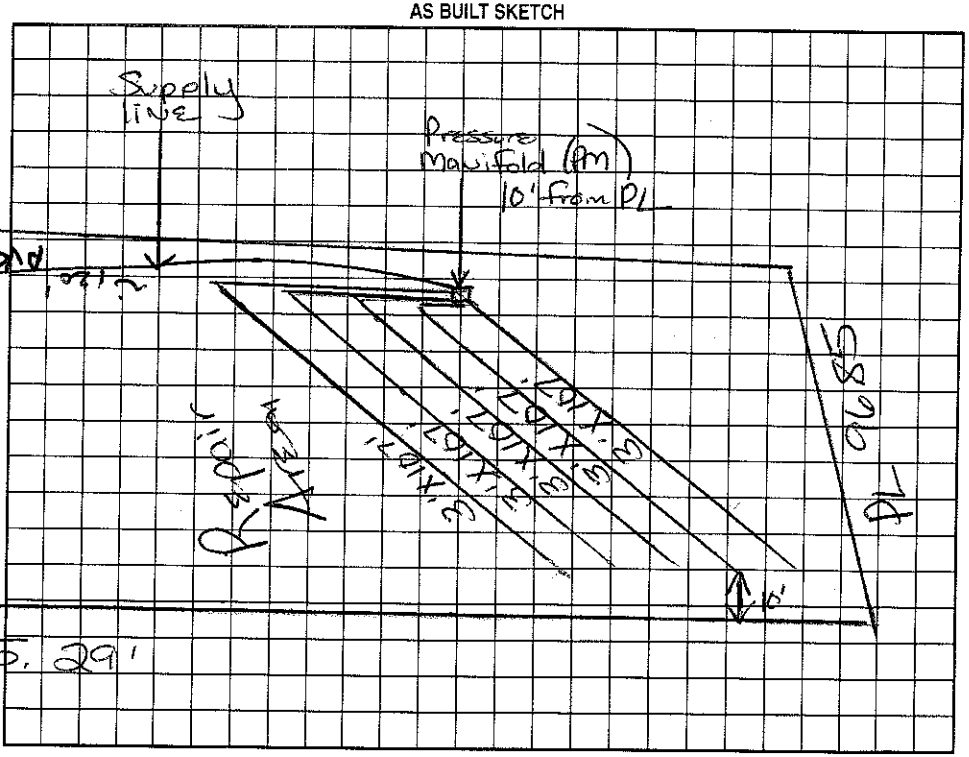

Permit can be suspended or revoked if any false information is supplied toward securing the permit/any unauthorized changes are made to the site/any unauthorized changes are made in the installation of the system. Improvement Permit with plat valid without expiration. Improvement Permit with site plan valid for sixty months. Authorization to Construct is valid for a period equal to that of Improvement Permit – not to exceed sixty months.

Signed: P.K.F. date 5-21-99

Improvement Permit by: Maria H. Tolson R.S. date 5/13/99

Authorization to Construct by: Maria H. Tolson R.S. date 4/23/2001

Installed by: Rowan Septic Tank

Operation Permit by: Wesley Sparks R.S. date 3/27/02

Existing System Inspection by: date

HEALTH DEPT. COPY: WHITE OWNER COPY (FINAL): YELLOW OWNER COPY (INITIAL): PINK