IREDELL COUNTY HEALTH DEPARTMENT

STATESVILLE 704-878-5305 MOORESVILLE 704-664-5281

IMPROVEMENT PERMIT / CERTIFICATE OF COMPLETION / OPERATION PERMIT / EXISTING SYSTEM INSPECTION

PROPERTY DESCRIPTION NO. 26236 DATE 3/13/97 TAX MAP NO. 4639154340 Watershed: ☑ Yes ☐

OWNER OR CONTRACTOR RUBY LOUISE BRADLEY PHONE: Business Home

ADDRESS 298 MARIETTA RD

LOCATION PERTH RD. N- TL FERNHILL RD- TR MARIETTA RD - F 278 MARIETTA RD

SUBDIVISION CL+T BLOCK / SECTION 16 LOT 31 LOT AREA SITE CLASS. BS DESIGN FLOW 360 L.T.A.R. EXISTING

Septic Tank: Gallons; STB Date

Pump Tank: Gallons; PT Date

Pump Make: EXISTING Model Serial No.

Nitrification Field: No Fields Square Feet Linear Feet

No Lines Trench Width Max Trench Bottom Depth Gravel Depth

☑ New System ☐ Repair System Type: I, II, III, IV, V, VI

System Description: GRAVITY BED SYSTEM

Repair System Description:

Maintenance Agreement Required: ☐ Yes ☐ No

☐ House/Mod. Home No. Bedrooms 3

☑ Mobile Home No. Bathrooms 2

☐ Business No. Employees

☐ Other

☐ Slab ☐ Crawl Space ☐ Basement w/plumbing ☐ Basement wo/plumbing


Water Supply: ☑ Individual ☐ Community ☐ Public

Comments:

Comments: REPLACING 3BR HOUSE WITH 3 BR MH.

INITIAL SITE SKETCH

AS BUILT SKETCH

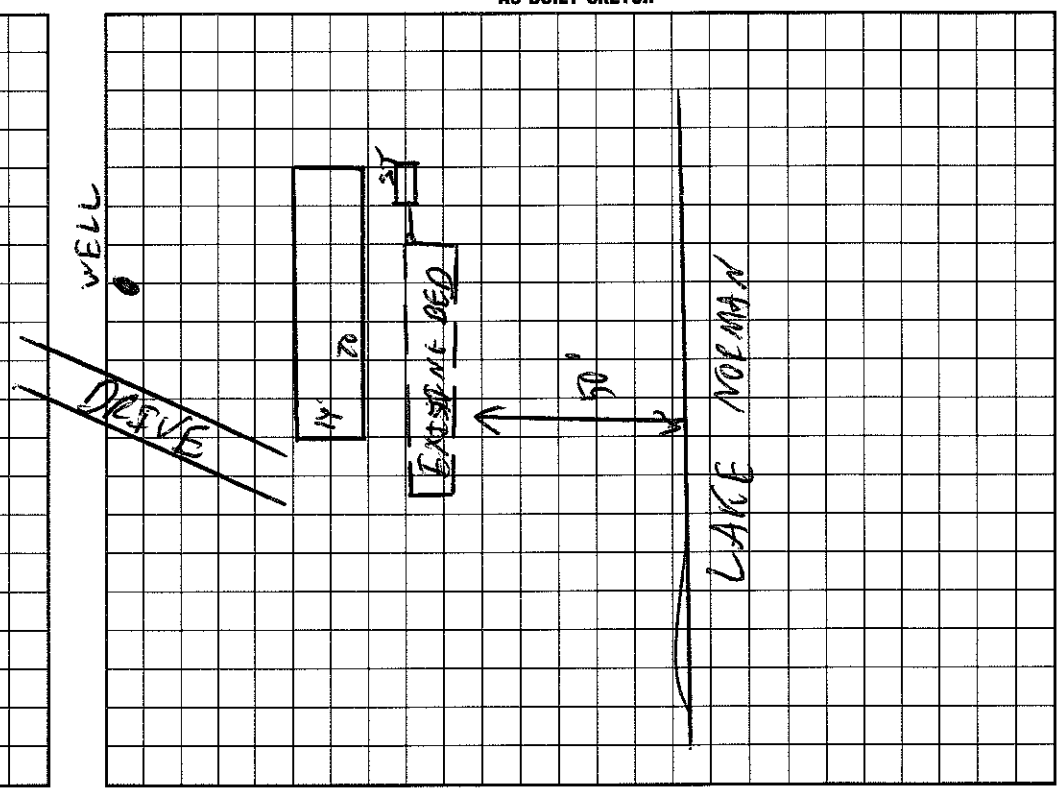

I understand that this permit can be suspended or revoked if any false information is supplied toward securing the permit/any unauthorized changes are made to the site/any unauthorized changes are made in the installation of the system. Improvement Permit is valid for 60 months from date of issuance.

Signed: Kathleen S. Thomas

Installed by:

Improvement Permit by: date

Certificate of Completion by: date

Existing System Inspection by: C. [signature] date 3/10/97

Operation Permit by: C. [signature] date 3/13/97

HEALTH DEPT. COPY: WHITE INSPECTION COPY (FINAL): GREEN OWNER COPY (FINAL): YELLOW INSPECTION COPY (INITIAL): PINK OWNER COPY (INITIAL): GOLD