IREDELL COUNTY HEALTH DEPARTMENT

STATESVILLE 704-878-5305 $550.00 Paid MOORESVILLE 704-664-5281

IMPROVEMENT PERMIT / AUTHORIZATION TO CONSTRUCT / OPERATION PERMIT / EXISTING SYSTEM INSPECTION

PERMIT# 136484 PIN# 4639156299 DATE 7-13-06

OWNER OR CONTRACTOR Donna Byrnes PHONE: Business Donna 701-3704 Home 663-0082 701-3704

ADDRESS 152 Wynward Ln Mooresville, NC 28117

LOCATION Perth Rd TR Fern Hill TR Marietta on left

SUBDIVISION Beacon Pt BLOCK / SECTION II LOT 16 LOT AREA .717 Acre SITE CLASS PS DESIGN FLOW 480gpd L.T.A.R. .3 to .4

Septic Tank: 1000 Gallons; STB 1007 Date 8-27-01

Pump Tank: 1000 Gallons; PT 274 Date 8-21-07

Pump Make: Zoeller Model N152-B Serial No.

Nitrification Field: No Fields 1 Square Feet 1200' Linear Feet 400'

No Lines 4 Trench Width 36" Max Trench Bottom Depth 36

☒ New System ☐ Repair System Type: I, II, III, IV, V, VI

System Description: Pump-PM-25% Reduction

Repair System Description: Pump-PM-25-50% Reduct

Maintenance Agreement Required: ☐ Yes ☒ No

Gravel Depth N/A ☐ Slab ☒ Crawl Space ☐ Basement w/plumbing ☐ Basement wo/plumbing

☒ House/Mod. Home No. Bedrooms 4

☐ Mobile Home No. Bathrooms

☐ Business No. Employees


☐ Other

Water Supply: ☐ Individual ☒ Public ☒ Community


Comments:/Conditions: Keep Septic System at least 10' From PL & 15ft from pool & 100' from any well

Comments:/Conditions: Okay to Install 5 line @ 80 ft ea (divide last line into 2-40' lines) 11/9/09 ZAT Pressure set, elect & alarm

INITIAL SITE SKETCH Scale 1:50

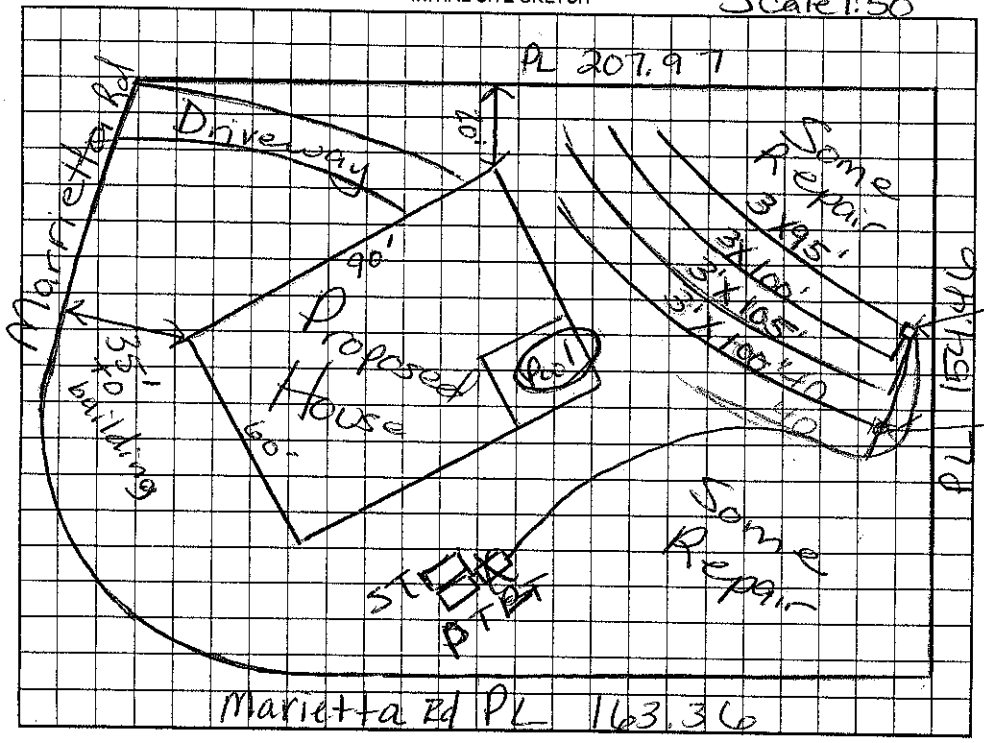

AS BUILT SKETCH

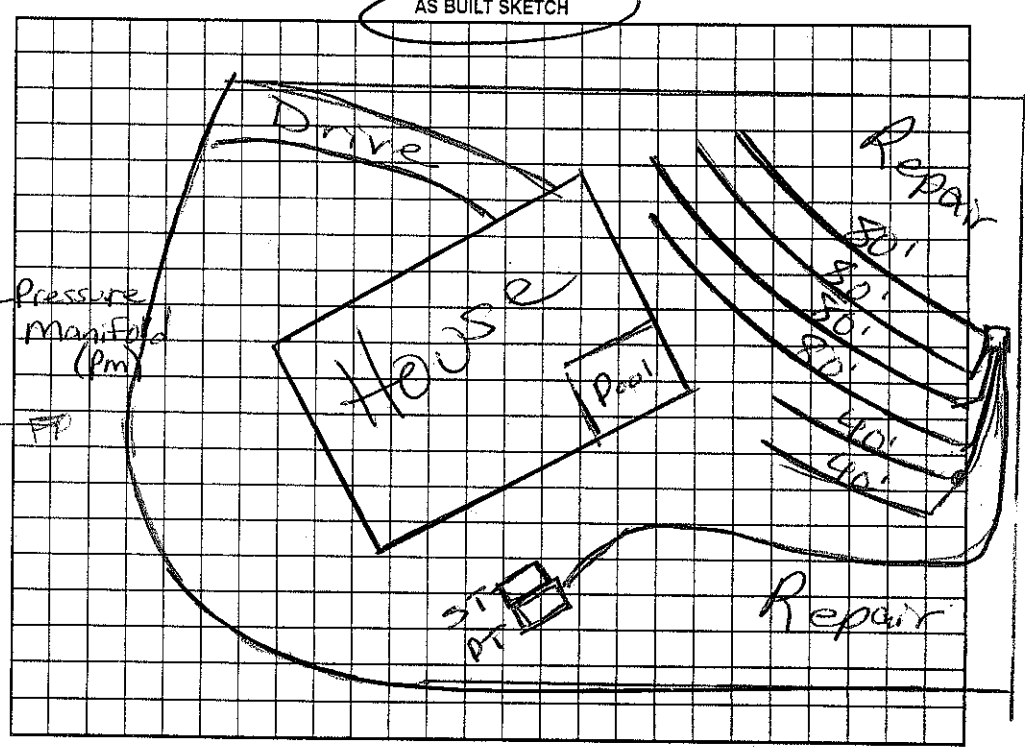

Permit can be suspended or revoked if any false information is supplied toward securing the permit/any unauthorized changes are made to the site/any unauthorized changes are made in the installation of the system. Improvement Permit with plat valid without expiration. Improvement Permit with site plan valid for sixty months. Authorization to Construct is valid for a period equal to that of Improvement Permit – not to exceed sixty months.

Signed: Donna Byrnes date 10/26/06 Installed by: Charles Beatty R.

Improvement Permit by: Marietta Dotson R.S. date 7/14/06 Operation Permit by: Marietta Dotson date 11/9/07

Authorization to Construct by: Judy Melville date 11-29-06 Existing System Inspection by: date

HEALTH DEPT. COPY: WHITE OWNER COPY (FINAL): YELLOW OWNER COPY (INITIAL): PINK