125

IREDELL COUNTY HEALTH DEPARTMENT

STATESVILLE 704-878-5305 MOORESVILLE 704-664-5281

IMPROVEMENT PERMIT / AUTHORIZATION TO CONSTRUCT / OPERATION PERMIT / EXISTING SYSTEM INSPECTION

PERMIT# 078847 PIN# 4639157193 DATE 5/21/99

OWNER OR CONTRACTOR Crescent Resources PHONE: Business 664-1010 Home

ADDRESS P.O. Box 1003 Charlotte NC 28201

LOCATION Perth Rd TL Fern Hill TL Marrietta on left

SUBDIVISION Beaver Point BLOCK / SECTION II LOT 15 LOT AREA SITE CLASS. PS DESIGN FLOW 480gpd L.T.A.R. .3

Septic Tank: 1000 Gallons; STB Date

Pump Tank: 1000 Gallons; PT Date

Pump Make: Model Serial No.

Nitrification Field: No Fields 1 Square Feet 1596' Linear Feet 532'

No Lines 7a+7b' Trench Width 36" Max Trench Bottom Depth 36" Gravel Depth 12"

[X] New System [ ] Repair System Type: I, II, III, IV, V, VI

System Description: Pump (PM) to Conventional

Repair System Description: Same

Maintenance Agreement Required: [ ] Yes [X] No

[X] House/Mod. Home No. Bedrooms 4

[ ] Mobile Home No. Bathrooms 4

[ ] Business No. Employees

[ ] Other


[ ] Slab [X] Crawl Space [ ] Basement w/plumbing [ ] Basement wo/plumbing

Water Supply: [ ] Individual [X] Public [ ] Community


Comments:/Conditions: Keep Septic System at least 10' from PL & 5' from

Comments:/Conditions:

INITIAL SITE SKETCH Scale 1:50'

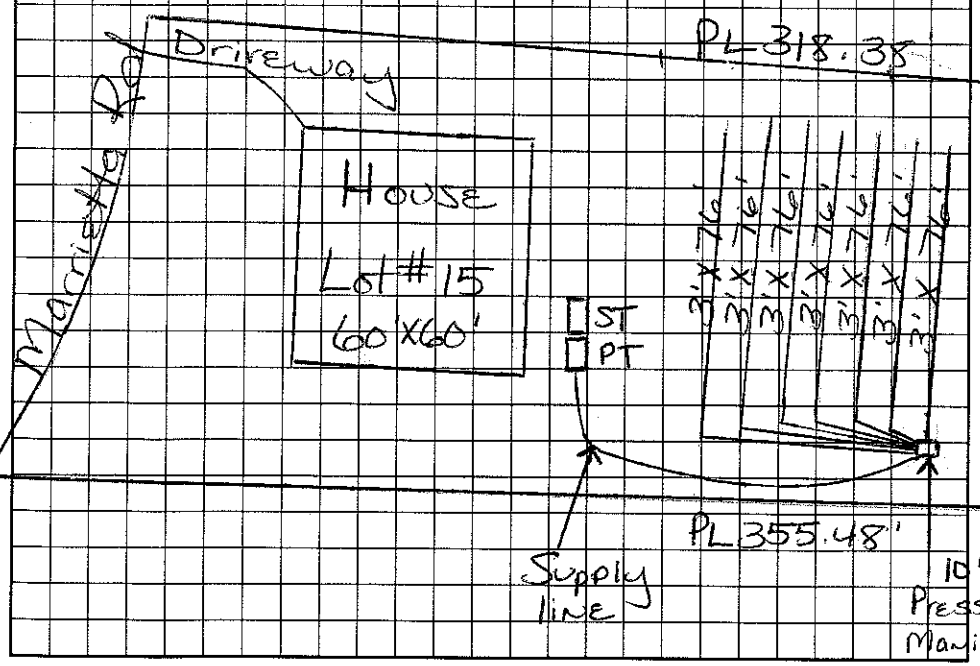

AS BUILT SKETCH

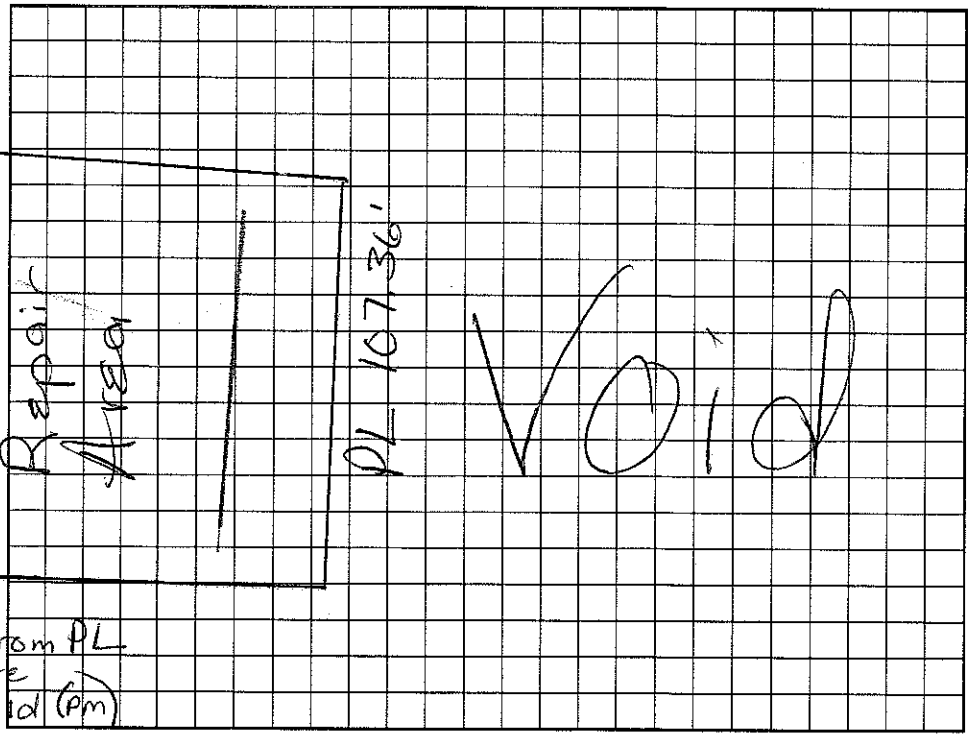

Permit can be suspended or revoked if any false information is supplied toward securing the permit/any unauthorized changes are made to the site/any unauthorized changes are made in the installation of the system. Improvement Permit with plat valid without expiration. Improvement Permit with site plan valid for sixty months. Authorization to Construct is valid for a period equal to that of Improvement Permit – not to exceed sixty months.

Signed: [signature] date 5-25-99 Installed by:

Improvement Permit by: Marina H. Holbrook R.S. date 5/21/99 Operation Permit by: date

Authorization to Construct by: date Existing System Inspection by: date

HEALTH DEPT. COPY: WHITE OWNER COPY (FINAL): YELLOW OWNER COPY (INITIAL): PINK