IREDELL COUNTY HEALTH DEPARTMENT

STATESVILLE 704-878-5305 — MOORESVILLE 704-664-5281

IMPROVEMENT PERMIT / AUTHORIZATION TO CONSTRUCT / OPERATION PERMIT / EXISTING SYSTEM INSP

PERMIT# ~~D-7884~~ 1 116259 PIN# 4639157193 Pager DATE 9/29/03

OWNER OR CONTRACTOR Rick Howell Enterprises Inc PHONE: Business 379-4988 Home

ADDRESS 3544 Amity Hill Rd. Statesville, NC 28625

LOCATION Perth Rd TR Fern Hill TL Marietta on left

SUBDIVISION Beacon Point BLOCK / SECTION II LOT 15 LOT AREA .87 Acre SITE CLASS PS DESIGN FLOW 360gpd L.T.A.R. .3

Septic Tank: 1000 Gallons; STB 312 Date 2/18/04
Pump Tank: Gallons; PT Date
Pump Make: Model Serial No.
Nitrification Field: No Fields 1 Square Feet 900' Linear Feet 300'
No Lines 4@75' Trench Width 36" Max Trench Bottom Depth 36" Gravel Depth N/A

☒ New System ☐ Repair System Type: I, II, III, IV, V, VI
System Description: Gravity-25% Reduction
Repair System Description: Gravity - Innovative
Maintenance Agreement Required: ☐ Yes ☒ No


☒ House/Mod. Home ☐ Mobile Home ☐ Business ☐ Other
No. Bedrooms 3 No. Bathrooms 2½ No. Employees
☐ Slab ☒ Crawl Space ☐ Basement w/plumbing ☐ Basement wo/plumbing

Water Supply: ☐ Individual ☒ Public ☒ Community


Comments/Conditions: Keep Septic System at least 10' from PL
Feather down old berms.

Comments/Conditions:

INITIAL SITE SKETCH Scale 1:50

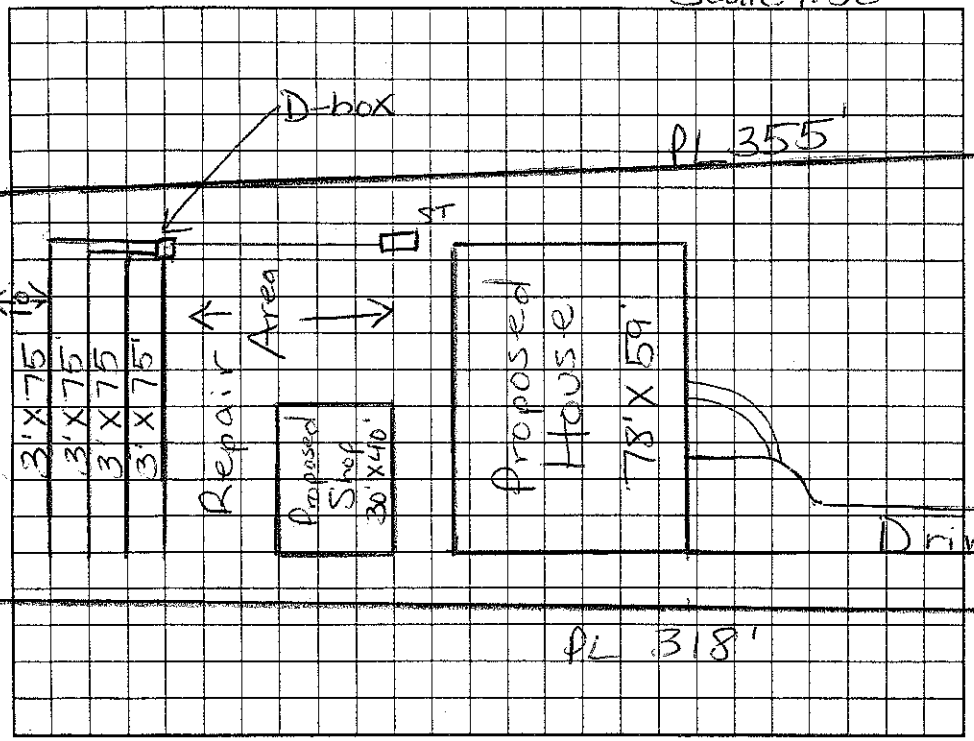

AS BUILT SKETCH

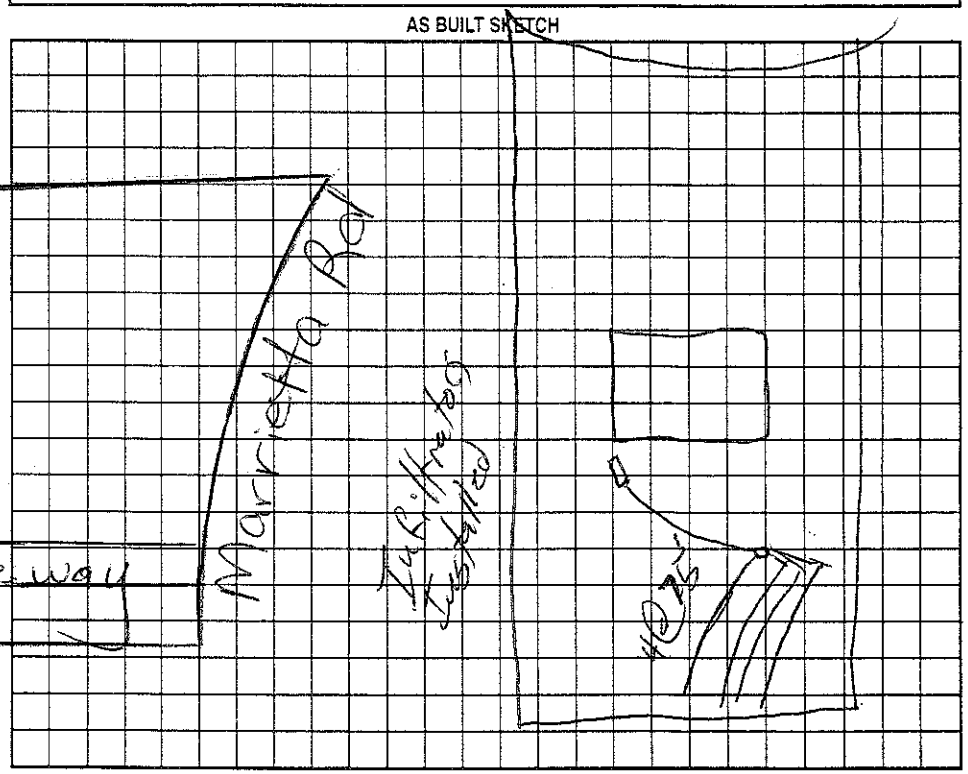

Permit can be suspended or revoked if any false information is supplied toward securing the permit/any unauthorized changes are made to the site/any unauthorized changes are made in the installation of the system. Improvement Permit with plat valid without expiration. Improvement Permit with site plan valid for sixty months. Authorization to Construct is valid for a period equal to that of Improvement Permit – not to exceed sixty months.

Signed: date 9-30-03 Installed by: Levon Benton

Improvement Permit by: Maria H. Dalton R.S. date 9/29/03 Operation Permit by: RS date 3/25/04

Authorization to Construct by: Maria H. Dalton R.S. date 9/29/03 Existing System Inspection by: date

HEALTH DEPT. COPY: WHITE OWNER COPY (FINAL): YELLOW OWNER COPY (INITIAL): PINK