...DELL COUNTY HEALTH DEPARTMENT

STATESVILLE 704-878-5305 MOORESVILLE 704-664-5281

IMPROVEMENT PERMIT / AUTHORIZATION TO CONSTRUCT / OPERATION PERMIT / EXISTING SYSTEM INSPECTI

PERMIT# 078865 PIN# 4639158341 DATE 10-18-99

OWNER OR CONTRACTOR Crescent Resources / Don Forest PHONE: Business 664-1010 Home Don Forest (Mobile) (828) 244-6538

ADDRESS P.O. Box 1003 Charlotte NC 28201

LOCATION Perth Rd TL Fern Hill TR Marietta Rd lot on left

SUBDIVISION Beacon Pt BLOCK / SECTION II LOT 17 LOT AREA .718 Acre SITE CLASS. PS DESIGN FLOW 360gpd L.T.A.R. .3

Septic Tank: 1000 Gallons; STB 1007 Date 12/20/99

Pump Tank: 1000 Gallons; PT 74 Date 12/20/99

Pump Make: HYDROQUIP Model SHEF 50M Serial No. 11/99

Nitrification Field: No Fields 1 Square Feet 900' Linear Feet 300'

No Lines 3 at 100' Trench Width 36" Max Trench Bottom Depth 36" Gravel Depth N/A

[X] New System [ ] Repair System Type: I, II, III, IV, V, VI

System Description: Pump-PM-25% Reduction

Repair System Description: Pump-Panel BLK

Maintenance Agreement Required: [ ] Yes [X] No

[X] House/Mod. Home No. Bedrooms 3

[ ] Mobile Home No. Bathrooms 3

[ ] Business No. Employees ___

[ ] Other ___


[ ] Slab [ ] Crawl Space [X] Basement w/plumbing [ ] Basement wo/plumbing

Water Supply: [ ] Individual [X] Public [X] Community


Comments:/Conditions: Keep Septic System 10' from PL (Supply lines 5' from PL) & Drainfield 25' from Basement wall. Ok to install 4-75' lines instead of 3-100

Comments:/Conditions: Replaces permit issued 5/22/99 Final grading not completed at time of inspection. JMD

INITIAL SITE SKETCH Scale 1:50

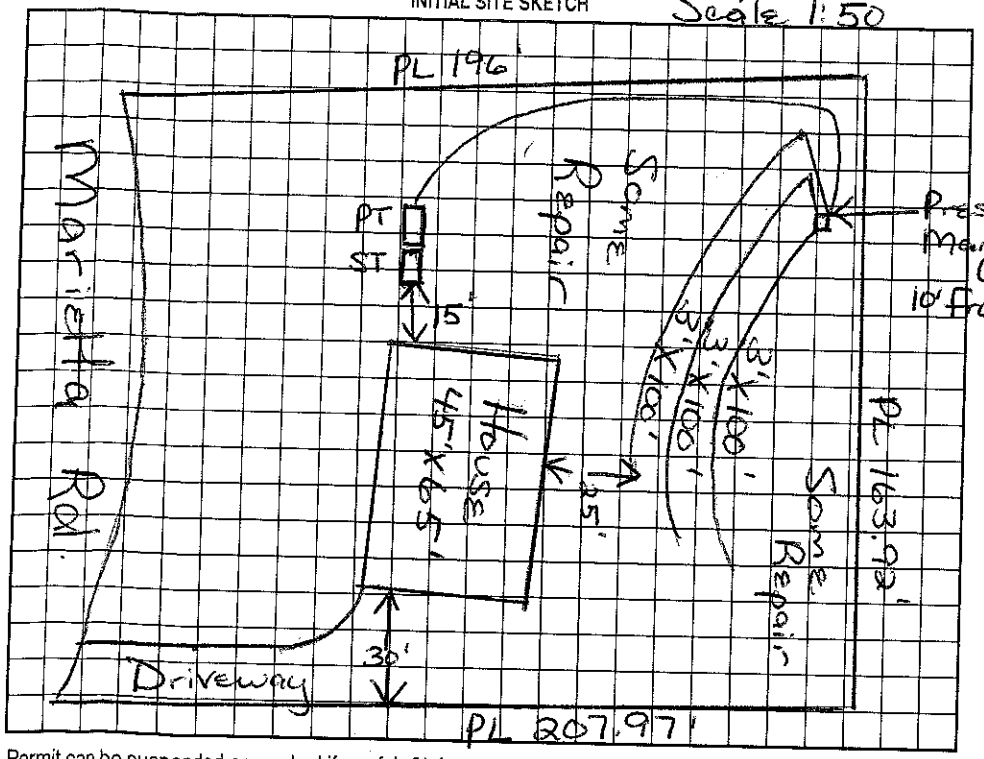

AS BUILT SKETCH

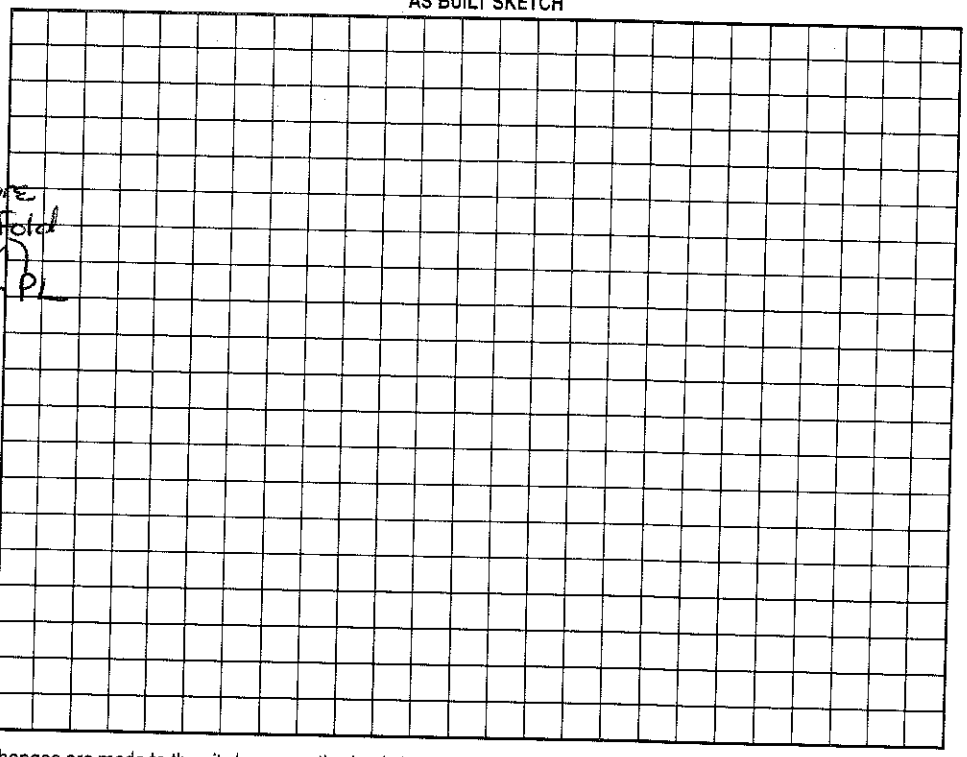

Permit can be suspended or revoked if any false information is supplied toward securing the permit/any unauthorized changes are made to the site/any unauthorized changes are made in the installation of the system. Improvement Permit with plat valid without expiration. Improvement Permit with site plan valid for sixty months. Authorization to Construct is valid for a period equal to that of Improvement Permit – not to exceed sixty months.

Signed: X _____ date _____

Improvement Permit by: Maria H. Dotson RS. date 10/18/99

...ion to Construct by: Maria H. Dotson RS date 10/18/99

Installed by: James Hudler

Operation Permit by: Maria H. Dotson RS date 6/9/2000

Existing System Inspection by: _____ date _____

HEALTH DEPT. COPY: WHITE OWNER COPY (FINAL): YELLOW OWNER COPY (INITIAL): PINK

Redraw $50.00 Pd 10/18/99