IREDELL COUNTY HEALTH DEPARTMENT

STATESVILLE 704-878-5305 MOORESVILLE 704-664-5281

IMPROVEMENT PERMIT / AUTHORIZATION TO CONSTRUCT / OPERATION PERMIT / EXISTING SYSTEM INSPECTION

PERMIT# Repair PIN# 4639158653 DATE 3-7-03

OWNER OR CONTRACTOR Bill Ferdon PHONE: Business 902-1348 Home

ADDRESS 280 Marietta Mooresville NC 28117

LOCATION Perth Rd N TL Fern Hill TR Marie

SUBDIVISION CLR T BLOCK / SECTION 16 LOT 35 LOT AREA SITE CLASS. #5 DESIGN FLOW 360 gpd L.T.A.R.

Septic Tank: Existing Gallons; STB Date

Pump Tank: Gallons; PT Date

Pump Make: Model Serial No.

Nitrification Field: No Fields 1 Square Feet 300' Linear Feet 100'

No Lines 2@50' Trench Width 36" Max Trench Bottom Depth 36" Gravel Depth

☐ New System ☒ Repair System Type: I, II, (III), IV, V, VI

System Description: Gravity-Conventional

Repair System Description: Gravity - 25% Reduction

Maintenance Agreement Required: ☐ Yes ☒ No

☒ House/Mod. Home No. Bedrooms 3

☐ Mobile Home No. Bathrooms 2

☐ Business No. Employees

☐ Other


☐ Slab ☐ Crawl Space ☒ Basement w/plumbing ☐ Basement wo/plumbing

Water Supply: ☒ Individual ☐ Public ☐ Community

Comments:/Conditions:


Marietta Rd *Not to Scale

INITIAL SITE SKETCH

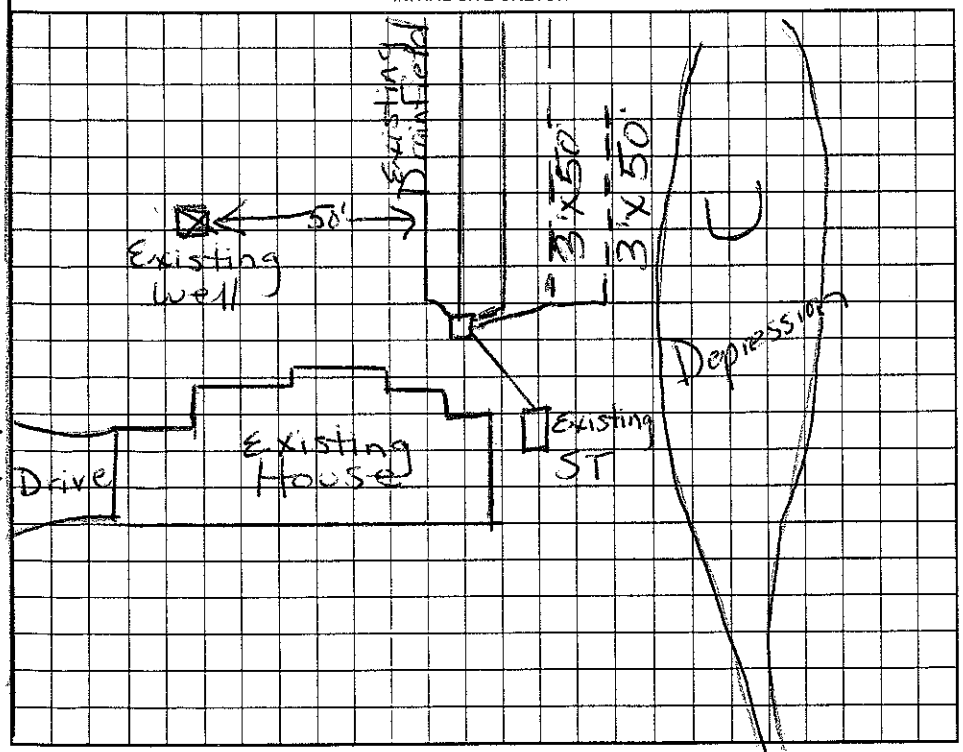

Comments:/Conditions: Feeding old system 1st then new lines get overflow System was backing up prior to repair

AS BUILT SKETCH

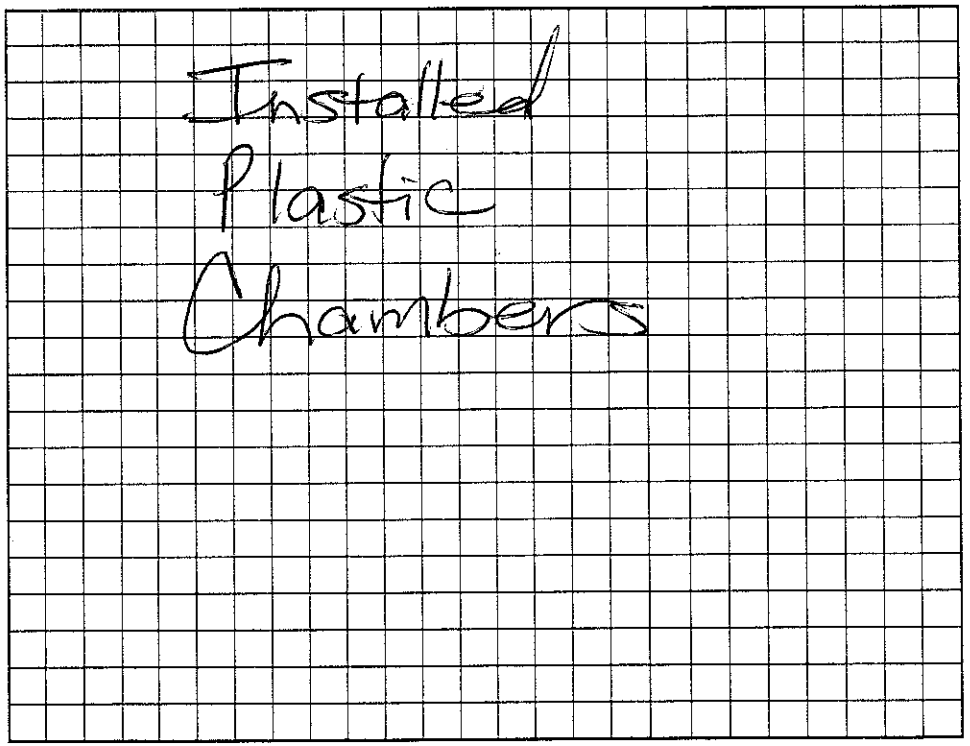

Permit can be suspended or revoked if any false information is supplied toward securing the permit/any unauthorized changes are made to the site/any unauthorized changes are made in the installation of the system. Improvement Permit with plat valid without expiration. Improvement Permit with site plan valid for sixty months. Authorization to Construct is valid for a period equal to that of Improvement Permit – not to exceed sixty months.

Signed: X W Ferdon date

Improvement Permit by: Maria H. Dolan RS date 3/7/03

Authorization to Construct by: Maria H. Dolan RS date 3/7/03

Repair

Installed by: Rowan Septic RS

Repair

Operation Permit by: Maria H. Dolan RS date 3/7/2003

Existing System Inspection by: date

HEALTH DEPT. COPY: WHITE OWNER COPY (FINAL): YELLOW OWNER COPY (INITIAL): PINK

IREDELL COUNTY HEALTH DEPARTMENT

STATESVILLE 704-878-5305 II MOORESVILLE 704-664-5281

IMPROVEMENT PERMIT / CERTIFICATE OF COMPLETION / OPERATION PERMIT / EXISTING SYSTEM INSPECTION

PROPERTY DESCRIPTION NO. 15867 DATE 7/22/93 TAX MAP NO. 3C 1A 35

OWNER OR CONTRACTOR WM. FERBON PHONE: Business _____ Home _____

ADDRESS MARIETTA RD. MOORESVILLE, NC.

LOCATION MARIETTA RD - FERNHILL ©FF PERTH, TR ON MARIETTA ~ .6 MILE ON (R), (L) OF GRAVEL DRIVE

SUBDIVISION C L + T BLOCK / SECTION 16 LOT 35 LOT AREA ~ 20,000 FT² SITE CLASS. P L.T.A.R. EXISTING

Water Supply: ☑ Individual ☐ Community ☐ Public

Septic Tank: 1000 Gallons; STB 1012 Date 5-9-93

Pump Tank: _____ Gallons; PT _____ Date _____

Nitrification Field: No Fields 1 Square Feet EXISTING Linear Feet _____

No Lines _____ Trench Width _____ Trench Depth _____ Gravel Depth _____

☐ New System ☐ Repair System Type: I, II, II, IV, V, VI

System Description: _____

Repair System Description: PRESS-PANEL

Maintenance Agreement Required: ☐ Yes ☐ No

☑ House/Mod. Home No. Bedrooms 3 Garbage Disposal: ☐ Yes ☑ No

☐ Mobile Home No. Bathrooms 2 Auto. Dishwasher: ☑ Yes ☐ No

☐ Business No. Employees _____ Auto. Washing Machine: ☑ Yes ☐ No


☐ Other _____ Other _____

☐ Slab ☐ Crawl Space ☑ Basement w/plumbing ☐ Basement wo/plumbing

Comments _____

INITIAL SITE SKETCH

AS-BUILT SKETCH

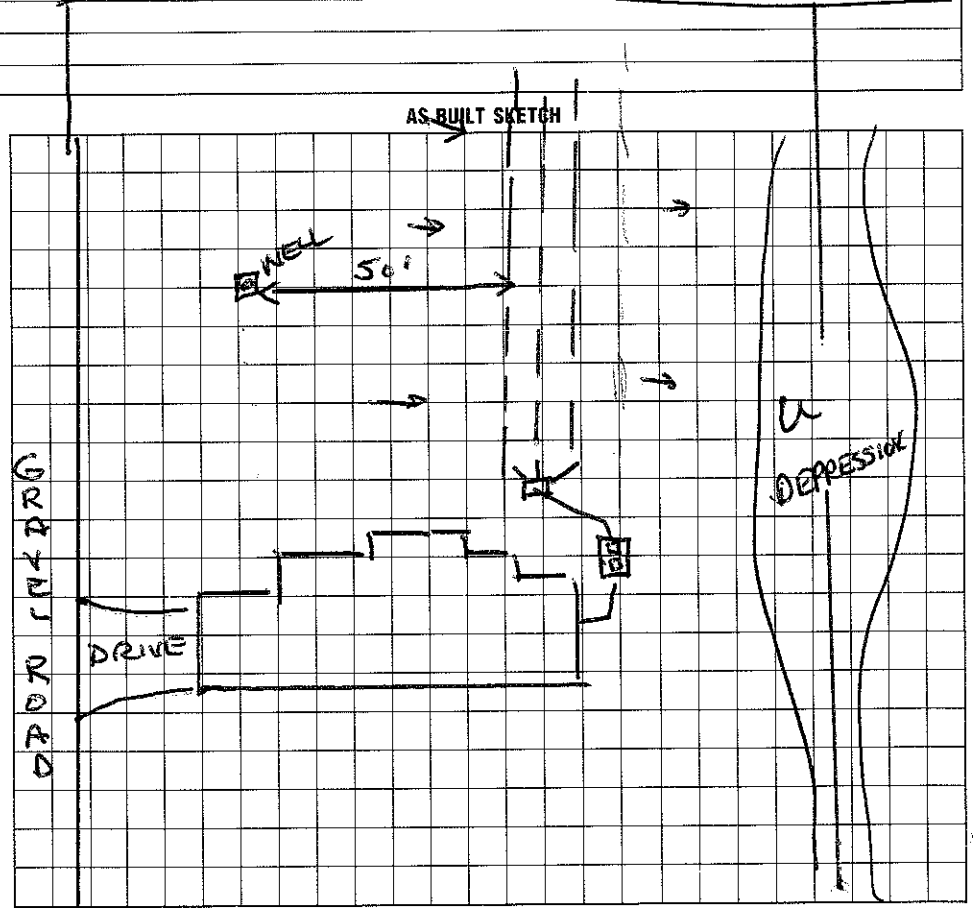

I understand that this permit can be suspended or revoked if any false information is supplied toward securing the permit/any unauthorized changes are made to the site/any unauthorized changes are made in the installation of the system. Improvement Permit is valid for 60 months from date of issuance.

Signed: _____

Improvement Permit by: _____ date _____

Existing System Inspection by: _____ date _____

Installed by: JAMES HUDLER

Certificate of Completion by: Wesley Sparks RS date 7/22/93

Operation Permit by: _____ date _____

HEALTH DEPT. COPY: WHITE INSPECTION COPY (FINAL): GREEN OWNER COPY (FINAL): YELLOW INSPECTION COPY (INITIAL): PINK OWNER COPY (INITIAL): GOLD