IREDELL COUNTY HEALTH DEPARTMENT

STATESVILLE 704-878-5305 MOORESVILLE 704-664-5281

IMPROVEMENT PERMIT / AUTHORIZATION TO CONSTRUCT / OPERATION PERMIT / EXISTING SYSTEM INSPECTION

4130

PERMIT# 12844 PIN# 4639159398 Ted Braun (Summerwood) DATE 6-1-05

OWNER OR CONTRACTOR Charles Huffman (Summerwood) PHONE: Business 507-1245 Home 571-334-9888

ADDRESS 12312 Running Deer Rd. Manassas, VA 20112

LOCATION Perth Rd North TL Fern Hill TR Marietta lot on left

SUBDIVISION Beacon Pt. BLOCK / SECTION II LOT 18 LOT AREA 1.34 Acre SITE CLASS. PS DESIGN FLOW 480gpd L.T.A.R. .4

Septic Tank: 1000 Gallons; STB 1007 Date 12/3/05

Pump Tank: 1000 Gallons; PT 274 Date 12/6/05

Pump Make: ZOELLER Model N-153 A Serial No.

Nitrification Field: No Fields 1 Square Feet 1200' Linear Feet 400'

No Lines 4 @ 100' Trench Width 36" Max Trench Bottom Depth 36" Gravel Depth 12"

[X] New System [ ] Repair System Type: I, II, III, IV, V, VI

System Description: Pump - Conventional

Repair System Description: Pump - 25% Reduction

Maintenance Agreement Required: [ ] Yes [X] No

[X] House/Mod. Home [ ] Mobile Home [ ] Business [ ] Other

No. Bedrooms 4 No. Bathrooms 3 No. Employees

[ ] Slab [X] Crawl Space [ ] Basement w/plumbing [ ] Basement wo/plumbing


Water Supply: [ ] Individual [X] Public [X] Community

Comments:/Conditions:


Comments:/Conditions: -SF W/ MARKER AND CABLE RISER INSTALLED WITH 73 QUICK-4 CHAMBERS.

INITIAL SITE SKETCH

Scale 1:50

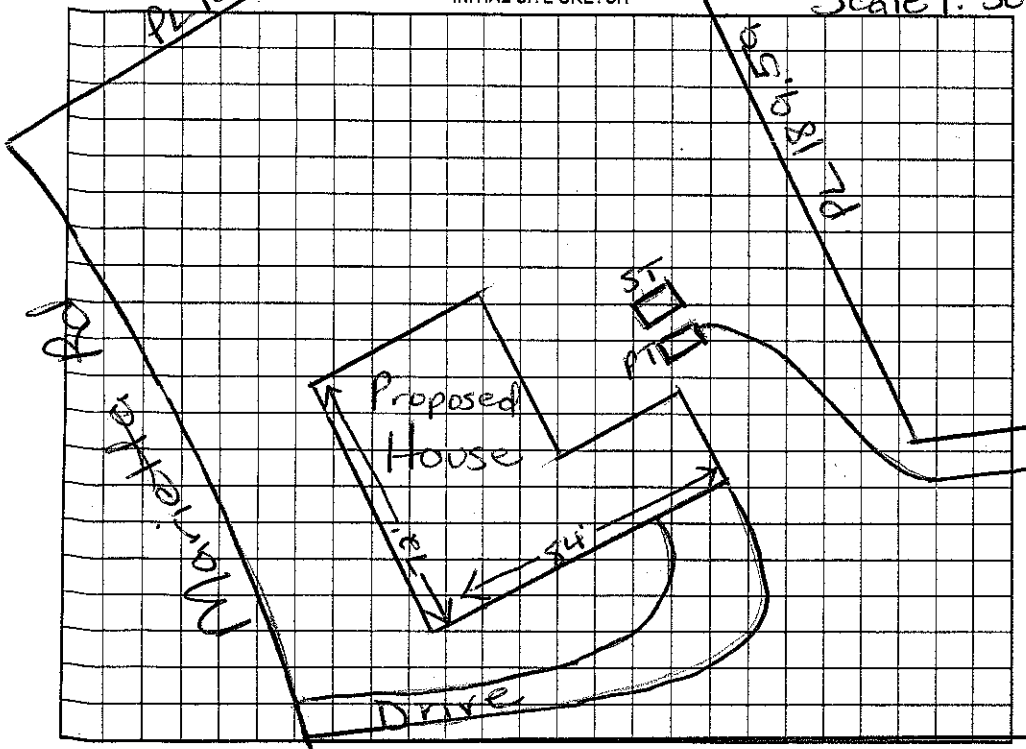

AS BUILT SKETCH

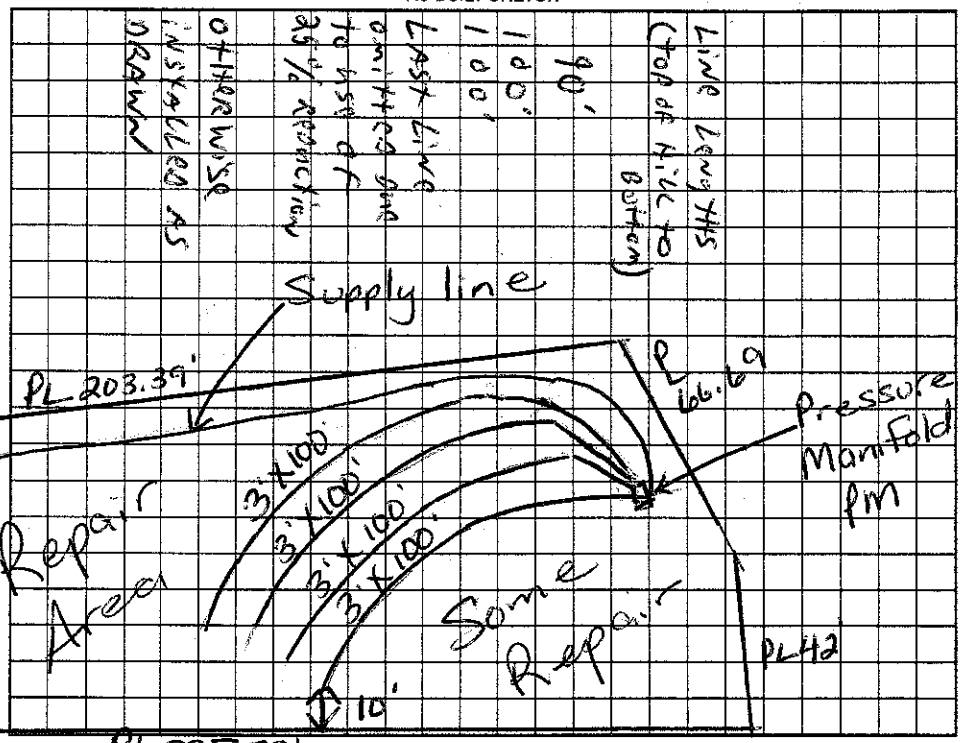

Permit can be suspended or revoked if any false information is supplied toward securing the permit/any unauthorized changes are made to the site/any unauthorized changes are made in the installation of the system. Improvement Permit with plat valid without expiration. Improvement Permit with site plan valid for sixty months. Authorization to Construct is valid for a period equal to that of Improvement Permit – not to exceed sixty months.

Signed: Ted B date 6/3/05 Installed by: Derek Barnes, Backhoe Svcs.

Improvement Permit by: Maria H. Dobson RS date 6/1/05 Operation Permit by: Wesley Sparks R.S. date 3/29/06

Authorization to Construct by: Maria H. Dobson RS date 6/1/05 Existing System Inspection by: date

HEALTH DEPT. COPY: WHITE OWNER COPY (FINAL): YELLOW OWNER COPY (INITIAL): PINK