4639-15-9836 3-16 Lot 38

IREDELL COUNTY HEALTH DEPARTMENT

STATESVILLE 704-878-5305 MOORESVILLE 704-664-5281

IMPROVEMENT PERMIT / CERTIFICATE OF COMPLETION / OPERATION PERMIT / EXISTING SYSTEM INSPECTION

PROPERTY DESCRIPTION NO. 17193 DATE 12/15/93 TAX MAP NO. 3C 1A 38C Watershed: ☑ Yes ☐ No

OWNER OR CONTRACTOR MICHAEL STONER PHONE: Business _____ Home 664-4513 528-4172

ADDRESS Rt 3 Box 602 TROUTMAN, NC.

LOCATION MARIETTA RD (R) OFF FERNHILL (W) ~.9 MILE FROM MERRIMAC TO LOT 941 (R) OFF CHALET AC

SUBDIVISION C L & T BLOCK / SECTION 16 38 94 10 35 LOT AREA ~.64 AC SITE CLASS. D DESIGN FLOW 360 L.T.A.R. .3

Septic Tank: 1000 Gallons; STB RST 825 Date 3-17-95

Pump Tank: 1000 Gallons; PT RST 47 Date 3-17-95

Pump Make: _____ Model _____ Serial No. _____

Nitrification Field: No Fields 1 Square Feet 1200 Linear Feet 400

No Lines _____ Trench Width 3' Max Trench Bottom Depth 30" Gravel Depth 12"

☑ New System ☐ Repair System Type: I, II, (III) IV, V, VI

System Description: CONV. W/ PRES. MANIFOLD

Repair System Description: CONV.

Maintenance Agreement Required: ☐ Yes ☐ No

☑ House/Mod. Home No. Bedrooms 3

☐ Mobile Home No. Bathrooms 2

☐ Business No. Employees _____

☐ Other _____

☐ Slab ☐ Crawl Space ☑ Basement w/plumbing ☐ Basement wo/plumbing


Water Supply: ☑ Individual ☐ Community ☐ Public

Comments:


Trenches no deeper than 30" to trench bottom.
On contour in direction shown.

Comments: 4@75' INFILTRATOR LATERALS INSTALLED 6-1-95 DHH

INITIAL SITE SKETCH / DRAINFIELD

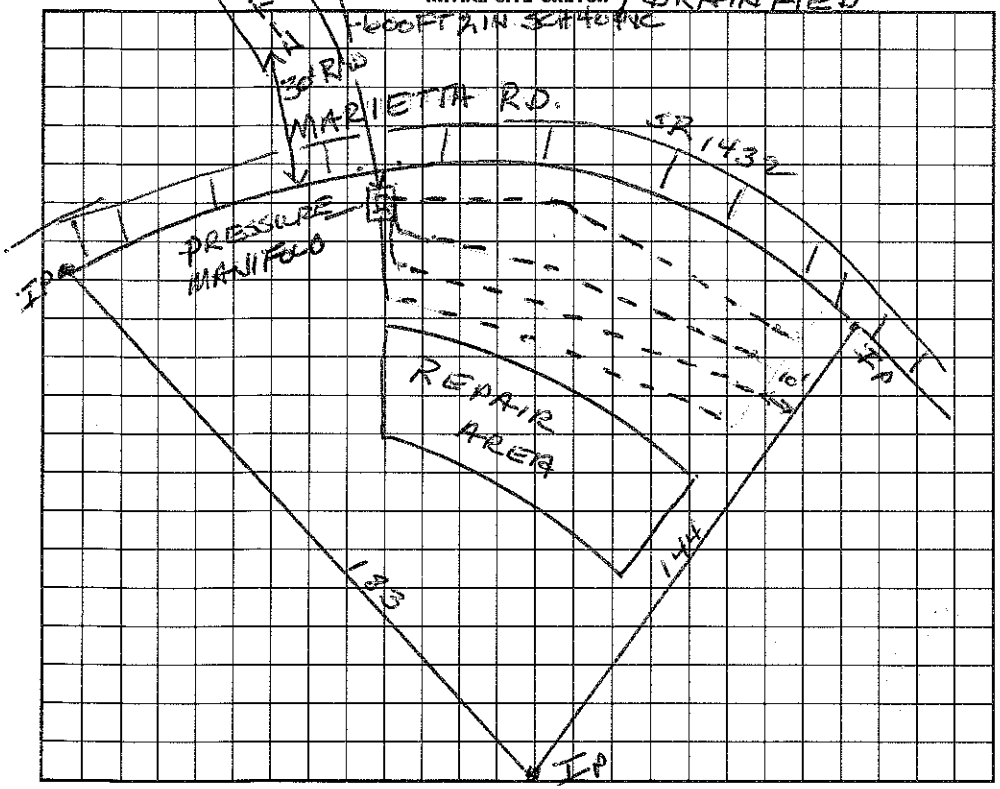

AS BUILT SKETCH HOUSE SITE

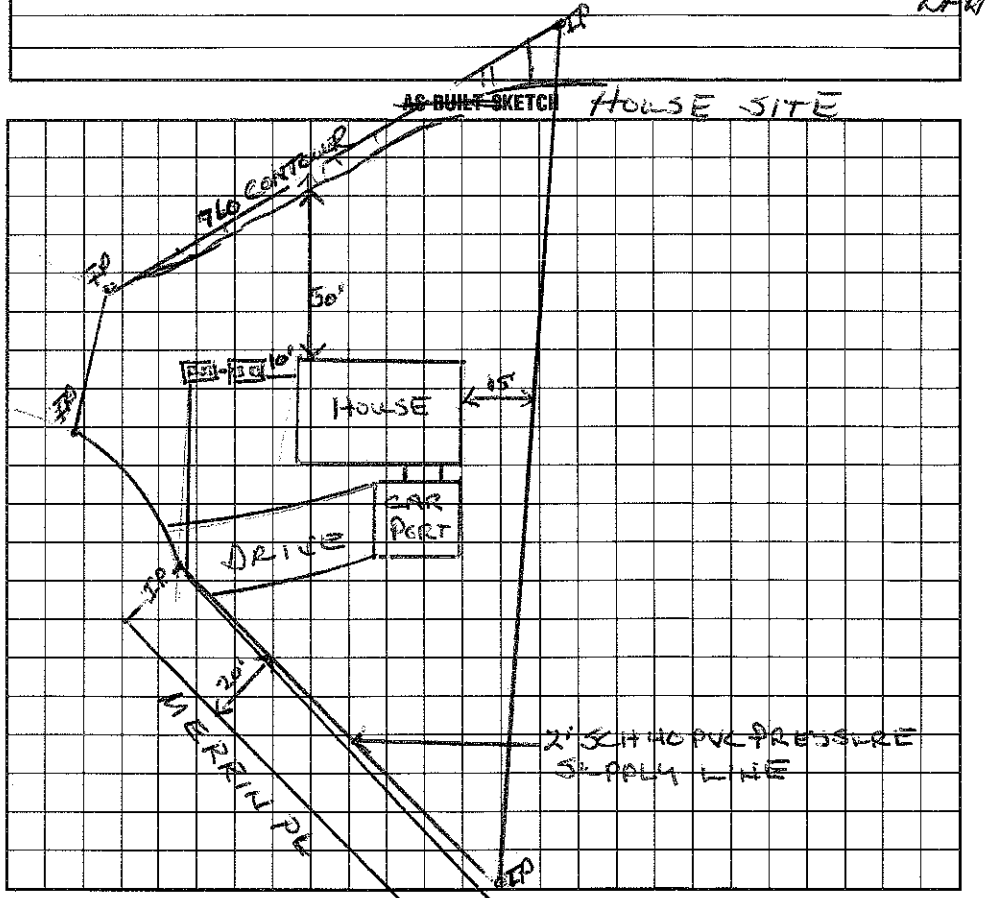

I understand that this permit can be suspended or revoked if any false information is supplied toward securing the permit/any unauthorized changes are made to the site/any unauthorized changes are made in the installation of the system. Improvement Permit is valid for 60 months from date of issuance.

Signed: _____

Improvement Permit by: Wesley Sparks RS date 12/15/93

Existing System Inspection by: _____ date _____

Installed by: Wayne County.

Certificate of Completion by: _____ date _____

Operation Permit by: Wesley Sparks RS.

HEALTH DEPT. COPY: WHITE INSPECTION COPY (FINAL): GREEN OWNER COPY (FINAL): YELLOW INSPECTION COPY (INITIAL): PINK OWNER COPY