IREDELL COUNTY HEALTH DEPARTMENT

STATESVILLE 704-878-5305 130.00 Paid CI MOORESVILLE 704-664-5281

IMPROVEMENT PERMIT / AUTHORIZATION TO CONSTRUCT / OPERATION PERMIT / EXISTING SYSTEM INSPECTION

PERMIT# 126837 PIN# 4639173464 Bob Newman DATE 4-19-05

OWNER OR CONTRACTOR Freddy Willis PHONE: Business 336 922-4101 Home 516-6869

ADDRESS 2073 Pembrook Forest Winston Salem, NC 27106

LOCATION Perth Rd TR State Park Rd TL Morrison Farm Rd TL Apache on right

SUBDIVISION C/A T BLOCK / SECTION 18 LOT 48 LOT AREA .610 Acre SITE CLASS. PS DESIGN FLOW 360 gpd L.T.A.R. .3

Septic Tank: 1000 Gallons; STB 794 Date 10-23-05
Pump Tank: 1000 Gallons; PT 283 Date 10-12-05
Pump Make: Little Giant Model 9EH Serial No. 4110 HD
Nitrification Field: No Fields 1 Square Feet 400' Linear Feet 200'
No Lines 4 @ 50' Trench Width 24" Max Trench Bottom Depth 30" Gravel Depth N/A

☒ New System ☐ Repair System Type: I, II, III, IV, V, VI
System Description: Pump-PM-Panel Block
Repair System Description: * Partial-Panel Blk
Maintenance Agreement Required: ☐ Yes ☒ No

☒ House/Mod. Home No. Bedrooms 3
☐ Mobile Home No. Bathrooms 3
☐ Business No. Employees
☐ Other
☐ Slab ☐ Crawl Space ☒ Basement w/plumbing ☐ Basement wo/plumbing


Water Supply: ☒ Individual ☐ Public ☐ Community

Comments:/Conditions: Must keep Septic System at least 10' to PL & 50' to well; Tanks > 50' to Lake.

Comments:/Conditions: * Lot in existance prior to 1982
- POLYLOK Filter & MARKER
- BUILDER REQUEST 3' WIDE DITCHES 9' ON CENTER & TANK CHANGES


Scale 1:50

INITIAL SITE SKETCH

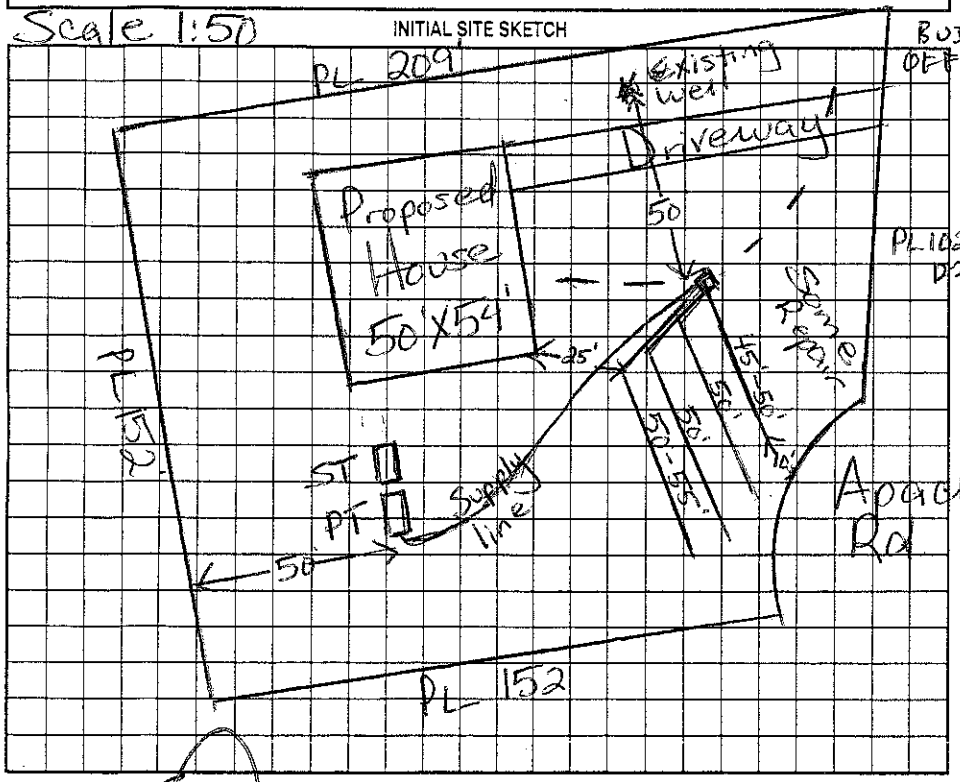

AS BUILT SKETCH

BUILDER SAID P/L 15' OFF PAVEMENT; SEPTIC 25' TO FOR PROPERTY

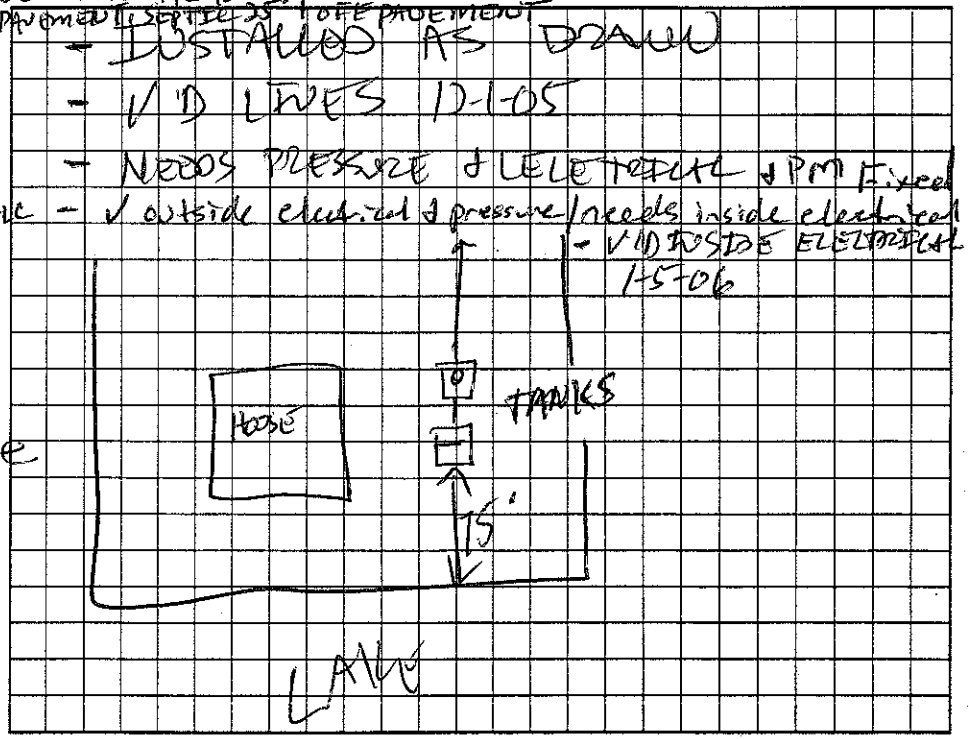

Permit can be suspended or revoked if any false information is supplied toward securing the permit/any unauthorized changes are made to the site/any unauthorized changes are made in the installation of the system. Improvement Permit with plat valid without expiration. Improvement Permit with site plan valid for sixty months. Authorization to Construct is valid for a period equal to that of Improvement Permit – not to exceed sixty months.

Signed: _____ date 4/19/05 Installed by: RICHARD ASHWORTH

Improvement Permit by: Maria H. Dotson RS date 4/19/05 Operation Permit by: _____ date 1-5-06

Authorization to Construct by: Maria H. Dotson RS date 4/19/05 Existing System Inspection by: _____ date _____

HEALTH DEPT. COPY: WHITE OWNER COPY (FINAL): YELLOW OWNER COPY (INITIAL): PINK