IMPROVEMENT PERMIT / AUTHORIZATION TO CONSTRUCT / OPERATION PERMIT / EXISTING SYSTEM INSPECTION

PERMIT # RELOCATION PIN # 4639-17-4207 DATE JUNE 10, 2011

OWNER CONSTANCE T. BARKER APPLICANT: SAME PHONE: Home/Cell # 704-528-9551 Business #

SITE ADDRESS 258 APACHE ROAD, TROUTMAN, NC OWNER / APPLICANT ADDRESS SAME

SITE DIRECTIONS STATE PARK ROAD, TO MORRISON FARM ROAD, TL APACHE ROAD LOT ~~AT~~ END ON RIGHT

SUBDIVISION CL & T BLOCK / SECTION 18 LOT # 49 LOT AREA 0.75 ACRE DESIGN FLOW 480 L.T.A.R. 0.30 GPD/FT

REQUIRE 1000

Septic Tank 1000 Gallons: STB 347 Date 6-23-11

Pump Tank 1000 Gallons: PT 365 Date 2-7

Pump Make ____ Model ____ Serial # ____

No. Nitrification Fields: 1 No. Lines 4 Linear Feet ____

Trench Width 36" Max. Trench Bottom Depth 36 Actual Depth 24"

☑ New System ☐ Repair ☐ Expansion System Type I II III IV (V)

System Description: PRETREATMENT 50% RED, LOW-PRES

Repair System Description: PRETREATMENT 50% RED, LOW-PRES

Maintenance Agreement Required ☑ YES ☐ NO

☐ GRAVITY ☑ PRESSURE GS-II

☐ Residence No. Bedrooms 4

☐ Business No. Persons ____

☐ Other No. Employees ____

☐ Slab ☑ Crawl Space


☐ Basement w/plumbing ☐ Basement w/o plumbing

Water Supply: ☑ Private WELL ☐ Public ☐ Community

Comments / Conditions: (2) SEE ATTACHED PLAN PREPARED BY JACOBS ON-SITE DEVELOPMENT, INC & AQUA. (1) KEEP SYSTEM MINIMUM 100' FROM WELL (15A NCAC 18A .1956 (6)(3))

(3) A CONTRACT SHALL BE EXECUTED BETWEEN SYSTEM OWNER & A MANAGEMENT ENTITY PRIOR TO ISSUANCE OF OPERATION PERMIT.

INITIAL SITE SKETCH

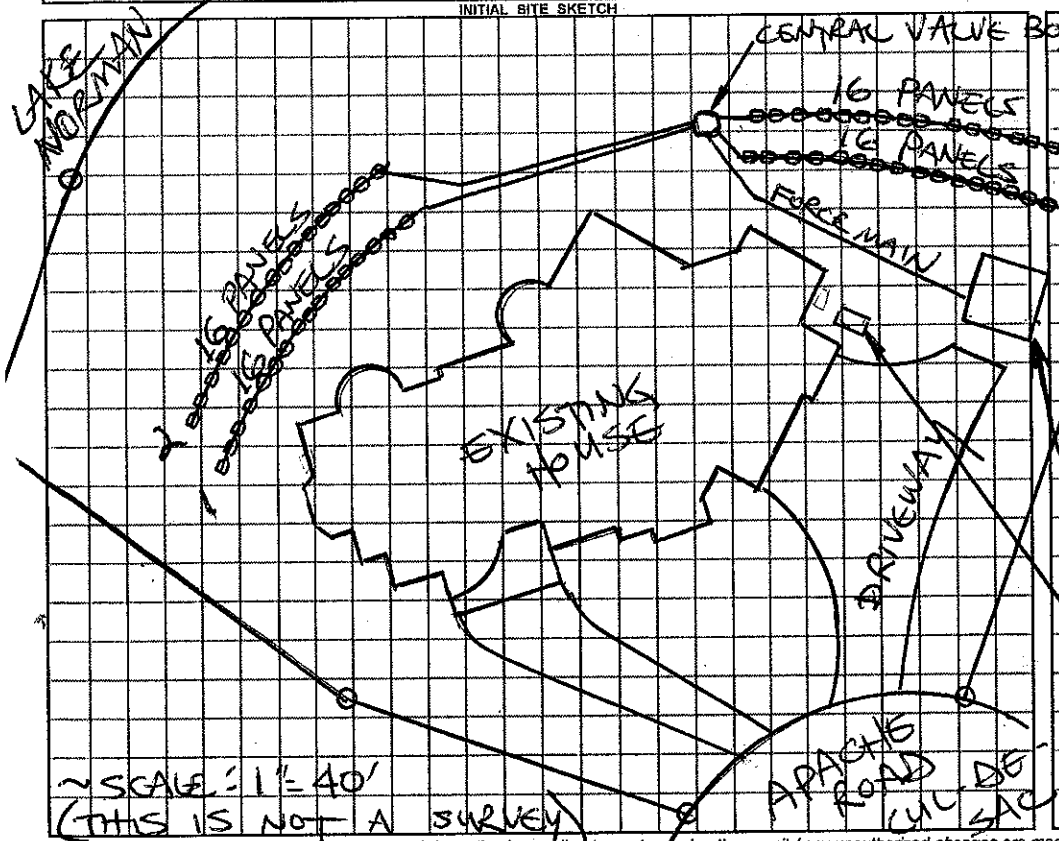

AS BUILT SKETCH

L-1 A-1 C.K. 6-16-11 TCH

6-22-11 TCH

	Date	Initials
Drain Lines Checked	[illegible]	[illegible]
Tanks Checked	15 June 11	TCH
Pressure Manifold or Valve Box Checked	29 June 11	TCH
Pressure Head Set	29 June 11	TCH
Electrical Checked	29 June 11	TCH
Floats Set	29 June 11	TCH
Alarm Checked	29 June 11	TCH
Maintenance Contract (Y) N	6 July 11	TCH

Permit can be suspended or revoked if any false information is supplied toward securing the permit / any unauthorized changes are made to the site / any unauthorized changes are made in the installation of the system.

☐ *IMPROVEMENT PERMIT with plat valid without expiration* ☑ *IMPROVEMENT PERMIT with plat valid without expiration. site plan valid 60 mo.* ☑ *AUTHORIZATION TO CONSTRUCT* valid for period equal to IMPROVEMENT PERMIT--not to exceed 60 mo.

Owner / Applicant Signature: [signature] Date 6/16/11 Installed by: Stanley Environmental

IMPROVEMENT PERMIT by: R. STRUE HEDRICK REHS Date 6-10-2011 OPERATION PERMIT by: [signature] REHS Date 6 July 11

AUTHORIZATION TO CONSTRUCT by: [signature] REHS Date 6-16-2011 Existing System Inspected by: [signature] REHS Date [illegible]

YOU SHOULD CONTACT A LOCATOR SERVICE PRIOR TO ANY EXCAVATION

White Copy – Environmental Health YELLOW COPY (Final) Owner / Applicant PINK COPY (Initial) Owner / Applicant