IREDELL COUNTY HEALTH DEPARTMENT

STATESVILLE 704-878-5305 MOORESVILLE 704-664-5281

IMPROVEMENT PERMIT / CERTIFICATE OF COMPLETION / OPERATION PERMIT / EXISTING SYSTEM INSPECTION

PROPERTY DESCRIPTION NO. 18749 DATE 7-22-94 TAX MAP NO. 3C-7-A-50 Watershed: ☐ Yes ☑ No

OWNER OR CONTRACTOR Aaron Ball PHONE: Business _____ Home 628-1037

ADDRESS 15 Mountainview Lane, Fletcher, N.C. 28732

LOCATION From Troutman take Perth Rd. TR State Park Rd TL Morrison Farm Rd TL Apache Lane Lot at end.

SUBDIVISION Crescent BLOCK / SECTION 19 LOT 50 LOT AREA .621 acre SITE CLASS. P.S. DESIGN FLOW 360 L.T.A.R. .13 gpd/ft²

Septic Tank: Existing Gallons; STB _____ Date _____

Pump Tank: - Gallons; PT - Date -

Pump Make: - Model - Serial No. -

Nitrification Field: No Fields 2 Square Feet 402 Linear Feet 134

No Lines 2 Trench Width 36" Max Trench Bottom Depth 36" Gravel Depth 12"

☐ New System ☑ Repair System Type: I, II, III, IV, V, VI

System Description: Conventional, gravity fed.

Repair System Description: _____

Maintenance Agreement Required: ☐ Yes ☑ No

☐ House/Mod Home No. Bedrooms 3

☐ Mobile Home No. Bathrooms 2

☐ Business No. Employees ____

☐ Other _____


☐ Slab ☑ Crawl Space ☐ Basement w/plumbing ☐ Basement wo/plumbing

Water Supply: ☑ Individual ☐ Community ☐ Public

Comments: Moving off 2 Bedroom House. Moving on 3 Bedroom House. Use existing septic tank with installation of 2 drop boxes with (2) 67' lines. Then feed into existing drain field. Keep repair 6' from existing system, 10' from all Property lines, 50' from Well, and 50' from 760' elevation mark. Keep house min. 5' from any part of septic system both existing and additional lines.

Comments: Septic Tank contractor said line between tank and existing lines were clogged. Installed new line to D-box. Install new tee into tank. Fed new lines first due to not knowing if old lines will back up.

INITIAL SITE SKETCH

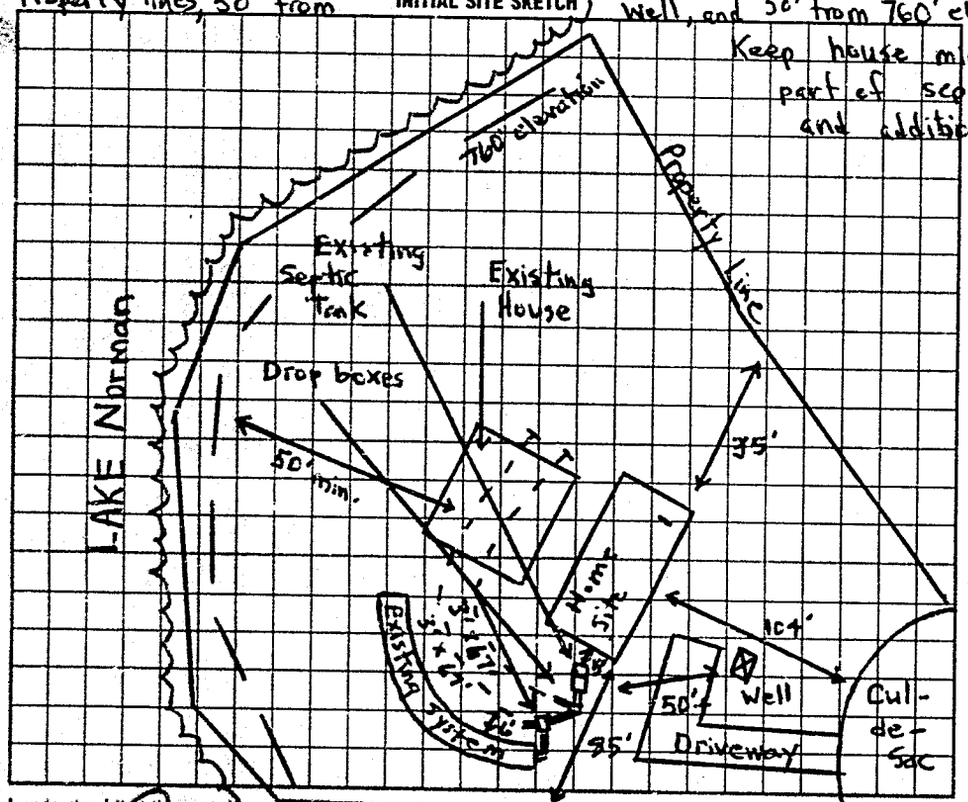

AS BUILT SKETCH

SAME AS INITIAL SKETCH

I understand that this permit can be suspended or revoked if any false information is supplied toward securing the permit/any unauthorized changes are made to the site/any unauthorized changes are made in the installation of the system. Improvement Permit is valid for 60 months from date of issuance.

Signed: Aaron Ball

Improvement Permit by: Michael J. Dennis date 7-22-94

Existing System Inspection by: _____ date _____

Installed by: James Hudler

Certificate of Completion by: Michael J. Dennis date 9-8-94

Operation Permit by: _____ date _____

HEALTH DEPT. COPY WHITE INSPECTION COPY (FINAL) GREEN OWNER COPY (FINAL) YELLOW INSPECTION COPY (INITIAL) PINK OWNER COPY (INITIAL): GOLD