UELL COUNTY HEALTH DEPARTMENT

Statesville Office (704) 878-5305 Mooresville Office (704) 660-3625 PERMIT # 200090 176485

ROVEMENT PERMIT / AUTHORIZATION TO CONSTRUCT / OPERATION PERMIT / EXISTING SYSTEM

PIN # 4639-09-4818.000 (4639.15.4818)

APPLICANT: TONEY JACOBS APPLICANT ADDRESS: 168 BROADBILL DRIVE MOORESVILLE NC 28117

SITE ADDRESS: PHONE: 704-663-6905 ALT. PHONE: 704-483-6033

SITE DIRECTIONS: STATE PARK ROAD TO MORRISON FARM ROAD, TL APACHE ROAD, LOT 14 ON RIGHT


SUBDIVISION: TWIN COVES @ MORRISON SECTION: LOT # 14 LOT AREA: 3.0 ACRES DESIGN FLOW: 480 L.T.A.R.: 0.30 gpd/ft

Septic Tank	1500 (gal)	STB	390	Date	10-15-13	☑ New System ☐ Repair ☐ Expansion	System Type: I II (III) IV V VI	☑ Residence	No. Bedrooms 4
Pump Tank	1500 (gal)	PT	353	Date	11-30-13	System Description: 25% REDUCTION PUMP		☐ Business	No. Persons
Pump Make		Model		Serial #		Repair System Description: 25% REDUCTION PUMP		☐ Other	No. Employees
# Nitrification Fields	1	# Lines	THREE	Linear Ft:	400	Maintenance Agreement Required: ☐ YES ☑ NO		☐ Slab	☐ Crawl Space
Trench Width	36"	Max. Trench Bottom Depth	36"	Gravel Depth	N/A	☐ GRAVITY ☑ PRESSURE		☑ Basement w/plumbing	☐ Basement w/o plumbing


Water Supply: ☑ Private ☐ Public ☐ Community

Comments / Conditions: ① REMOVE EXISTING FIELD TERRACES IN AREA of DRAINFIELD ② INSTALL 25% REDUCTION SYSTEM ON CONTOUR ③ SEE ATTACHED "FAST TRACK" SITE PLAN & PUMP SPECIFICATIONS PREPARED BY TONEY JACOBS.

INITIAL SITE SKETCH

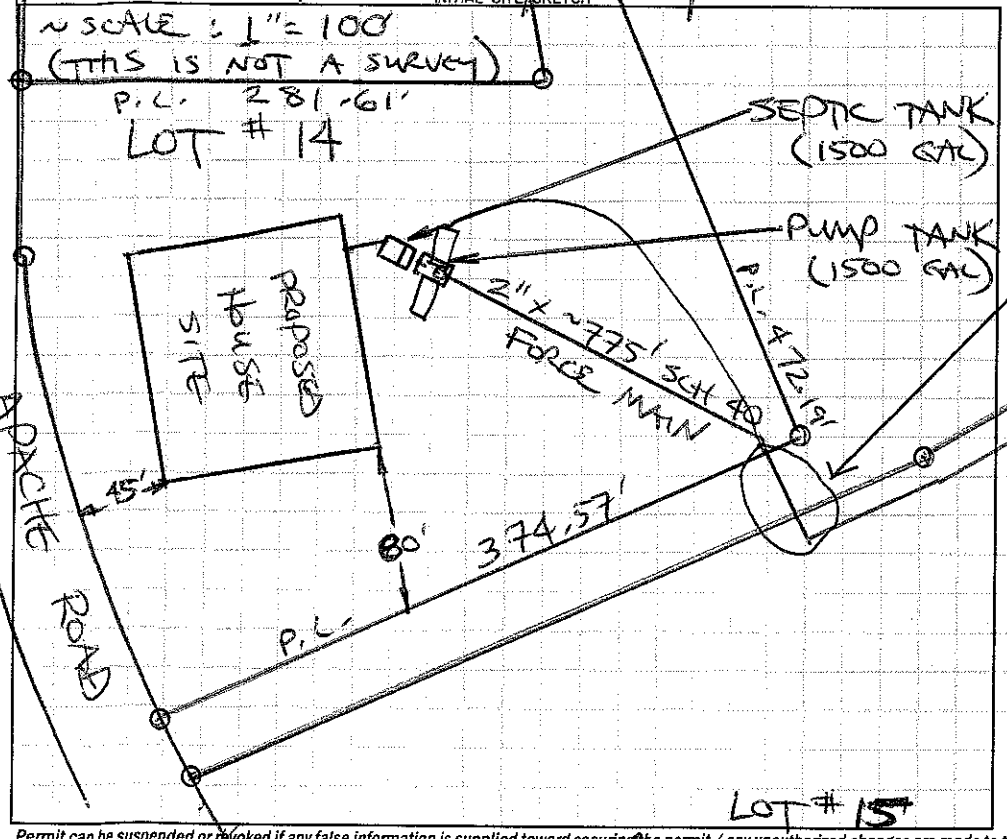

AS BUILT SKETCH

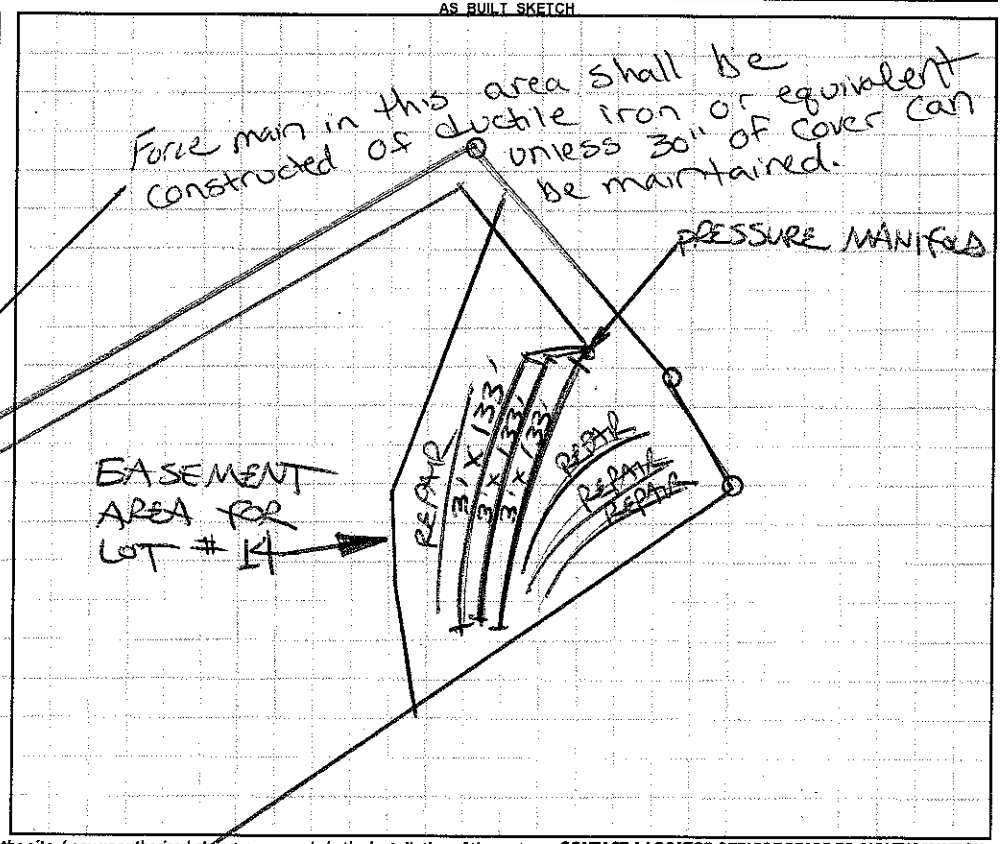

Permit can be suspended or revoked if any false information is supplied toward securing the permit / any unauthorized changes are made to the site / any unauthorized changes are made in the installation of the system. **CONTACT A LOCATOR SERVICE PRIOR TO ANY EXCAVATION**

☐ **IMPROVEMENT PERMIT** *with plat valid without expiration.* ☑ **IMPROVEMENT PERMIT** *with site plan valid for 60 mos.* ☐ **AUTHORIZATION TO CONSTRUCT** *valid for period equal to IMPROVEMENT PERMIT--not to exceed 60 mo.*

Owner / Applicant Signature: Toney Jacobs (by) Date: 1-4-13 Installed by: Gunnoe Grading

IMPROVEMENT PERMIT by: R. STEVE HENRICK Date: 1/4/13 OPERATION PERMIT by: Daniel A. Shue Date: 09/16/15

AUTHORIZATION TO CONSTRUCT by: Justin Henderson Date: 12-4-13 Existing System Inspected by: Date:

Health Dept. Copy - WHITE Applicant (Final Approval) - YELLOW Applicant (Conditional Approval) - PINK