Lake Norman Motor Coach Resort LLC

DELL COUNTY HEALTH DEPARTMENT

Statesville Office (704) 878-5305 Mooresville Office (704) 660-3625

PERMIT # 20090 (176485)

IMPROVEMENT PERMIT / AUTHORIZATION TO CONSTRUCT / OPERATION PERMIT / EXISTING SYSTEM

PIN # 4639-09-4090.000 (4639-18-4818)

APPLICANT: TONEY JACOBS APPLICANT ADDRESS: 168 BROADBILL DRIVE MOORESVILLE, NC 28117

SITE ADDRESS: 188 Apache ~~Cove Rd~~ - Irton 28166 PHONE: 704-663-6905 ALT. PHONE: 704-483-6033

SITE DIRECTIONS: STATE PARK ROAD TO MORRISON FARM ROAD, TL APACHE ROAD, LOT 14 ON RIGHT


SUBDIVISION: TWIN COVES @ MORRISON SECTION: LOT # 14 LOT AREA: 3.0 ACRE DESIGN FLOW: 480 L.T.A.R.: 0.30 gpd/ft2

Septic Tank	1500	(gal)	STB	390	Date	10-15-13	☑ New System	☐ Repair	☐ Expansion	System Type: I II (III) IV V VI	☑ Residence	No. Bedrooms	4	Water Supply
Pump Tank	1500	(gal)	PT	353	Date	11-30-13	System Description:	25% REDUCTION, PUMP			☐ Business	No. Persons		☑ Private
Pump Make			Model		Serial #		Repair System Description:	25% REDUCTION, PUMP			☐ Other	No. Employees		☐ Public
# Nitrification Fields	1		# Lines	THREE	Linear Ft:	400	Maintenance Agreement Required:	☐ YES	☑ NO		☐ Slab	☐ Crawl Space		☐ Community
Trench Width	36"		Max. Trench Bottom Depth	36"	Gravel Depth	N/A		☐ GRAVITY	☑ PRESSURE		☑ Basement w/plumbing			☐ Basement w/o plumbing


Comments / Conditions: ① REMOVE EXISING FIELD TERRACES IN AREA of DRAINFIELD ② INSTALL 25% REDUCTION SYSTEM ON CONTOUR ③ SEE ATTACHED "FAST TRACK" SITE PLAN & PUMP SPECIFICATIONS PREPARED BY TONEY JACOBS.

Off site easement: 4639-19-1027 Lot #15

INITIAL SITE SKETCH

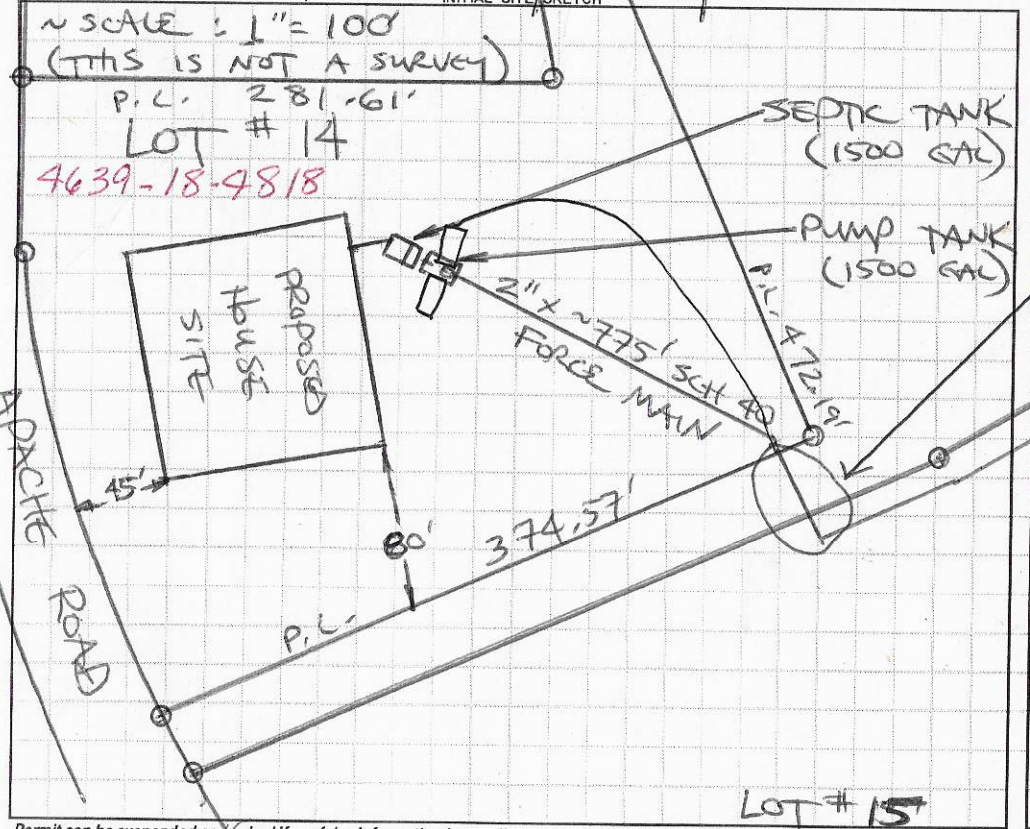

AS BUILT SKETCH

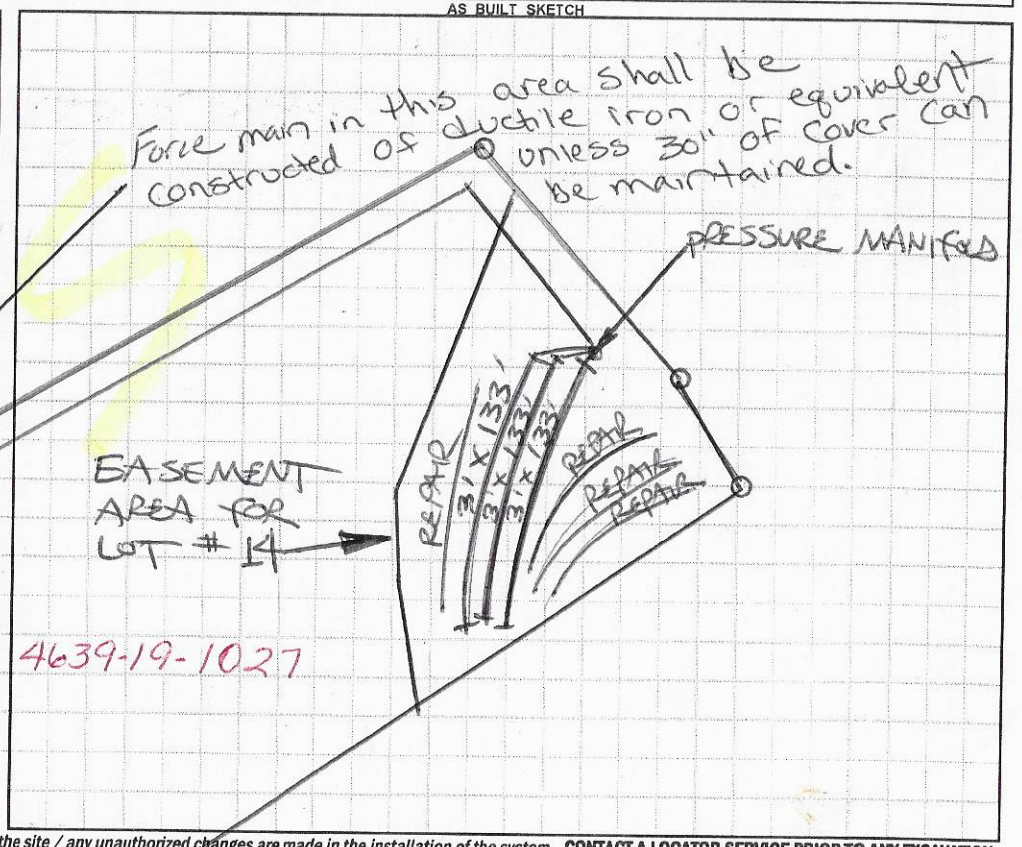

Permit can be suspended or revoked if any false information is supplied toward securing the permit / any unauthorized changes are made to the site / any unauthorized changes are made in the installation of the system. **CONTACT A LOCATOR SERVICE PRIOR TO ANY EXCAVATION**

☐ **IMPROVEMENT PERMIT** *with plat valid without expiration.* ☑ **IMPROVEMENT PERMIT** *with site plan valid for 60 mos.* ☐ **AUTHORIZATION TO CONSTRUCT** *valid for period equal to IMPROVEMENT PERMIT--not to exceed 60 mo.*

Owner / Applicant Signature: Toney Jacobs (by) Date: 1-4-13 Installed by: Gunner Grading

IMPROVEMENT PERMIT by: R. Steve Herrick Date: 1/4/13 OPERATION PERMIT by: Daniel A. Lowe Date: 09/10/15

AUTHORIZATION TO CONSTRUCT by: Justin Henderson Date: 12-4-13 Existing System Inspected by: Date:

Health Dept. Copy - WHITE Applicant (Final Approval) - YELLOW Applicant (Conditional Approval) - PINK

CONNECTGIS WEB HOSTING

North Carolina Iredell County

1:60

Overview Map

Quick Search

Clear

Lat **Lon**

PIN
4775645210

Owner Name

Address
188 APACHE RD

Street Name

Subdivision



Advanced Search

Search Builder

Coordinate Search

Comparable Search

Excel 2000/2003 **Results**

©2009-2020 Dude Solutions. All Rights Reserved. | Soft