3:30 Dallas Norman

Dallas Norman

IREDELL COUNTY HEALTH DEPARTMENT

STATESVILLE 704-878-5305 (D) MOORESVILLE 704-664-5281

IMPROVEMENT PERMIT / AUTHORIZATION TO CONSTRUCT / OPERATION PERMIT / EXISTING SYSTEM INSPECTION

PERMIT# ~~142274~~ 164289 PIN# ~~4730109262.672~~ 4639-19-6345 DATE 6-21-07

OWNER OR APPLICANT Falls Cove Dev. LLC PHONE: Business _____ Home _____

ADDRESS 2215 Brawley School Rd Mooresville NC 28117

LOCATION State Park Rd TL Morrison Farm TL Park Crest on right near end

SUBDIVISION Parkwood @ Falls Cove BLOCK / SECTION 6 LOT 67 LOT AREA 96655 ft² (2.219 Ac) SITE CLASS. PS DESIGN FLOW 480gpd L.T.A.R. .25 gpd/ft²

Septic Tank: 1500 # Gallons; STB 961 Date _____

Pump Tank: 1500 # Gallons; PT 253 Date 12-27-10

Pump Make: Goulds Model _____ Serial No. _____

Nitrification Field: No Fields 1 Square Feet _____ Linear Feet 500

No Lines 5@100' Trench Width 36" Max Trench Bottom Depth 36" Gravel Depth N/A ☐ Gravity ☒ Pressure

☒ New System ☐ Repair ☐ Expansion System Type: I II III IV V VI

System Description: 25% reduction pm

Repair System Description: LP PPBPS

Maintenance Agreement Required: ☐ Yes ☒ No

☒ House/Mod. Home ☐ Mobile Home ☐ Business ☐ Other

No. Bedrooms 4 No. Persons 8 No. Employees _____

Water Supply: ☐ Individual ☒ Public ☐ Community

☐ Slab ☐ Crawl Space ☒ Basement w/plumbing ☐ Basement wo/plumbing

Comments:/Conditions: As per plan specs

Comments:/Conditions:

INITIAL SITE SKETCH

See plan from S+ME

AS BUILT SKETCH

Installed as Drawn


Permit can be suspended or revoked if any false information is supplied toward securing the permit/any unauthorized changes are made to the site/any unauthorized changes are made in the installation of the system. Improvement Permit with plat valid without expiration ☐ Improvement Permit with site plan valid for sixty months ☑ Authorization to Construct is valid for a period equal to that of Improvement Permit – not to exceed sixty months.


Signed: _____ date 06/26/07 Installed by: Gunter Grading

Improvement Permit by: _____ date 6-21-07 Operation Permit by: _____, R.S. date 15 Jul 11

Authorization to Construct by: R. Steve Hedrick date 11-19-2010 Existing System Inspection by: _____ date _____

HEALTH DEPT. COPY: WHITE OWNER COPY (FINAL): YELLOW OWNER COPY (INITIAL): PINK

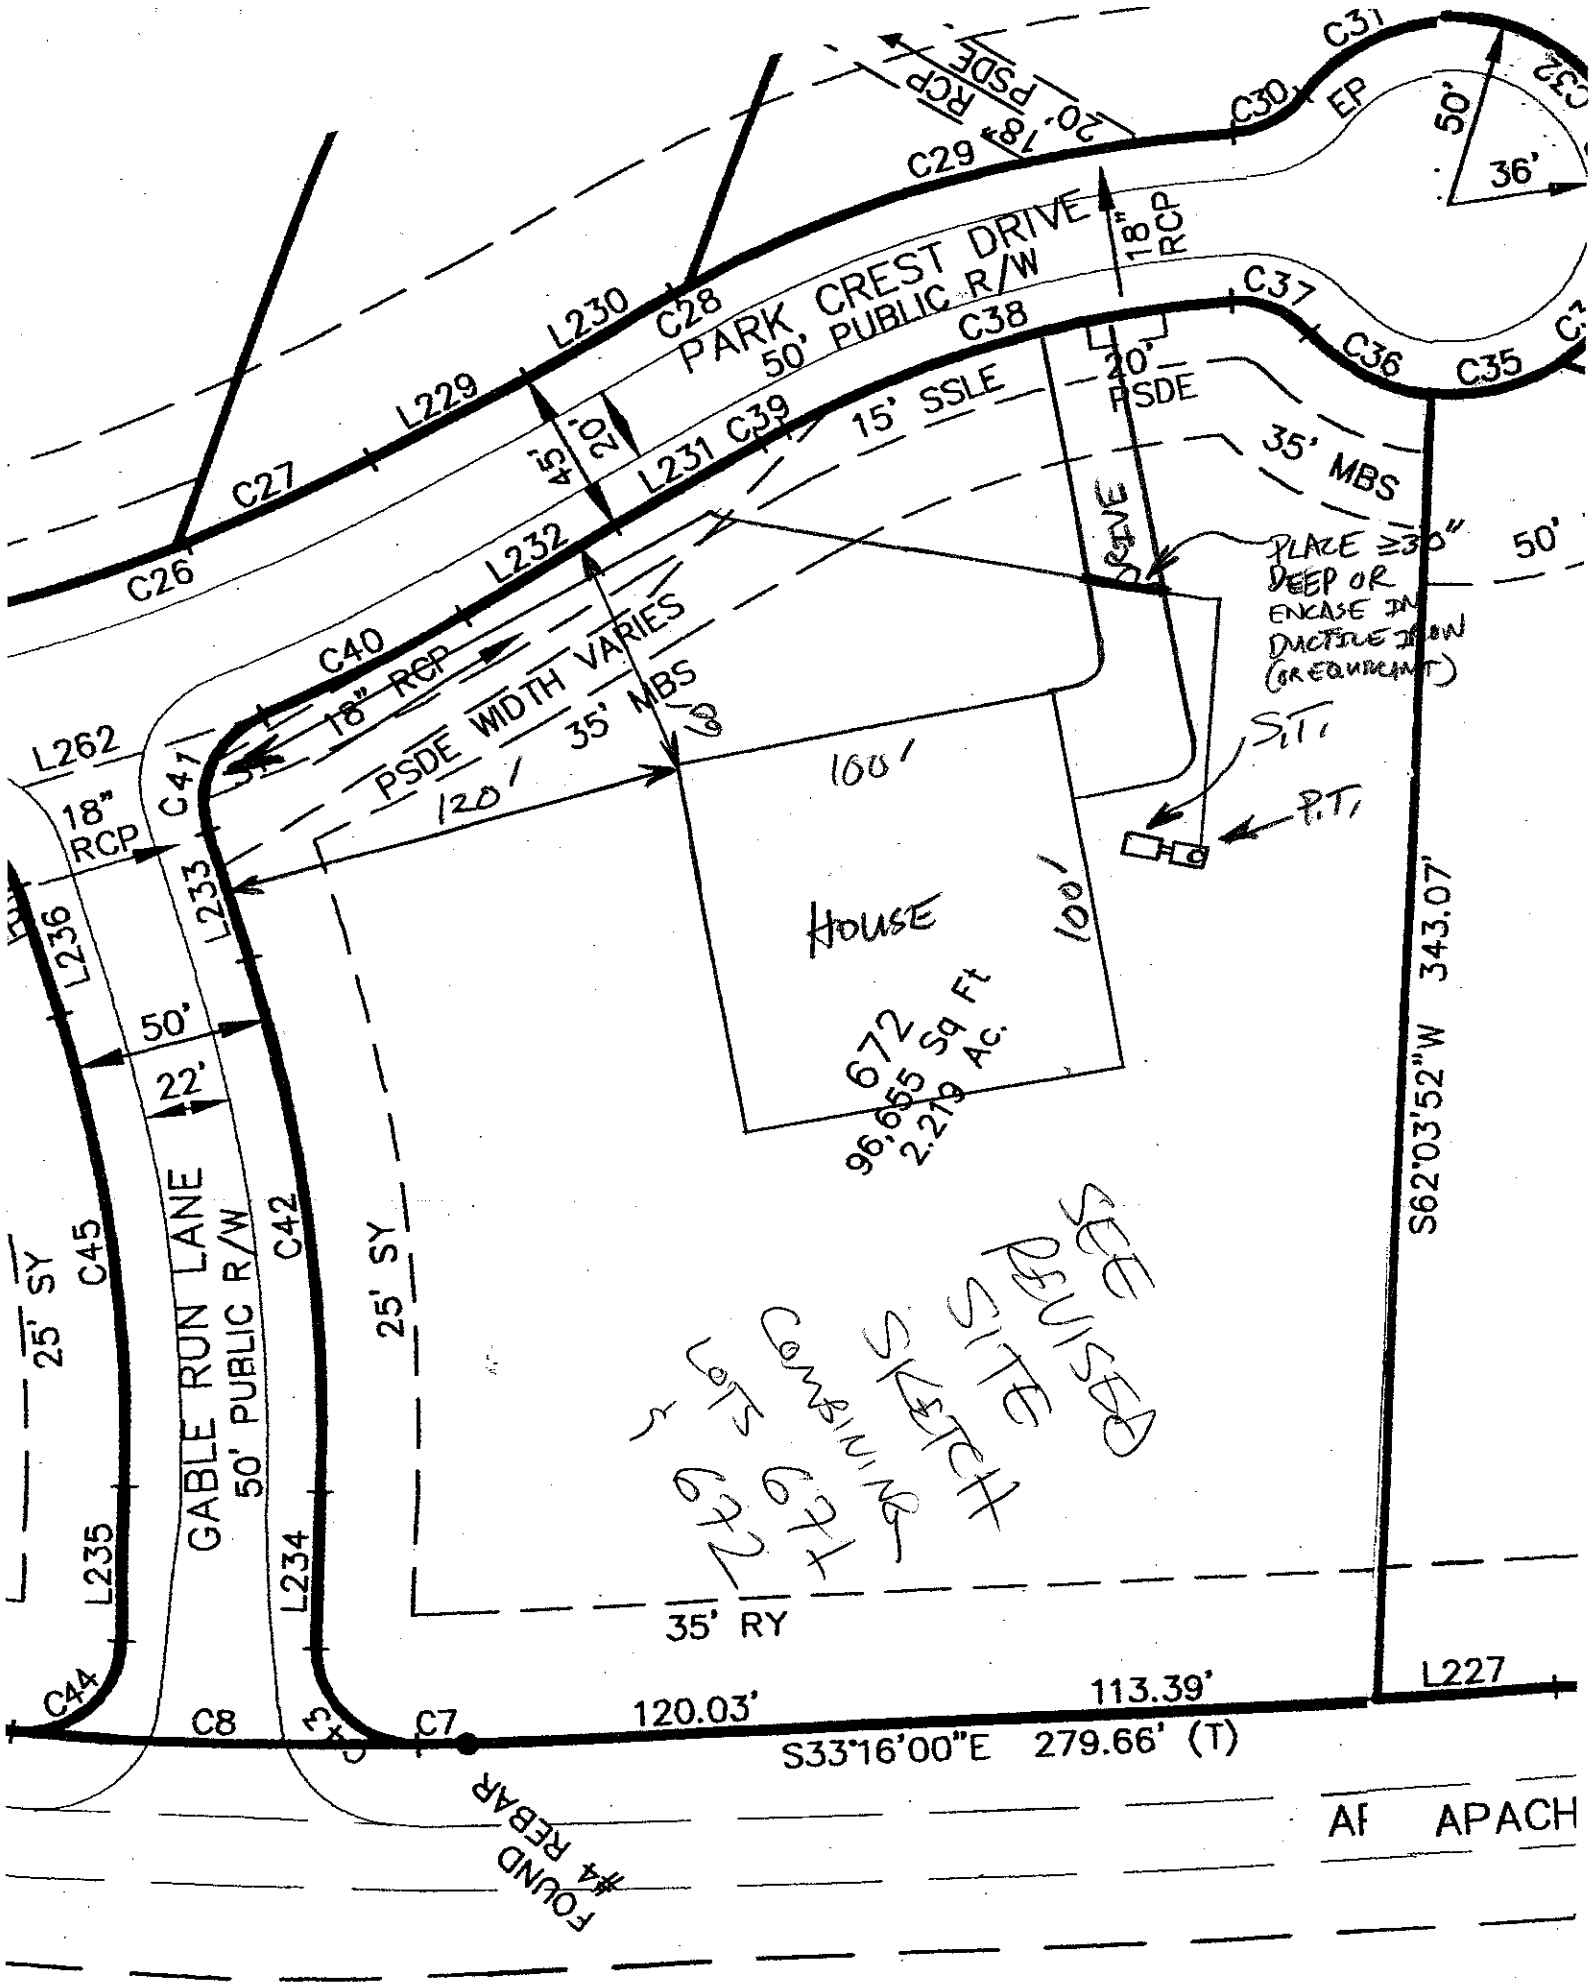
PARK CREST DRIVE
50' PUBLIC R/W
GABLE RUN LANE
50' PUBLIC R/W
15' SSLE
20' PSDE
PSDE WIDTH VARIES
120'
35' MBS
35' RY
25' SY
50'
22'
18" RCP
20' 18" RCP PSDE
DRIVE
PLACE ≥30" DEEP OR ENCASE IN DUCTILE IRON (OR EQUIVALENT)
S.T.
P.T.
HOUSE
100'
672
96,655 Sq Ft
2.219 Ac.
S62°03'52"W 343.07'
120.03'
113.39'
S33°16'00"E 279.66' (T)
FOUND #4 REBAR
SEE REVISED SITE SKETCH
C26
C27
C28
C29
C30
C31
C32
C35
C36
C37
C38
C39
C40
C41
C42
C44
C45
C7
C8
L227
L229
L230
L231
L232
L233
L234
L235
L236
L262

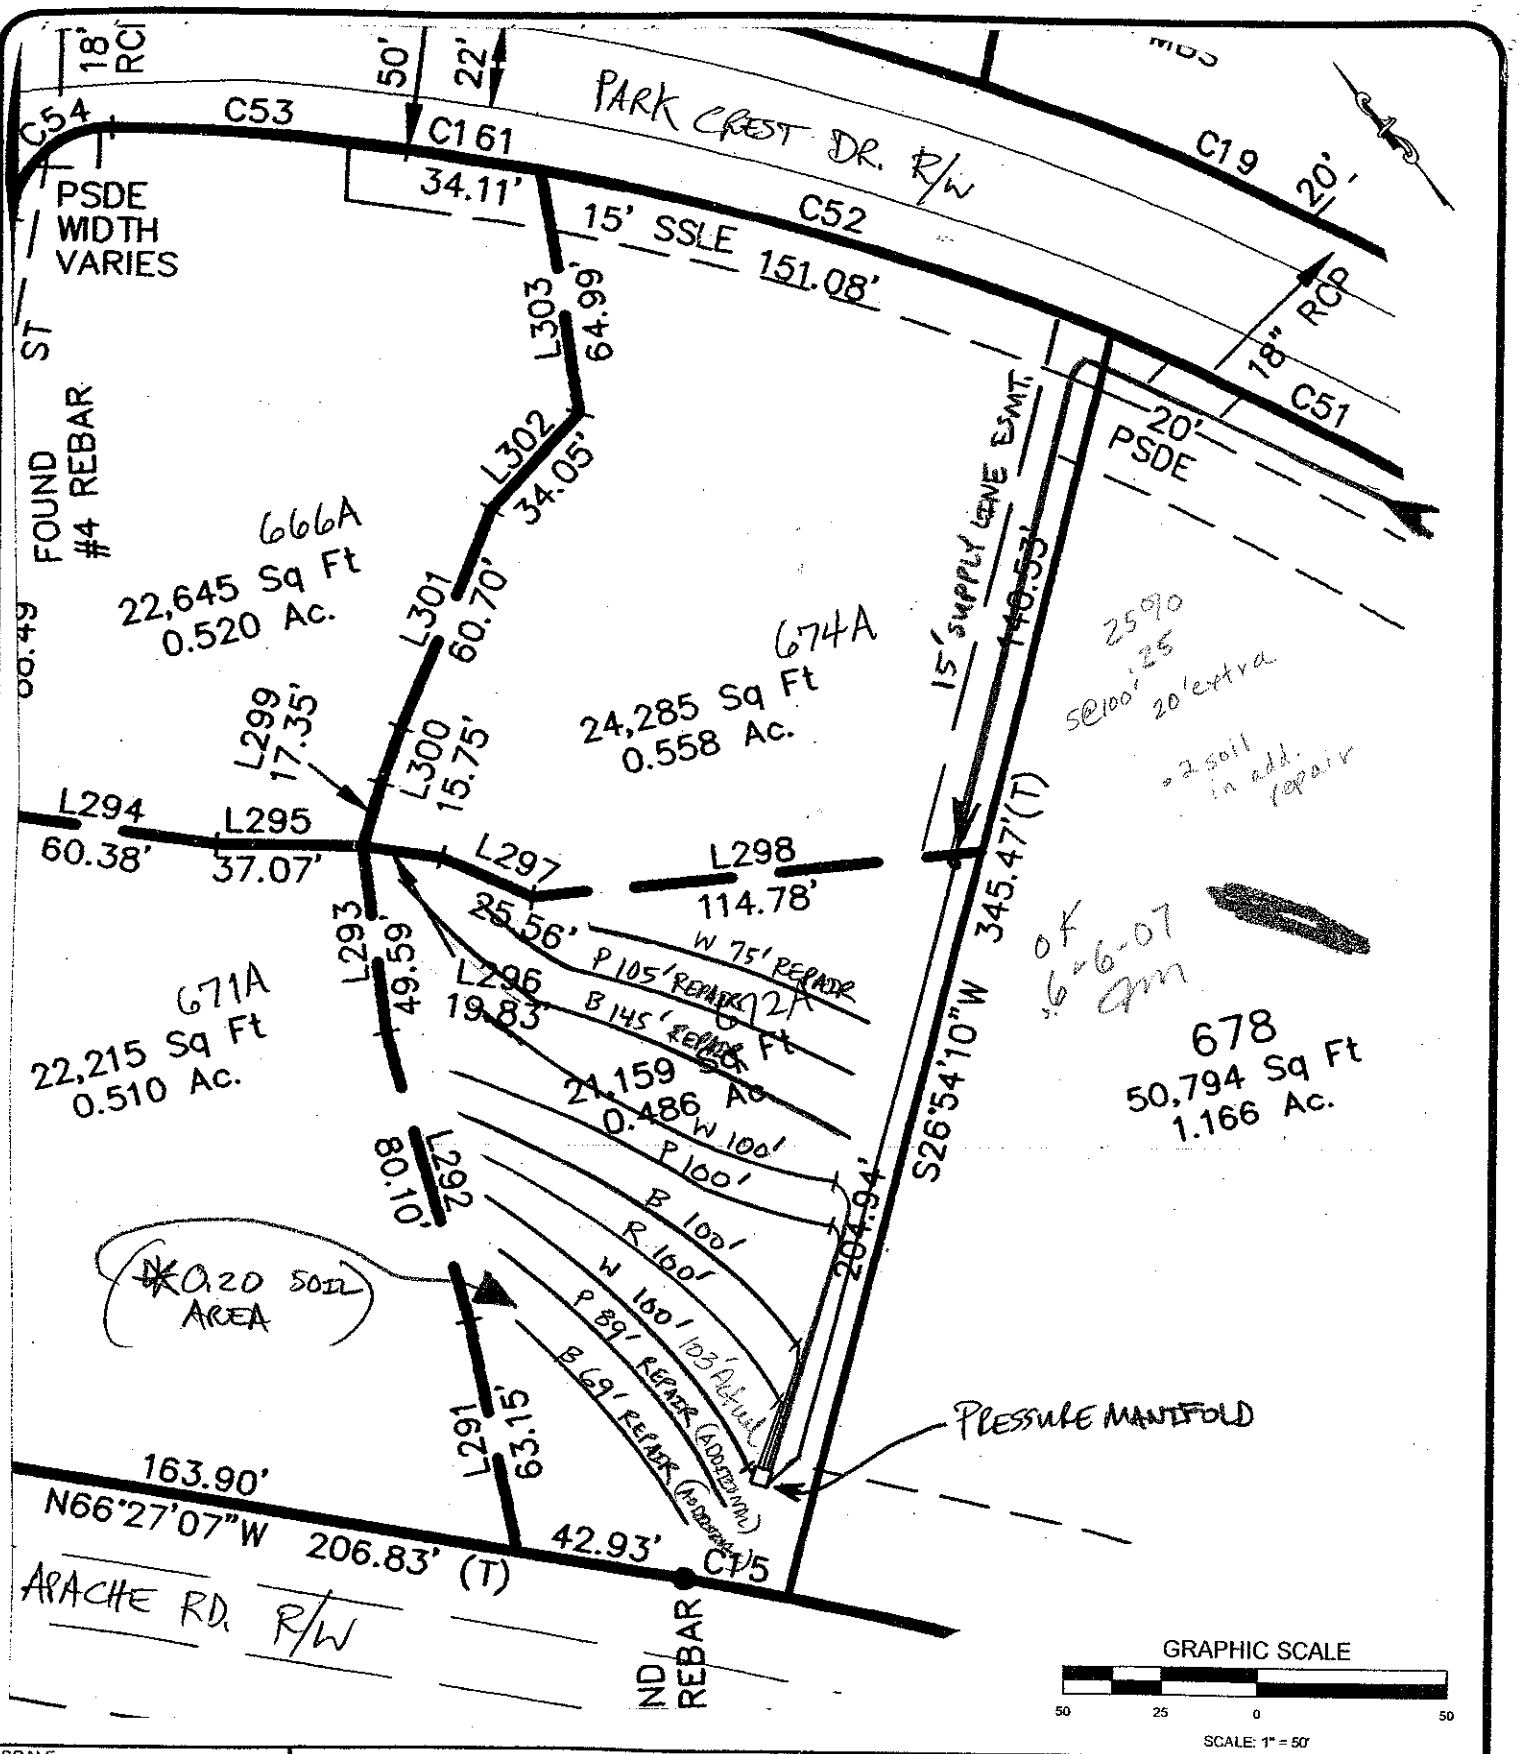

SCALE:	AS SHOWN
DATE:	MAY 2007
DRAWN BY:	RDM
PROJECT NO:	1588-06-091

S&ME
WWW.SMEINC.COM

LOT #672A
CRESCENT PARKWOOD - PHASE 6
IREDELL COUNTY, NORTH CAROLINA

FIGURE NO.