SW

ICHD - ENVIRONMENTAL HEALTH DIVISION

Statesville Office (704) 878-5305 | Mooresville Office (704) 660-3625 | PERMIT # 2023-34985

SEPTIC: IMPROVEMENT PERMIT / AUTHORIZATION TO CONSTRUCT / OPERATION PERMIT / EXISTING SYSTEM

PIN # 4639 -- 20 -- 6228 ✓

APPLICANT/OWNER: Chad Niehaus | APPLICANT ADDRESS: 1116 Cedar Branch Ct, Mooresville

SITE ADDRESS: 1116 Cedar Branch Ct, Mooresville 28117 | PHONE: 513-225-9794 | ALT. PHONE -

SITE DIRECTIONS: Fern Hill - Bagby - Cedar Branch | SAP CONTROLLED: ☐ YES ☐ NO

SUBDIVISION: Woodleaf ✓ | SECTION: P2 ✓ | LOT # 96 ✓ | LOT AREA: 0.689 acres | DESIGN FLOW: 480 gpd | L.T.A.R.: EX

Septic Tank	EX	(gal)	STB		Date				
Pump Tank	EX	(gal)	PT		Date				
Pump Make			Model		Serial #				
# Nitrification Fields	EX	# Lines	EX		Linear Ft	EX			
Trench Width	EX	Trench Bottom Depth(Low side)	EX		Gravel Depth	-			

☐ New System ☐ Repair ☐ Expansion System Type: I II (III) IV V VI

System Description: EXISTING

Repair System Description: EXISTING

Maintenance Agreement Required: ☐ YES ☒ NO

☐ GRAVITY ☒ PRESSURE

☒ Residence | No. Bedrooms 4 | Water Supply

☐ Business | No. Persons 8 | ☒ Private

☐ Other | No. Employees | ☐ Public


☐ Slab | ☒ Crawl Space | ☐ Community

☐ Basement w/plumbing | ☐ Basement w/o plumbing

Comments / Conditions: System appeared to be working at time of inspection.

INITIAL SITE SKETCH

1=60

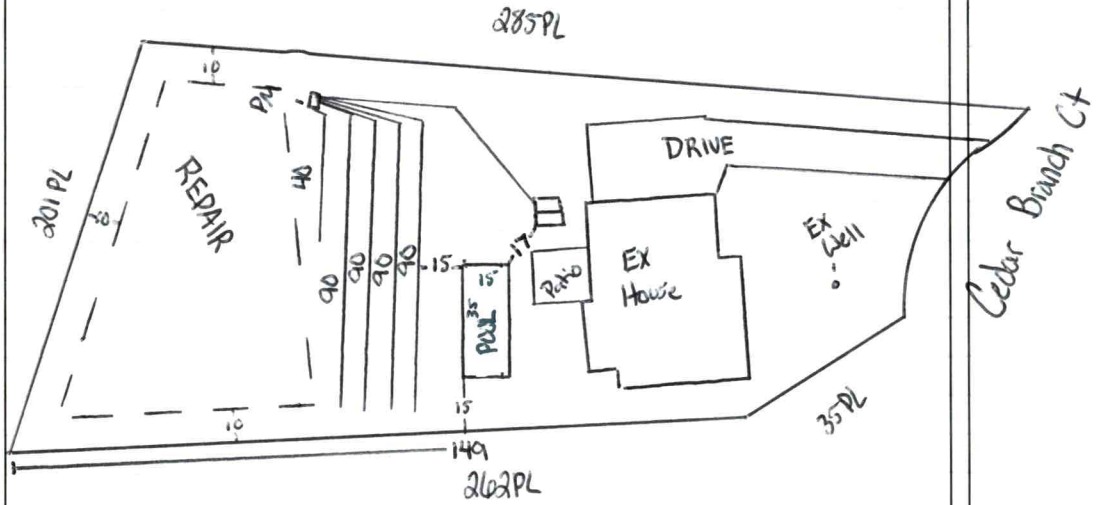

AS BUILT SKETCH

FOR SEPTIC FINAL INSPECTION CALL: 704-664-3703 between 8am-9am the day the inspection is needed. Be sure to speak with an inspector to confirm your time.

Permit can be suspended or revoked if any false information is supplied toward securing the permit / any unauthorized changes are made to the site / any unauthorized changes are made in the installation of the system. **CONTACT A LOCATOR SERVICE PRIOR TO ANY EXCAVATION**


☐ **IMPROVEMENT PERMIT** ***with plat*** *valid without expiration.* ☒ **IMPROVEMENT PERMIT** ***with site plan*** *valid for 60 mos.* ☒ **AUTHORIZATION TO CONSTRUCT** *valid for period equal to IMPROVEMENT PERMIT--not to exceed 60 mo.*

Owner / Applicant Signature: Online Signature | Date: | Installed by:

IMPROVEMENT PERMIT by: | Date: | OPERATION PERMIT by: | Date:

AUTHORIZATION TO CONSTRUCT by: | Date: | Existing System Inspected by: Cary Hill | Date: 9/19/23

FOR SEPTIC FINAL INSPECTION: CALL 704-664-3703 between 8am-9am the day the inspection is needed.

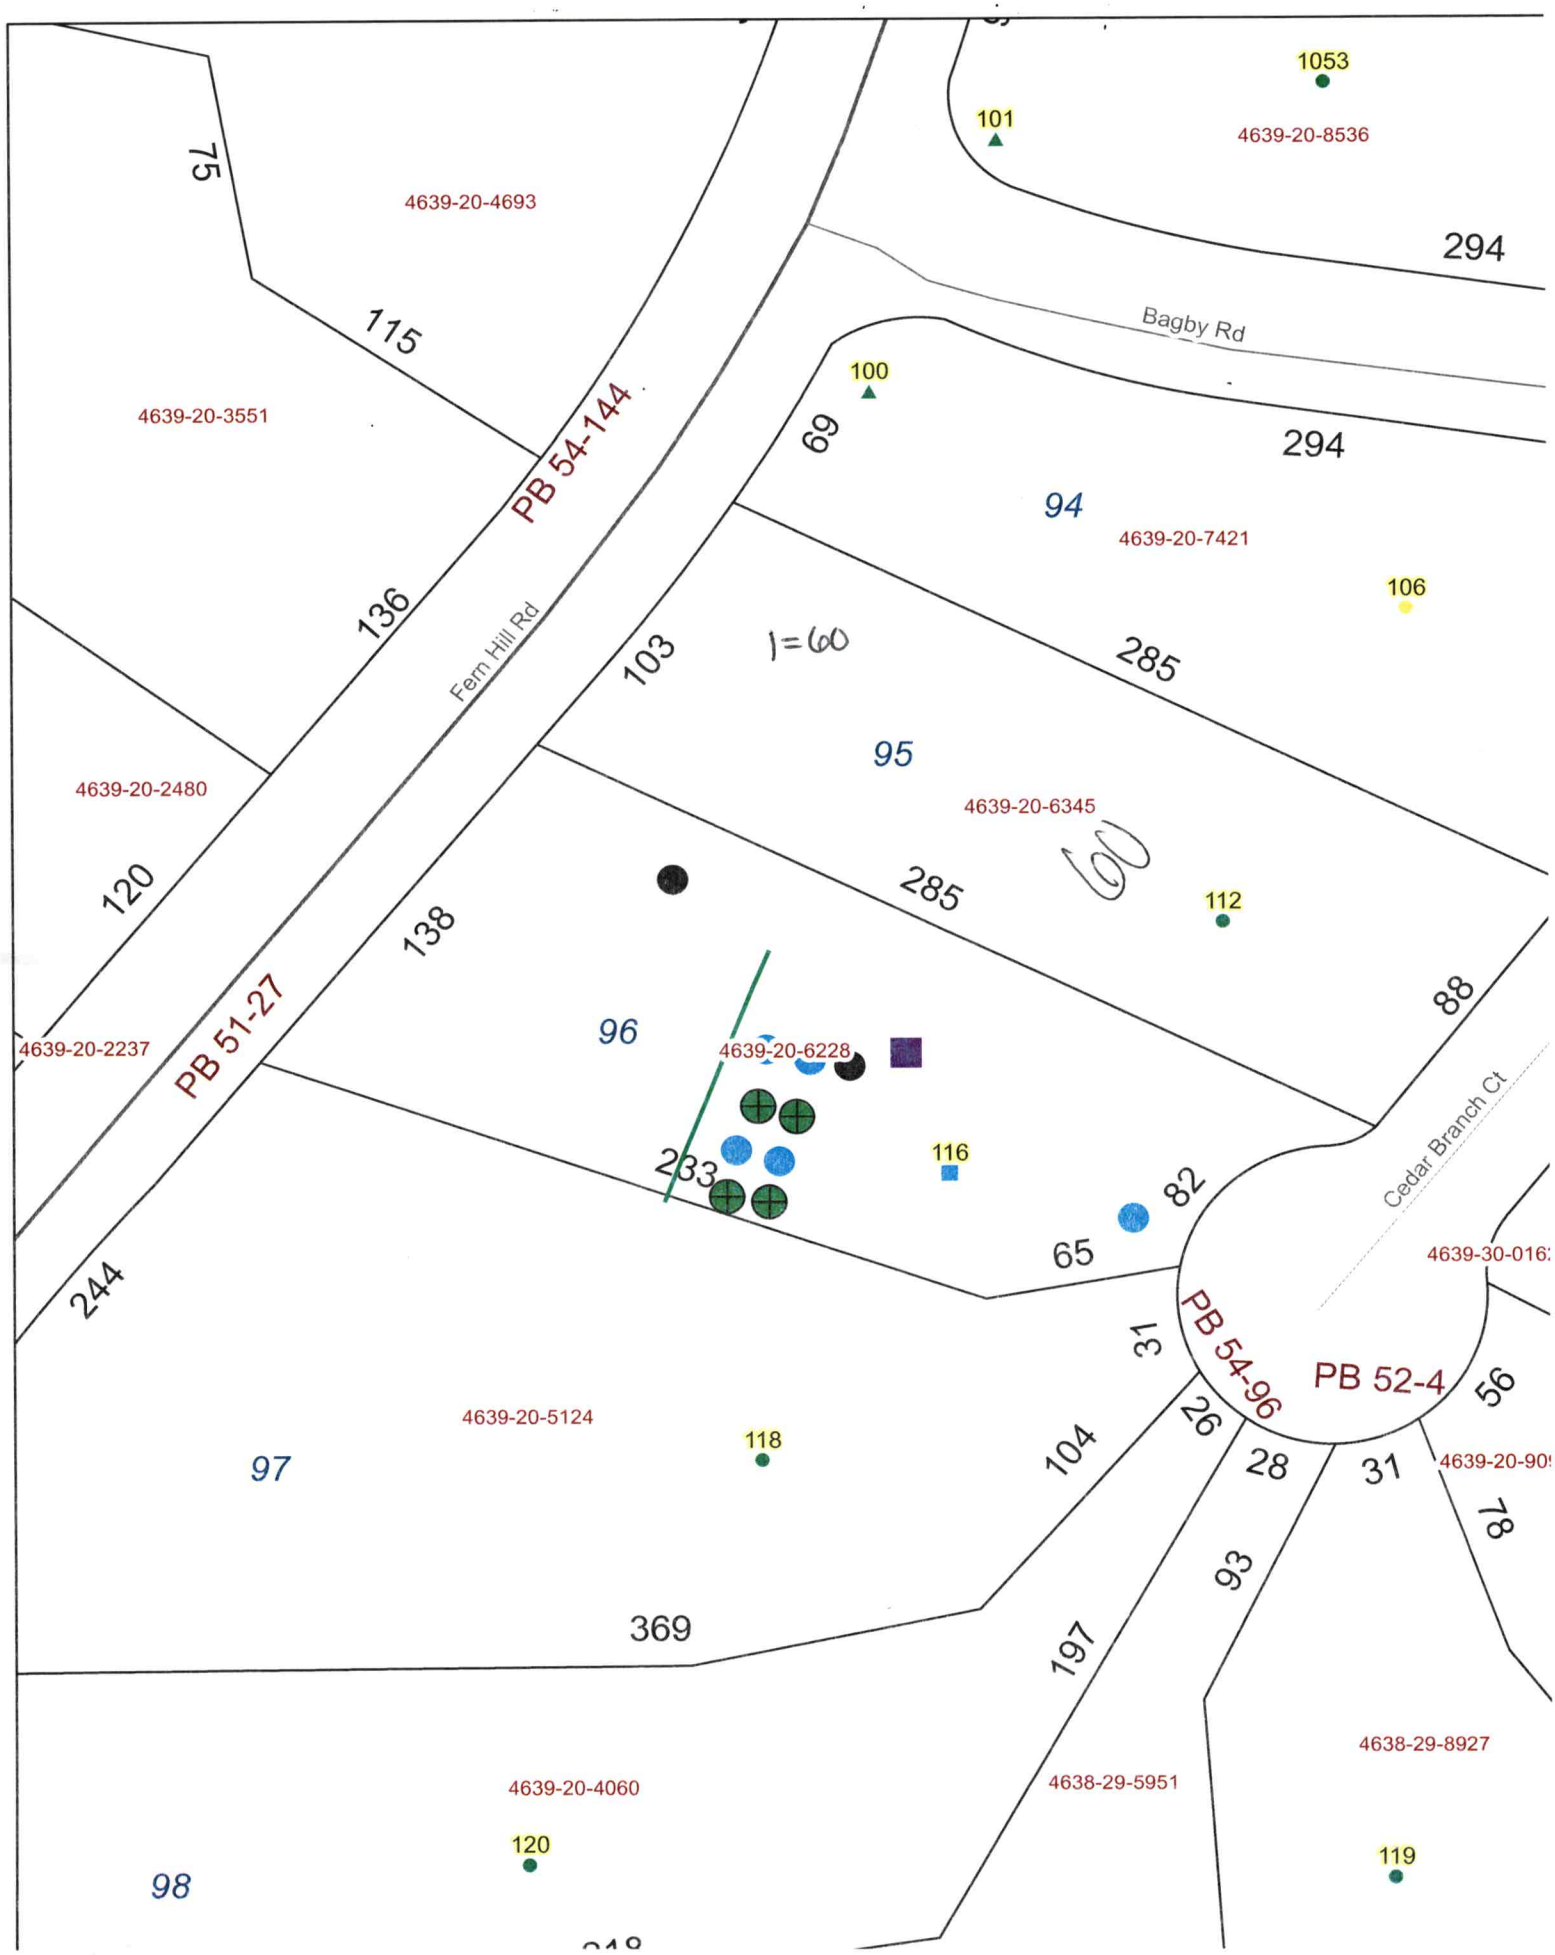
1053
101
4639-20-8536
294
Bagby Rd
75
4639-20-4693
115
PB 54-144
100
69
294
94
4639-20-7421
106
4639-20-3551
136
Fern Hill Rd
103
1=60
285
95
4639-20-2480
4639-20-6345
120
285
60
112
138
88
PB 51-27
4639-20-2237
96
4639-20-6228
116
233
82
Cedar Branch Ct
65
4639-30-016
244
PB 54-96
PB 52-4
31
56
4639-20-5124
118
104
26
28
31
4639-20-90
97
78
93
369
197
4638-29-8927
4639-20-4060
4638-29-5951
120
119
98