IREDELL COUNTY HEALTH DEPARTMENT

Statesville Office (704) 878-5305 Mooresville Office (704) 660-3625

PERMIT # 217037

IMPROVEMENT PERMIT / AUTHORIZATION TO CONSTRUCT / OPERATION PERMIT / EXISTING SYSTEM

PIN # 4639206345

APPLICANT: Lake Shore Holdings LLC APPLICANT ADDRESS: P.O. 5350 Mooresville, NC. 28117

SITE ADDRESS: 112 Cedar Branch Ct Mooresville, NC PHONE: 7047997609 ALT. PHONE: 9193894500

SITE DIRECTIONS: Hwy 150 W TR Perth Rd TL Fern Hill TL Bagby TR Cedar Branch 2nd on right


SUBDIVISION: Wood Leaf SECTION: 2 LOT # 95 LOT AREA: .655 Acre DESIGN FLOW: 480gpd L.T.A.R.: .9

Septic Tank	1000 (gal)	STB 760	Date 4-25-16	☒ New System ☐ Repair ☐ Expansion	System Type: I II III IV V VI	☒ Residence	No. Bedrooms	4	Water Supply
Pump Tank	1000 (gal)	PT 363	Date 2-3-16	System Description: Pump-PM-25% Reduction		☐ Business	No. Persons	8	☒ Private
Pump Make		Model	Serial #	Repair System Description: LPPPBPS		☐ Other	No. Employees		☐ Public
# Nitrification Fields	1	# Lines 5	Linear Ft: 400'	Maintenance Agreement Required:	☐ YES ☒ NO	☐ Slab	☒ Crawl Space		☐ Community
Trench Width	36"	Max. Trench Bottom Depth 36"	Gravel Depth N/A		☐ GRAVITY ☒ PRESSURE	☐ Basement w/plumbing		☐ Basement w/o plumbing	

Comments / Conditions:

This permit replaces previous permit dated 6-4-07.

INITIAL SITE SKETCH

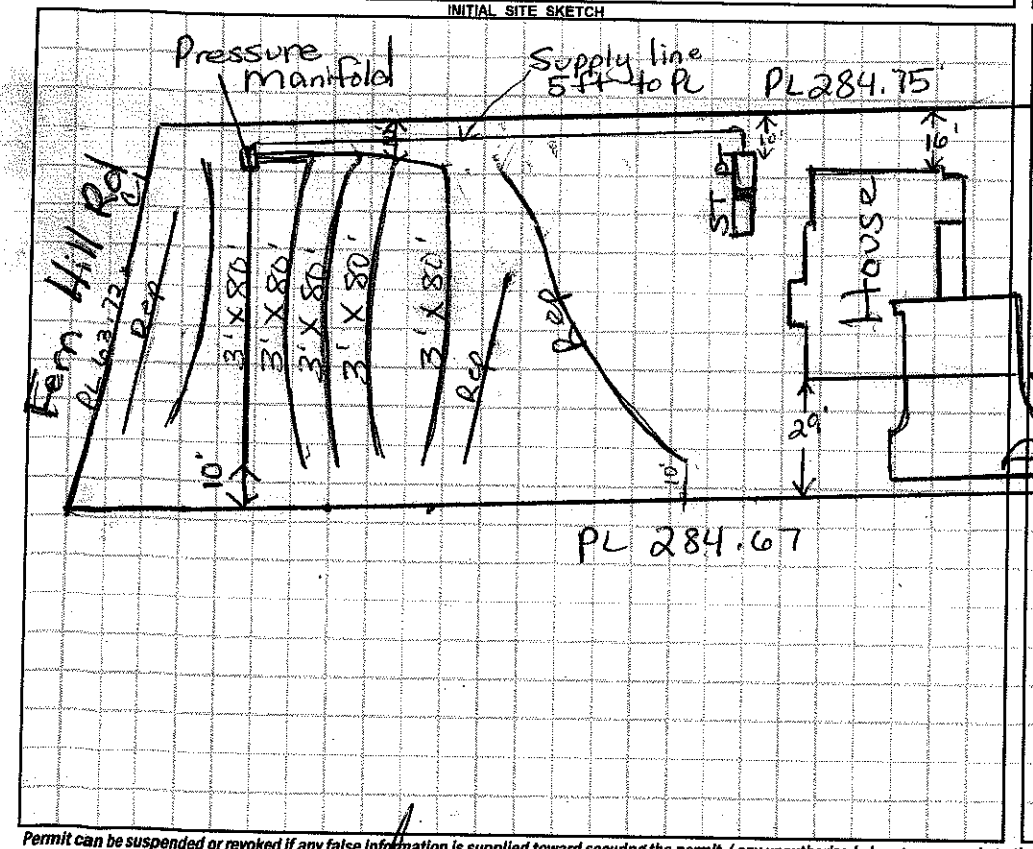


AS BUILT SKETCH

Scale 1:50


8-10-16: Shoaf 1000-gal mid seam conc. tank w a Polylok PL-68f, lter

IP Shoaf top-seam 1000-Gal conc. pump tank

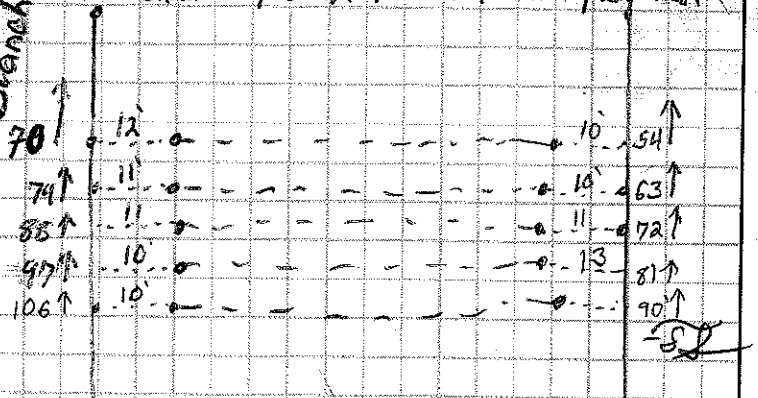

L_1 = 82' 4' 5.5"
L_2 = 82' 4' 9.5"
L_3 = 82' 5' 0.5"
L_4 = 82' 5' 4.5"
L_5 = ~~178~~ 82' 5' 5.5" SP

8-11-16: Headers ok + Tank Locations ok (previously too close)

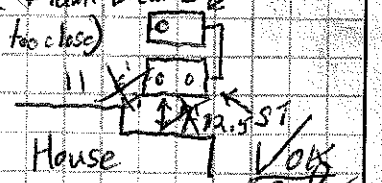

Permit can be suspended or revoked if any false information is supplied toward securing the permit / any unauthorized changes are made to the site / any unauthorized changes are made in the installation of the system. **CONTACT A LOCATOR SERVICE PRIOR TO ANY EXCAVATION**

☐ **IMPROVEMENT PERMIT** *with plat* valid without expiration. ☐ **IMPROVEMENT PERMIT** *with site plan* valid for 60 mos. ☒ **AUTHORIZATION TO CONSTRUCT** valid for period equal to IMPROVEMENT PERMIT--not to exceed 60 mo.

Owner / Applicant Signature: Date: 4/20/16

IMPROVEMENT PERMIT by: Maina Dotson RS Date: 4/13/16

AUTHORIZATION TO CONSTRUCT by: Maina Dotson RS Date: 4/13/16

Installed by: Gunter Grading (Colby)

OPERATION PERMIT by: Tom Black Date: 12/15/16

Existing System Inspected by: Date:

Health Dept. Copy - WHITE Applicant (Final Approval) - YELLOW Applicant (Conditional Approval) - PINK