IREDELL COUNTY HEALTH DEPARTMENT

STATESVILLE 704-878-5305 MOORESVILLE 704-664-5281

IMPROVEMENT PERMIT / AUTHORIZATION TO CONSTRUCT / OPERATION PERMIT / EXISTING SYSTEM INSPECTION

PERMIT# 131930 PIN# 4639 21 0061 DATE Nov. 8, 05

OWNER OR APPLICANT Nations Land Co. LLC / Pride Homes PHONE: Business _____ Home _____

ADDRESS 4330 Steeple St. NE, Massillon, OH 44646

LOCATION 150 W TR Fern Rd (N) TL Fern Hill TR Harvest Ln. 4th lot on Right

SUBDIVISION Lakewood Crossing BLOCK / SECTION _____ LOT 21 LOT AREA .75 ac SITE CLASS. PS DESIGN FLOW 480 gpd L.T.A.R. .3

Septic Tank: 1000 Gallons: STB 1012 Date 10/9/05

Pump Tank: 1000 Gallons: PT 17 Date 2/10/06

Pump Make: _____ Model _____ Serial No. _____

Nitrification Field: No Fields 1 Square Feet 1200 Linear Feet 400

No Lines 4 Trench Width 36" Max Trench Bottom Depth 36"

☒ New System ☐ Repair ☐ Expansion System Type: I II (III) IV V VI

System Description: pm 25% Reduction

Repair System Description: LPPBPS

Maintenance Agreement Required: ☐ Yes ☒ No initially

☒ House/Mod. Home ☐ Mobile Home ☐ Business ☐ Other

No. Bedrooms 4 No. Persons ____ No. Employees ____

Water Supply: ☒ Individual ☐ Public ☐ Community

Gravel Depth NA ☐ Gravity ☒ Pressure ☐ Slab ☐ Crawl Space ☒ Basement w/plumbing ☐ Basement wo/plumbing

Comments:/Conditions:

Initial site evaluation and system design performed by Rollins Soil & Env. Services

Comments:/Conditions:

INITIAL SITE SKETCH

SEE Plan from Rollins Soil & Env. Services

AS BUILT SKETCH

Quick 4 Installed

Permit can be suspended or revoked if any false information is supplied toward securing the permit/any unauthorized changes are made to the site/any unauthorized changes are made in the installation of the system. Improvement Permit with plat valid without expiration ☐ Improvement Permit with site plan valid for sixty months ☒ Authorization to Construct is valid for a period equal to that of Improvement Permit – not to exceed sixty months.

Signed: Tracy Edwards date 11-10-05

Improvement Permit by: _____ RS date 11-8-05


Authorization to Construct by: _____ RS date 1/5/06

Installed by: C + S

Operation Permit by: Wesley Sparks RS date 7/18/06

Existing System Inspection by: _____ date _____

HEALTH DEPT. COPY: WHITE OWNER COPY (FINAL): YELLOW OWNER COPY (INITIAL): PINK

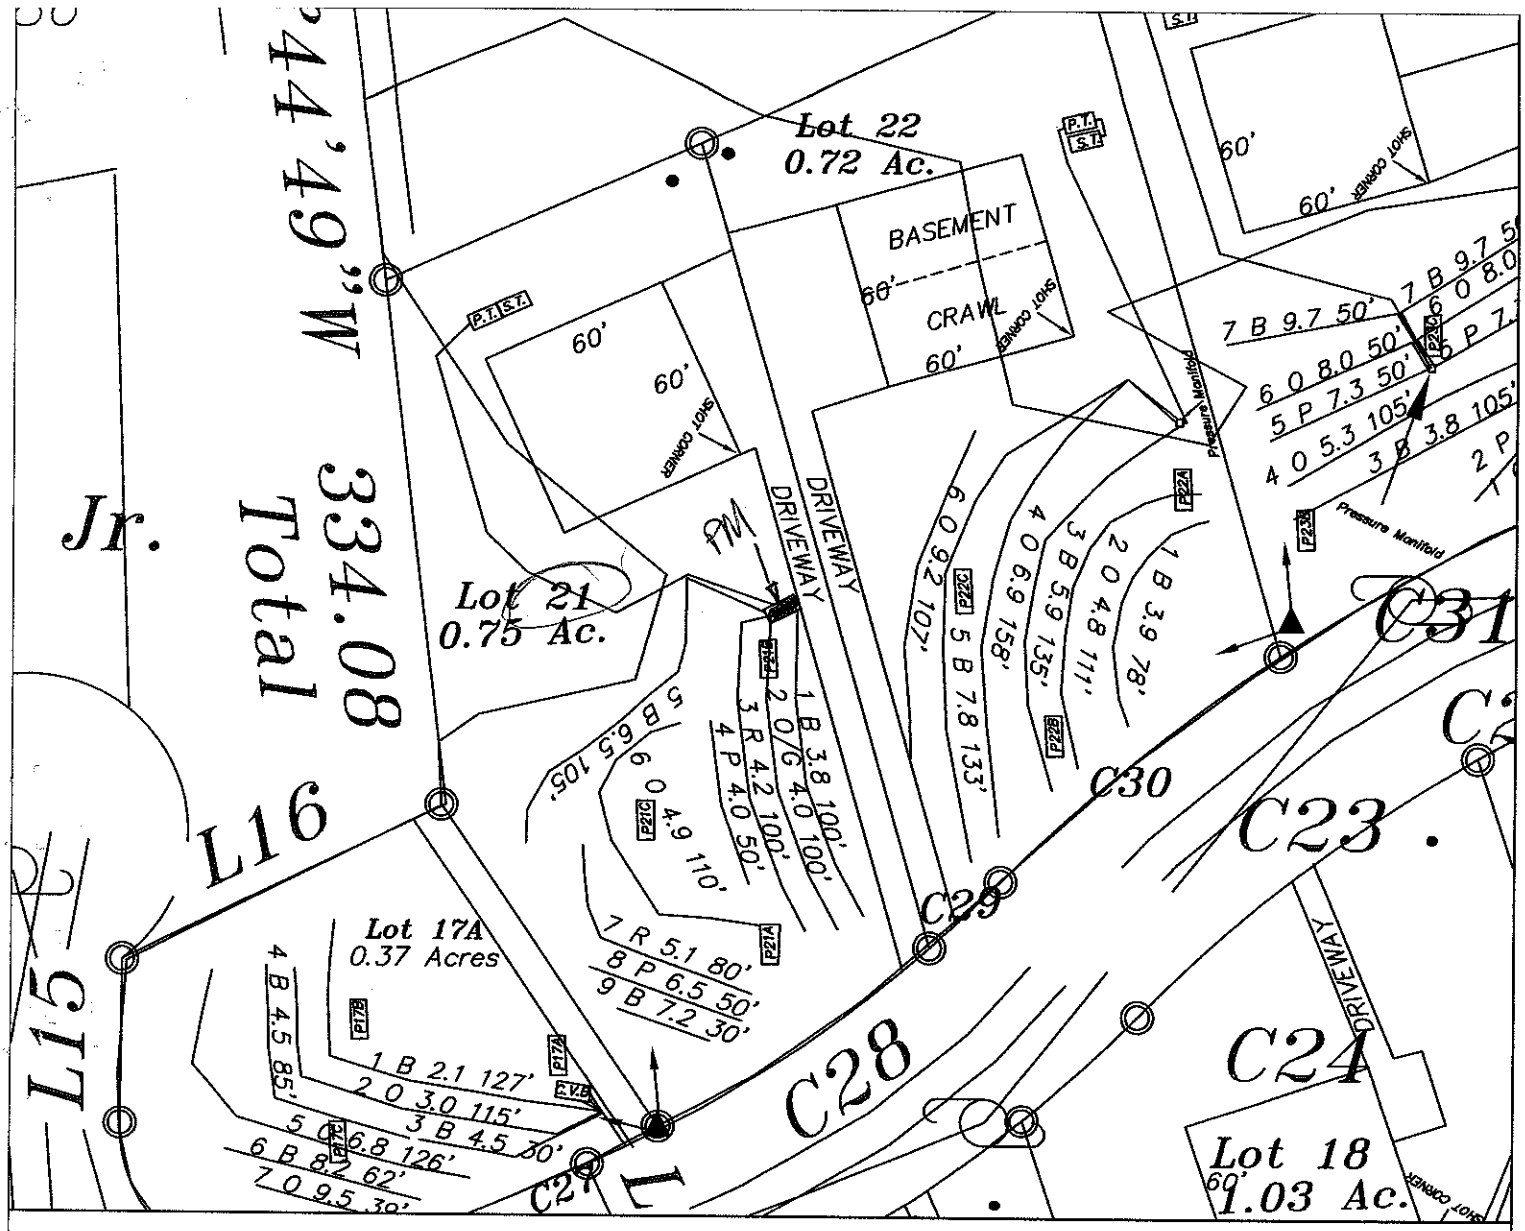

LEGEND

- Areas contain soils with 24 inches or more of useable material and have potential for conventional, modified conventional and low-pressure pipe (lpp) septic systems.
- Unsuitable areas.
- System lines.
- Repair lines.
- Temporary Bench Mark (TBM)
- Well Location.

GRAPHIC SCALE

1" = 60'

60 0 60 120

FOR PRELIMINARY PLANNING PURPOSES ONLY. ALL LOTS WILL REQUIRE FINAL APPROVAL BY THE COUNTY HEALTH DEPARTMENT ON A LOT BY LOT BASIS. THIS MAP SHOULD BY USED AS A GENERAL GUIDE, SOME ADJUSTMENTS WILL BE NECESSARY IN THE FIELD DUE TO SOIL VARIABILITY AND COMPLEX TOPOGRAPHIC FEATURES. THIS MAP ONLY REFLECTS EXISTING SOIL SUITABILITY FOR ON-SITE SEPTIC TANK SYSTEMS.

PLEASE REFER TO ATTACHED SOIL REPORT FOR ADDITIONAL SITE SPECIFIC INFORMATION

ROLLANS SOIL & ENVIRONMENTAL SERVICES
2120 GRAHAM ROAD
MOUNT ULLA, NC 28125
PHONE/FAX: (704) 278-0989
ASHLEY ROLLANS, NC LICENSED SOIL SCIENTIST
MOBILE: (704) 746-5046
EMAIL: ROLLANSFORTCJ@AOL.COM

MAP TITLE: SITE PLAN & DRAINFIELD AREAS

PROJECT NAME: RIDGELINE DEVELOPMENT CORP. / AMINSTON PHASE II

LOCATION/DATE: SHEARER CHAPEL ROAD, IREDELL COUNTY, NORTH CAROLINA, AUGUST 2005

JOB # : 01-1005
FILE: C:\JOBS\01-1005
PROJECT MGR.: S.A.R.
FIELD WORK: S.A.R.
DRAWN BY: S.A.R.