IREDELL COUNTY HEALTH DEPARTMENT

STATESVILLE 704-878-5305 MOORESVILLE 704-664-5281

IMPROVEMENT PERMIT / AUTHORIZATION TO CONSTRUCT / OPERATION PERMIT / EXISTING SYSTEM INSPECTION

PERMIT# 14-293 202968 PIN# ~~4639218089.075~~ AND PAMELA ZONN 4639216474 DATE 5-29-07

OWNER OR APPLICANT Woodbridge Partners LLC / JEFFREY H PHONE: Business Home

ADDRESS PO Box 3608 Mooresville NC 28117

LOCATION Perth Rd N TL Fern Hill TL Trent Pines at end

SUBDIVISION Woodleaf BLOCK / SECTION 2 LOT 75 LOT AREA 1.202Ac SITE CLASS. PS DESIGN FLOW 480gpd L.T.A.R. .25 gpd/ft²

Septic Tank: 1000 Gallons: STB 794 Date 6-30-13

Pump Tank: 1000 Gallons: PT 27 Date 6-16-14

Pump Make: Zoeller Model ~~Hole~~ Serial No. 610002

Nitrification Field: No Fields 1 Square Feet 1440 Linear Feet 480

No Lines 5@96' Trench Width 36" Max Trench Bottom Depth 36" Gravel Depth NA

☒ New System ☐ Repair ☐ Expansion System Type: I II III IV V VI

System Description: 25% reduction pm

Repair System Description: LP PPBPS

Maintenance Agreement Required: ☐ Yes ☒ No

☒ House/Mod. Home ☐ Mobile Home ☐ Business ☐ Other

No. Bedrooms 4 No. Persons 8 No. Employees

Water Supply: ☒ Individual ☐ Public ☐ Community

☐ Gravity ☒ Pressure ☐ Slab ☒ Crawl Space ☐ Basement w/plumbing ☐ Basement wo/plumbing

Comments/Conditions: Used Quick 4 for Drainfield, used Splash plate N152

Comments/Conditions: 8/5/14 Check tanks, lines & pressure manifold 12/17/14 Set 2ft pressure, Checked elect. & Palarm.

INITIAL SITE SKETCH

See Plan from SAME

AS BUILT SKETCH

House Larger than original but should work BA

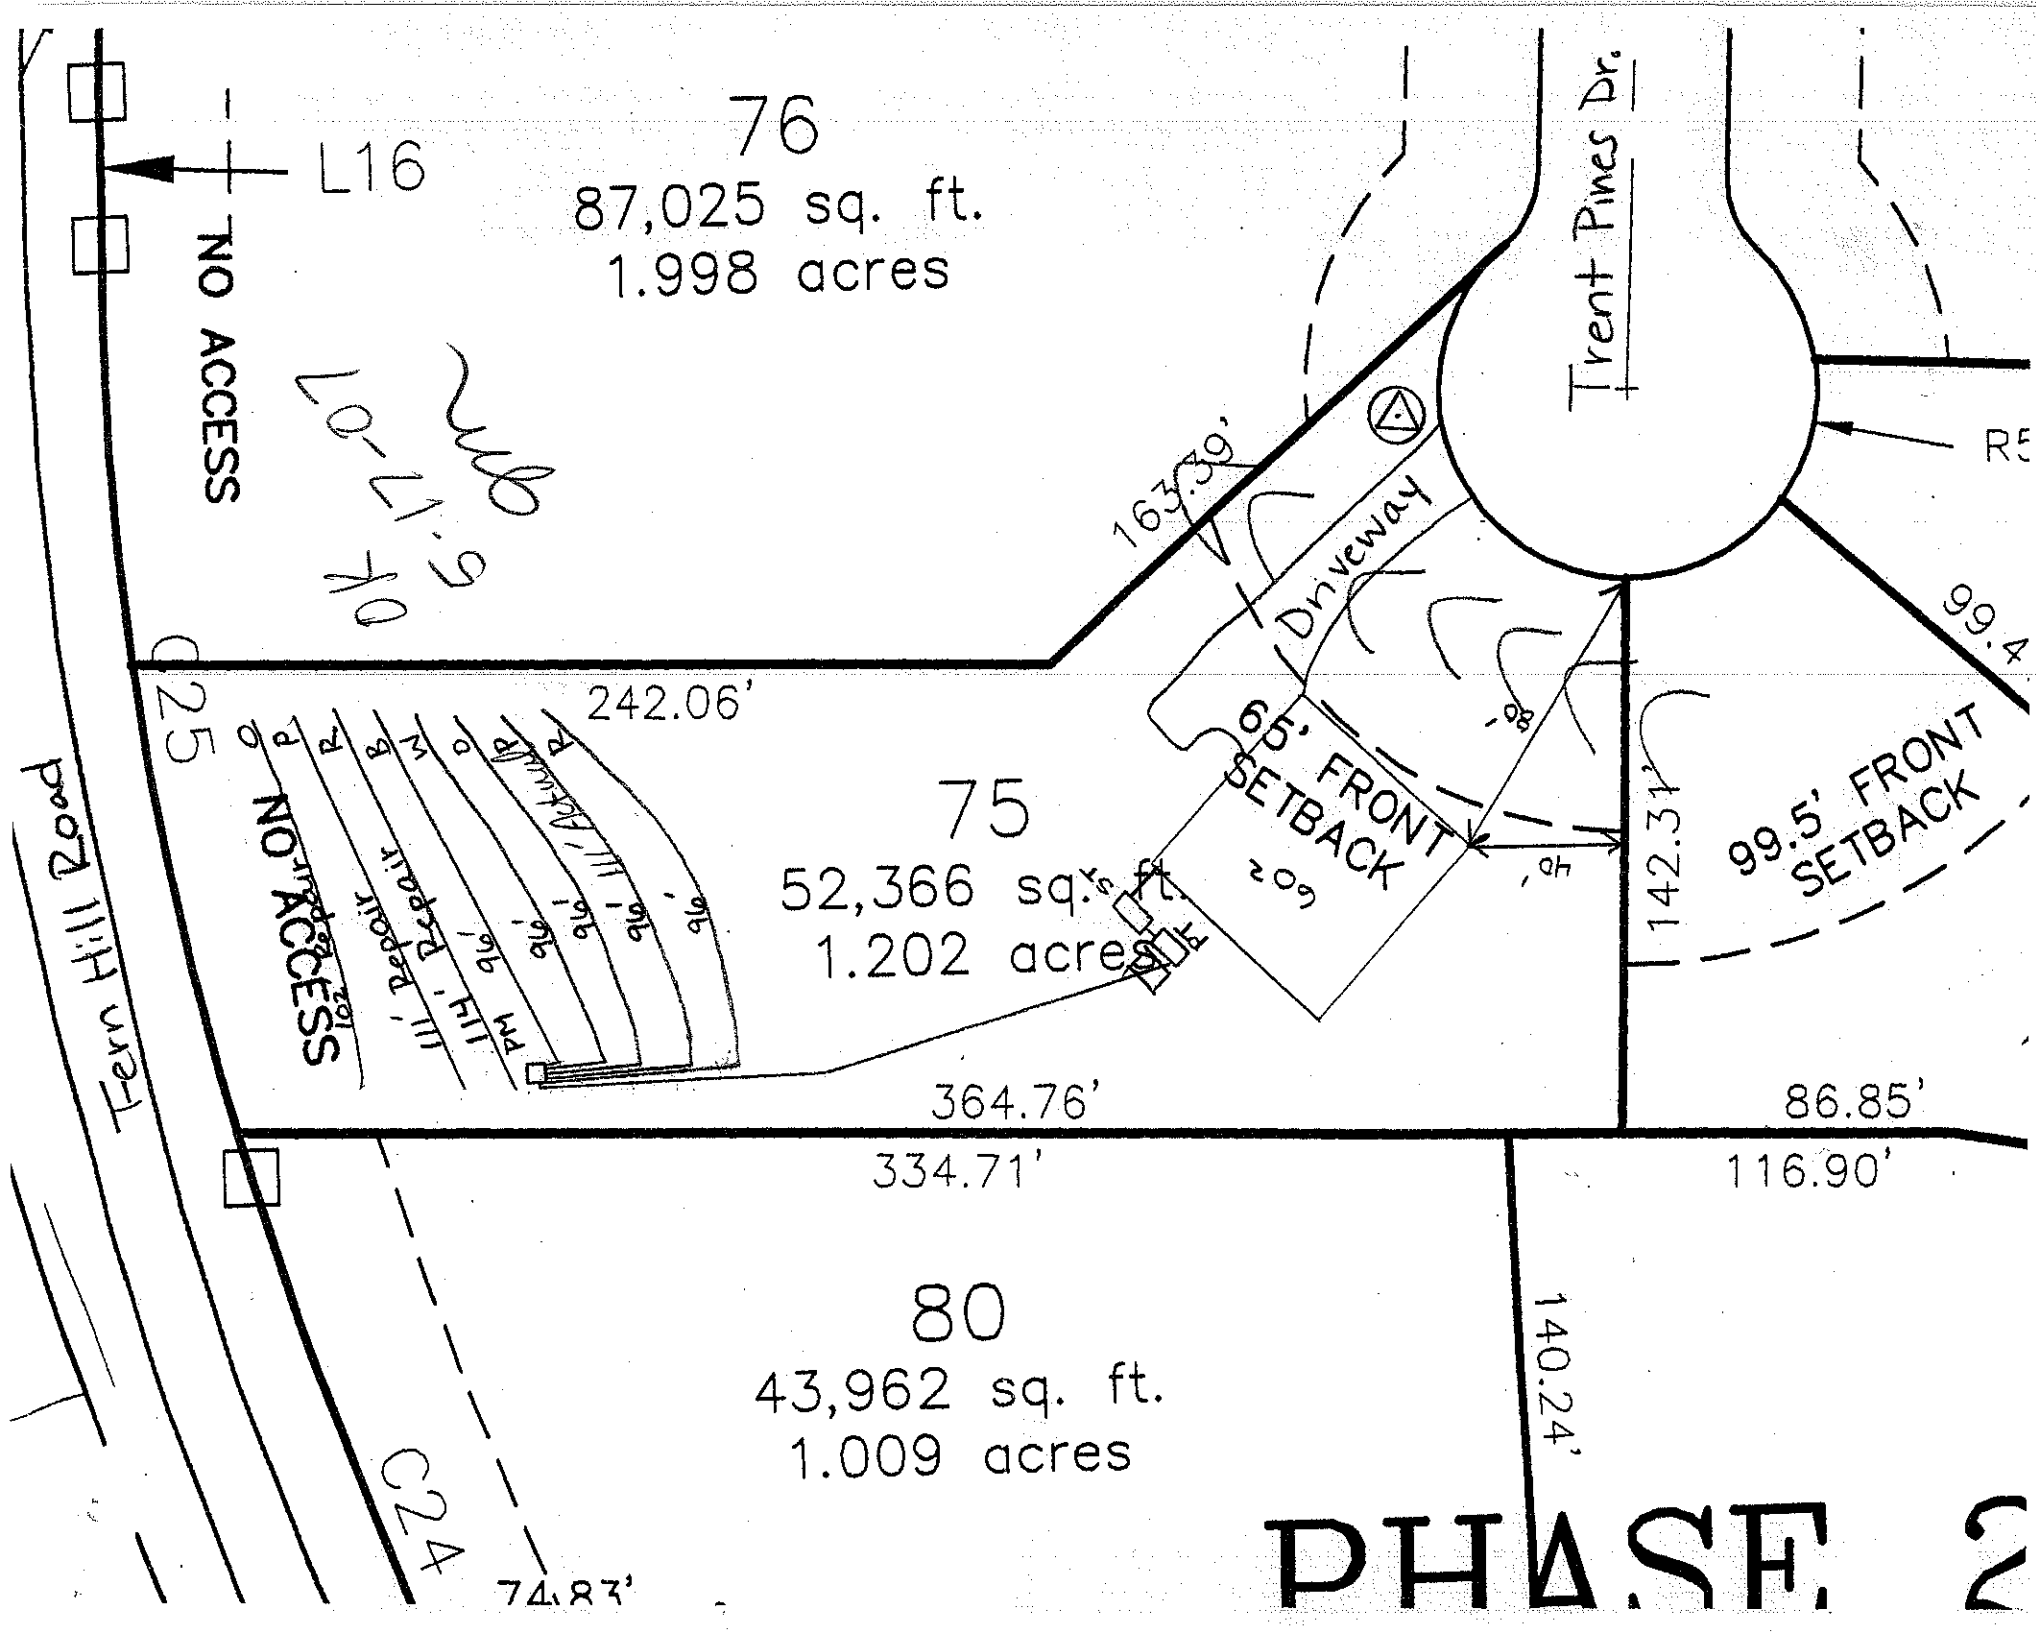
Permit can be suspended or revoked if any false information is supplied toward securing the permit/any unauthorized changes are made to the site/any unauthorized changes are made in the installation of the system. Improvement Permit with plat valid without expiration ☐ Improvement Permit with site plan valid for sixty months ☒ Authorization to Construct is valid for a period equal to that of Improvement Permit – not to exceed sixty months.

Signed: Karen M Davis date 6/12/07 Installed by: Bass Grading (Britt Bass)

Improvement Permit by: [signature] date 5-29-07 Operation Permit by: Marion Dotson RS date 12/17/14

Authorization to Construct by: [signature] date APPROVED APR 22 2014 Existing System Inspection by: date

HEALTH DEPT. COPY: WHITE OWNER COPY (FINAL): YELLOW OWNER COPY (INITIAL): PINK


76
87,025 sq. ft.
1.998 acres
L16
NO ACCESS
Trent Pines Dr.
163.39'
Driveway
242.06'
75
52,366 sq. ft.
1.202 acres
65' FRONT SETBACK
99.5' FRONT SETBACK
142.31'
99.4
NO ACCESS
Fern Hill Road
364.76'
334.71'
86.85'
116.90'
80
43,962 sq. ft.
1.009 acres
140.24'
C24
PHASE 2