*VOIDED By New Permit DATED 8/3/05 ✓ 1 30

IREDELL COUNTY HEALTH DEPARTMENT

STATESVILLE 704-878-5305 MOORESVILLE 704-664-5281

IMPROVEMENT PERMIT / AUTHORIZATION TO CONSTRUCT / OPERATION PERMIT / EXISTING SYSTEM INSPECTION

PERMIT# 19087 PIN# 4639-23-5078.023 DATE June 30, 04

OWNER OR CONTRACTOR Beacon Pt. Partners / Mark Ingle PHONE: Business Home

ADDRESS P.O. Box 3608 Mooresville, N.C. 28117

LOCATION North Rd N. TL Fern Hill TR Wolff Hill Dr. 1st Lot on left - corner lot

SUBDIVISION Beacon Pt. BLOCK / SECTION 4 LOT 23 LOT AREA 1.492 Ac SITE CLASS. PS DESIGN FLOW 480 gpd L.T.A.R. .025

Septic Tank: 1000 Gallons; STB Date

Pump Tank: 1000 Gallons; PT Date

Pump Make: Model Serial No.

Nitrification Field: No Fields 1 Square Feet 1500 Linear Feet 500

No Lines 5@100' Trench Width 36" Max Trench Bottom Depth 36" Gravel Depth N/A

☑ New System ☐ Repair System Type: I, II, III, IV, V, VI

System Description: Conv 25% Reduction

Repair System Description: LPPPBPS

Maintenance Agreement Required: ☐ Yes ☑ No Initially

☑ House/Mod. Home ☐ Mobile Home ☐ Business ☐ Other

No. Bedrooms 4 No. Bathrooms 4 No. Employees

☐ Slab ☑ Crawl Space ☐ Basement w/plumbing ☐ Basement w/plumbing

Water Supply: ☑ Individual ☐ Public ☐ Community


Comments:/Conditions:

A - 4" sch 80 pressure manifold, w/(6) ½" taps.


Comments:/Conditions:

1"=50'

INITIAL SITE SKETCH

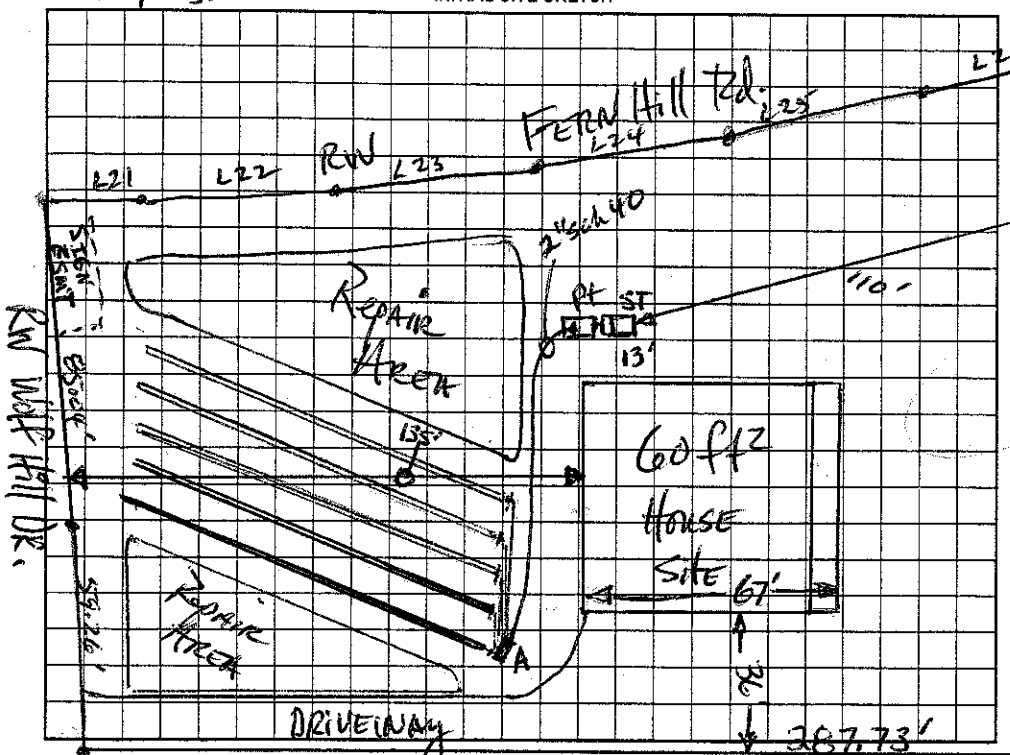

AS BUILT SKETCH

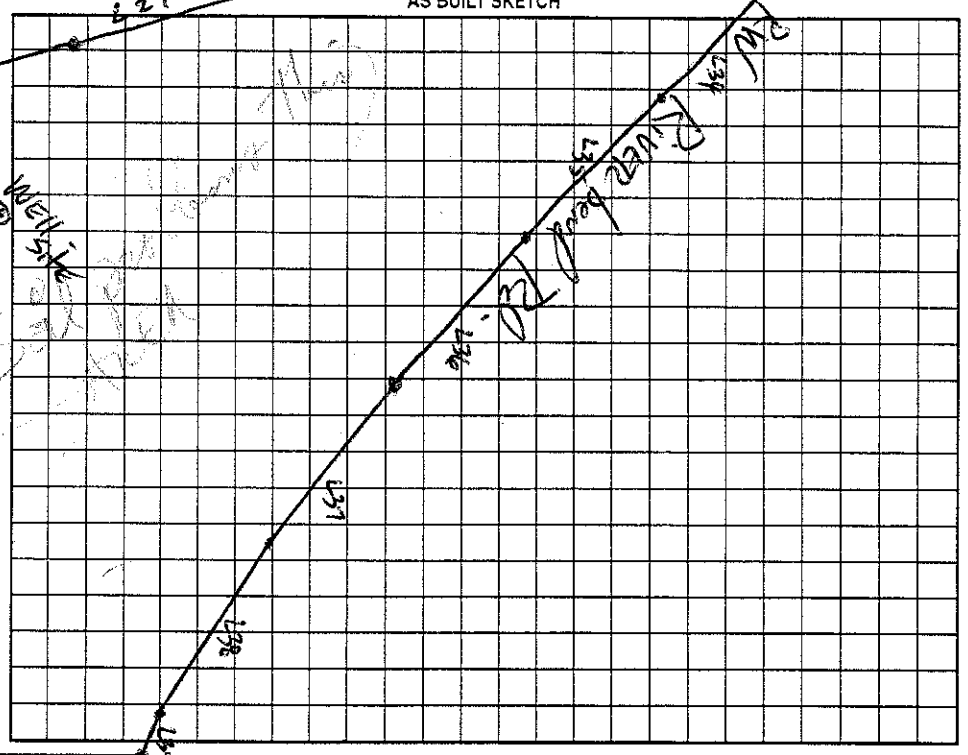

Permit can be suspended or revoked if any false information is supplied toward securing the permit/any unauthorized changes are made to the site/any unauthorized changes are made in the installation of the system. Improvement Permit with plat valid without expiration. Improvement Permit with site plan valid for sixty months. Authorization to Construct is valid for a period equal to that of Improvement Permit – not to exceed sixty months.

Signed: date 7-12-04 Installed by:

Improvement Permit by: date 6-30-04 Operation Permit by: date

Authorization to Construct by: date 4-7-05 Existing System Inspection by: date

HEALTH DEPT. COPY: WHITE OWNER COPY (FINAL): YELLOW OWNER COPY (INITIAL): PINK