IREDELL COUNTY HEALTH DEPARTMENT

STATESVILLE 704-878-5305 MOORESVILLE 704-664-5281

IMPROVEMENT PERMIT / AUTHORIZATION TO CONSTRUCT / OPERATION PERMIT / EXISTING SYSTEM INSPECTION

$1/10,00 Pd, cl 11:30

PERMIT# 119077 PIN# 4639 23 5078.015 4639-22-5542 DATE 10/1/06

OWNER OR APPLICANT Victoria Development PHONE: Business Home

ADDRESS 451 Isle of Pines Rd Mooresville NC 28117

LOCATION Perth, TL Fern Hill, TR Wolf Hill on Rt

SUBDIVISION Beacon Pt BLOCK / SECTION 4 LOT 15 LOT AREA 1.192Ac SITE CLASS PS DESIGN FLOW 480 L.T.A.R. 0.3

Septic Tank: 1000 Gallons: STB 825 Date 9-15-06

Pump Tank: Gallons; PT Date

Pump Make: Model Serial No.

Nitrification Field: No Fields 1 Square Feet 540 Linear Feet 270'

No Lines 6@45' Trench Width 24" Max Trench Bottom Depth 36" Gravel Depth —

☒ New System ☐ Repair ☐ Expansion System Type: I II (III) IV V VI

System Description: Gravity Panel Black

Repair System Description: Panel Black

Maintenance Agreement Required: ☐ Yes ☒ No

☒ Gravity ☐ Pressure ☐ Slab ☒ Crawl Space ☐ Basement w/plumbing ☐ Basement wo/plumbing

☒ House/Mod. Home ☐ Mobile Home ☐ Business ☐ Other


No. Bedrooms 4 No. Persons No. Employees

Water Supply: ☒ Individual ☐ Public ☐ Community

Comments:/Conditions:


1"=50'

INITIAL SITE SKETCH

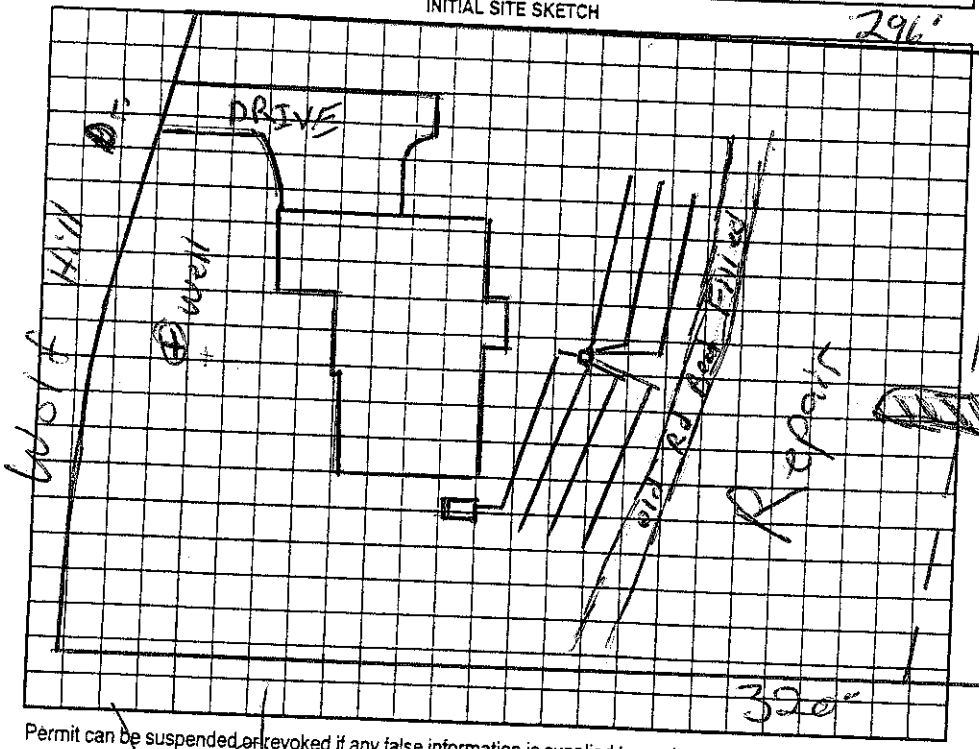

Comments:/Conditions:

AS BUILT SKETCH

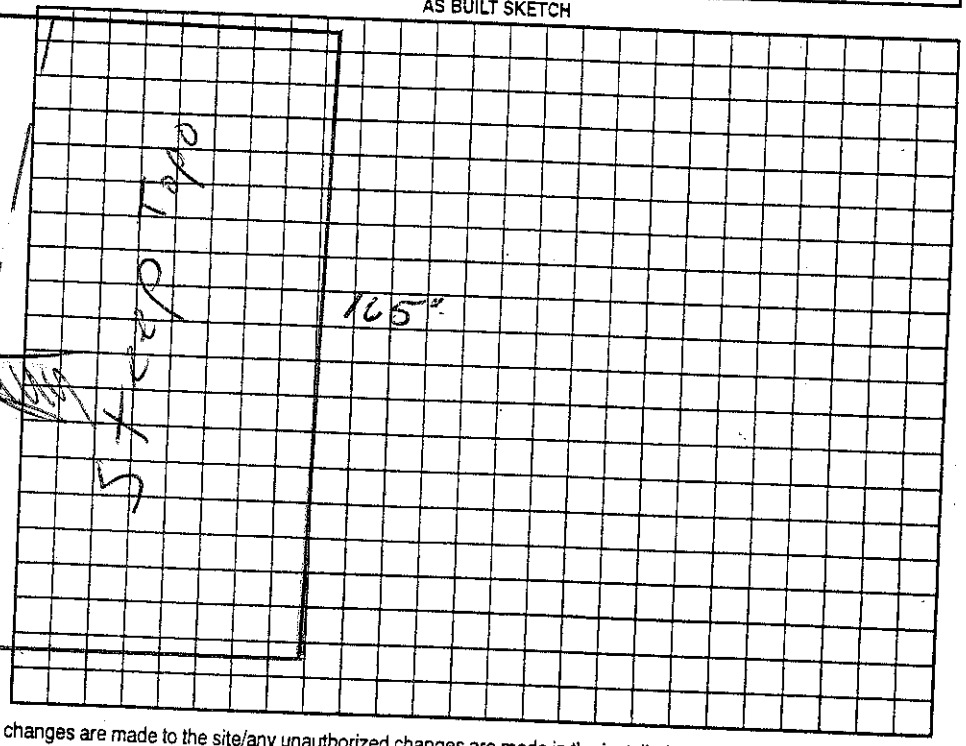

Permit can be suspended or revoked if any false information is supplied toward securing the permit/any unauthorized changes are made to the site/any unauthorized changes are made in the installation of the system. Improvement Authorization to Construct is valid for a period equal to that of Improvement Permit – not to exceed sixty months.

Permit with plat valid without expiration ☐ Improvement Permit with site plan valid for sixty months ☐

Signed:

Improvement Permit by: date 10/10/06

Authorization to Construct by: date 10/1/06

Installed by: Rowan Septic

Operation Permit by: Joh E. Alt date 11/3/06

Existing System Inspection by: date

HEALTH DEPT. COPY: WHITE OWNER COPY (FINAL): YELLOW OWNER COPY (INITIAL): PINK