3-30-4-30 ✓

IREDELL COUNTY HEALTH DEPARTMENT

STATESVILLE 704-878-5305 MOORESVILLE 704-664-5281

IMPROVEMENT PERMIT / AUTHORIZATION TO CONSTRUCT / OPERATION PERMIT / EXISTING SYSTEM INSPECTION

PERMIT# ~~14-243~~ 206763 PIN# 4639229371 DATE 6-4-07

OWNER OR APPLICANT Woodbridge Partners LLC PHONE: Business _____ Home _____

ADDRESS PO Box 3608 Mooresville NC 28117

LOCATION Perth Rd N TL Fern Hill TL Trent Pines on left

SUBDIVISION Woodleaf BLOCK / SECTION 2 LOT 66 LOT AREA .98 Ac SITE CLASS. PS DESIGN FLOW 480gpd L.T.A.R. .225 gpd/ft²

Septic Tank: 1000 Gallons; STB 760 Date 5-4-15
Pump Tank: 1000 Gallons; PT 363 Date 5-1-15
Pump Make: Gauses Model Wet/Tilt Serial No. _____
Nitrification Field: No Fields 1 Square Feet 1080 Linear Feet 360
No Lines 5 Trench Width 24" min Max Trench Bottom Depth 48" Gravel Depth NA ☐ Gravity ☒ Pressure ☐ Slab ☒ Crawl Space

☒ New System ☐ Repair ☐ Expansion System Type: I II III (IV) V VI
System Description: LP PPBPS
Repair System Description: LP PPBPS
Maintenance Agreement Required: ☒ Yes ☐ No

☒ House/Mod. Home No. Bedrooms 4
☐ Mobile Home No. Persons 8
☐ Business No. Employees ____
☐ Other _____

Water Supply: ☒ Individual ☐ Public ☐ Community

Basement w/plumbing ☐ Basement wo/plumbing

Comments/Conditions: Place tanks 50'+ from well
Install with extra sand (12") at 48" trench bottom
4/13/15 OK to run Supply line around other side (drive side) of house Must bury at least 30 inches under drive.
~~Drilled~~ 5/16" hole 3 inches in Lines
See Plan from SA ME
7/2/15 Checked tanks & 2 upper drain lines
7-6-15 CHECKED LOWER 3 LINES BA
7-7-15 CHECKED PLUMBING HOOKUPS BA
8/28/15 Set 2' Head Pressure
Electrical OK
Alarm OK
Maint. Contract OK

INITIAL SITE SKETCH

Comments/Conditions: House CHANGED TO CRAWL SPACE.
MAINTAIN AT LEAST 5' SEPERATION FROM SEPTIC REPAIR WITH HOUSE.
HOUSE WILL NOT EFFECT SEPTIC & WELL. SL

AS BUILT SKETCH

APPROVED NOV 03 2014

OK TO MOVE TANKS TO LEFT SIDE.
MOVED PLUMBING WHEN CHANGED FROM BASEMENT TO CRAWL. SL 6/12/15


Permit can be suspended or revoked if any false information is supplied toward securing the permit/any unauthorized changes are made to the site/any unauthorized changes are made in the installation of the system. Improvement Permit with plat valid without expiration ☐ Improvement Permit with site plan valid for sixty months ☒ Authorization to Construct is valid for a period equal to that of Improvement Permit – not to exceed sixty months.

Signed: Karen M Davis date 6/12/07 Installed by: Gunter Grading

Improvement Permit by: Melissa Melville date 6-4-07 Operation Permit by: _____ date 8/28/15

Authorization to Construct by: _____ date APPROVED NOV 03 2014 Existing System Inspection by: _____ date _____

HEALTH DEPT. COPY: WHITE OWNER COPY (FINAL): YELLOW OWNER COPY (INITIAL): PINK

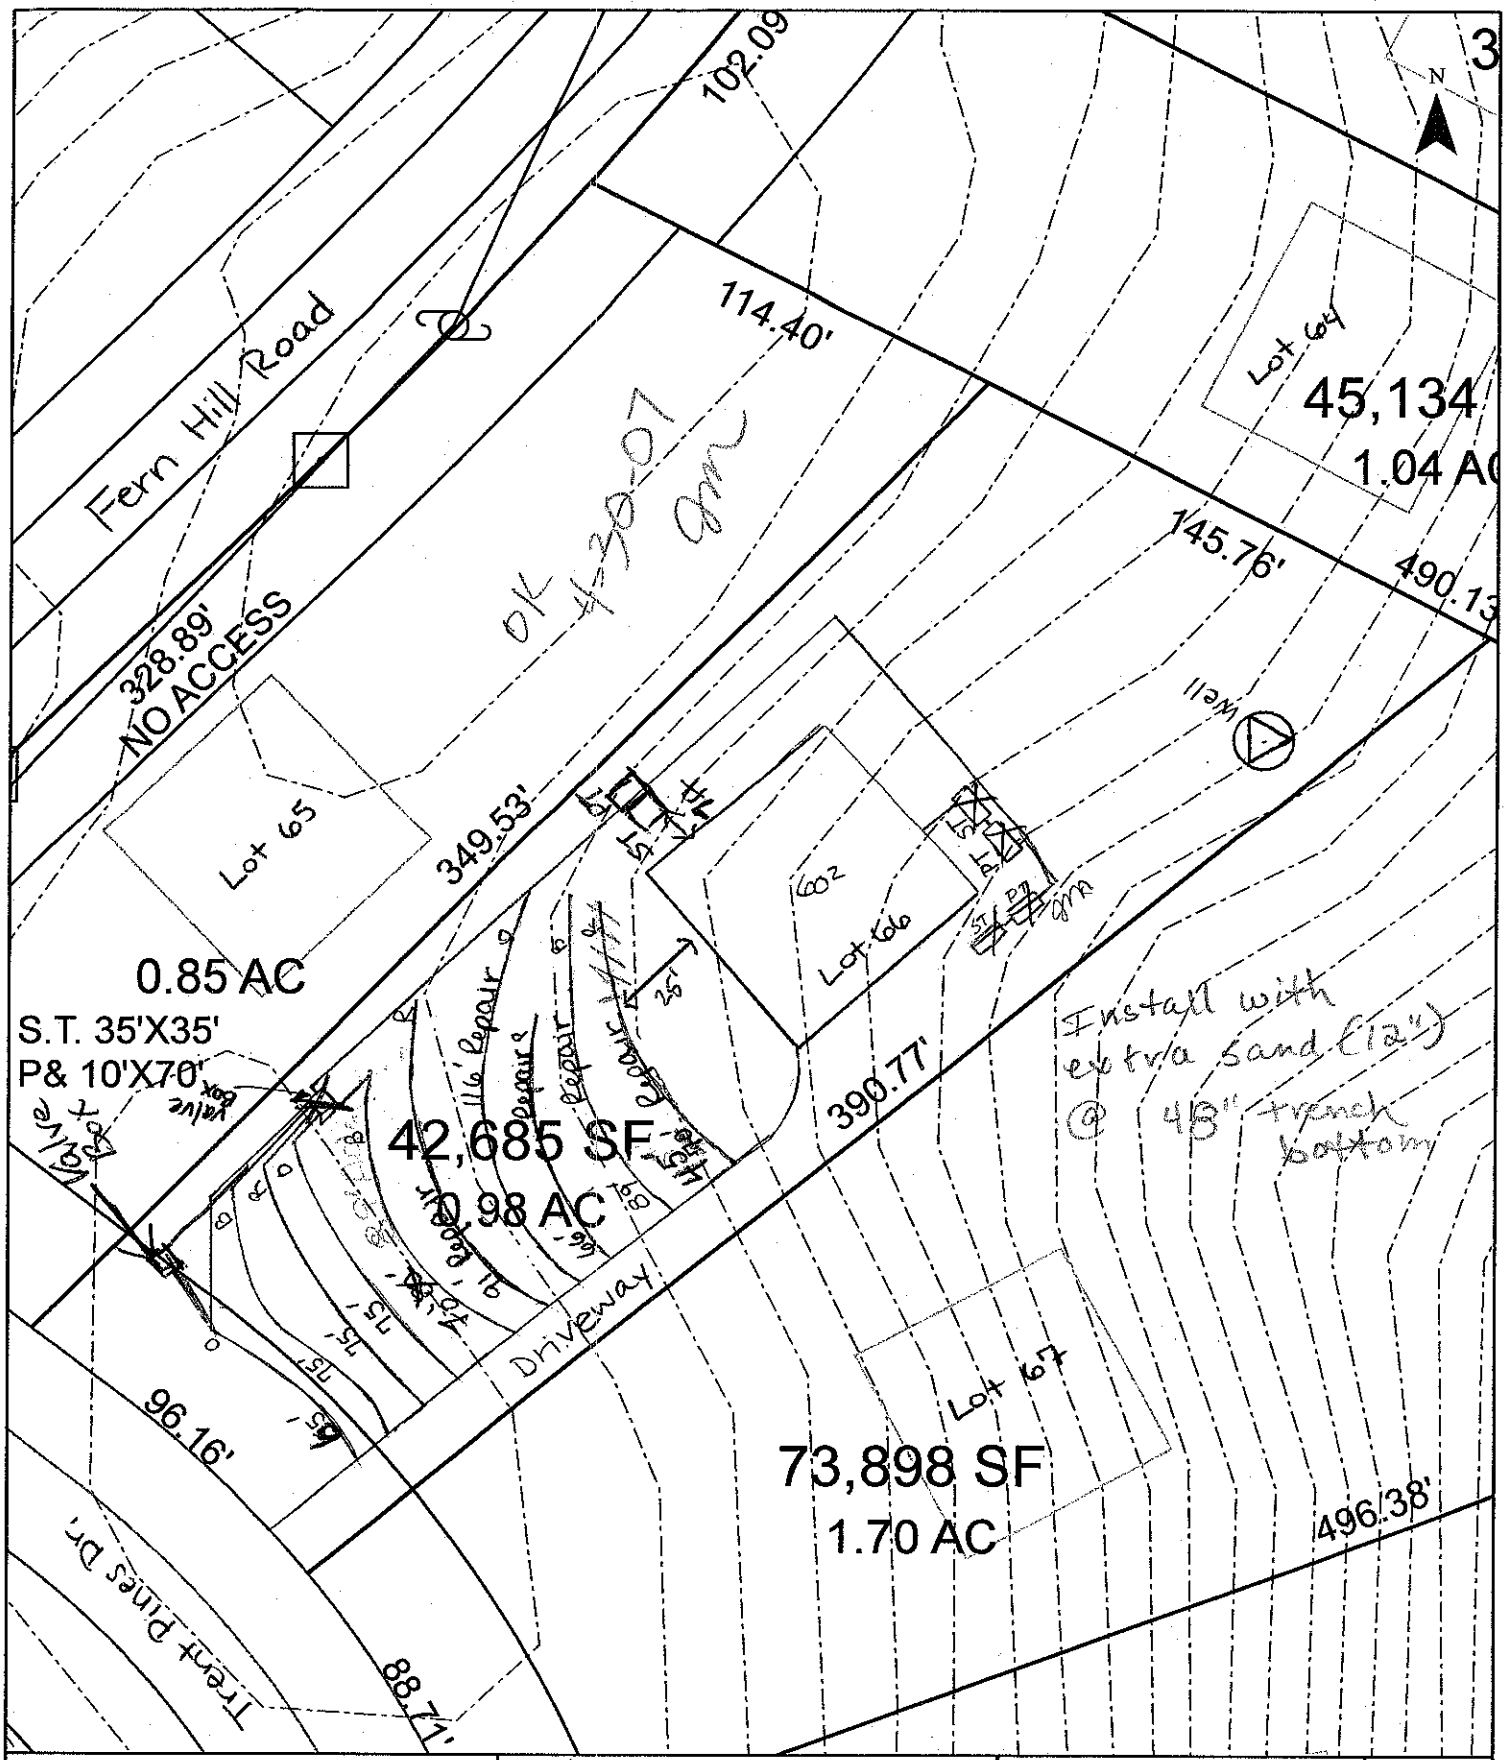

Scale: 1 inch equals 50 feet	S&ME	Woodleaf Phase 2	FIGURE
Drawn by: JBP		Lot 66	1
Reviewed by: PGP		Iredell County, NC	
Date: April, 2007	ENVIRONMENTAL SERVICES • ENGINEERING • TESTING	S&ME Project #1588-06-077	