130

IREDELL COUNTY HEALTH DEPARTMENT

STATESVILLE 704-878-5305 MOORESVILLE 704-664-5281

IMPROVEMENT PERMIT / AUTHORIZATION TO CONSTRUCT / OPERATION PERMIT / EXISTING SYSTEM INSPECTION

PERMIT# 119060 PIN# 4639-23-5078.000 4639-23-7434 DATE June 24, 04

OWNER OR CONTRACTOR Beacon Pt. Partners / Dreamworks Ent. Inc PHONE: Business Home

ADDRESS P.O. Box 3608, Mooresville N.C. 28117

LOCATION Perth Rd N. to Ferry Hill TR Frostcliff Ln. 4th lot on Right 122 Frostcliff Ln

SUBDIVISION Beacon Pt. BLOCK / SECTION 4 LOT 4 LOT AREA 1.468AC SITE CLASS. PS DESIGN FLOW 480gpd L.T.A.R. .3

Septic Tank: 1000 Gallons; STB 1012 Date 10/3/06

Pump Tank: 1000 Gallons; PT 17 Date 8/29/06

Pump Make: Gould's Model PVF-1012-HA Serial No. L0603422

Nitrification Field: No Fields 1 Square Feet 1200 Linear Feet 400

No Lines 5@80' Trench Width 36" Max Trench Bottom Depth 36"

☑ New System ☐ Repair System Type: I, II, III, IV, V, VI

System Description: pm 25% Reduction

Repair System Description: pm 25% Reduction

Maintenance Agreement Required: ☐ Yes ☐ No

☑ House/Mod. Home No. Bedrooms 4/4

☐ Mobile Home No. Bathrooms

☐ Business No. Employees

☐ Other

Gravel Depth NA ☐ Slab ☐ Crawl Space ☑ Basement w/plumbing ☐ Basement wo/plumbing

Water Supply: ☑ Individual ☐ Public ☐ Community


Comments:/Conditions:

100' minimum well/septic system separation required.


Comments:/Conditions:

INITIAL SITE SKETCH

1"=50'

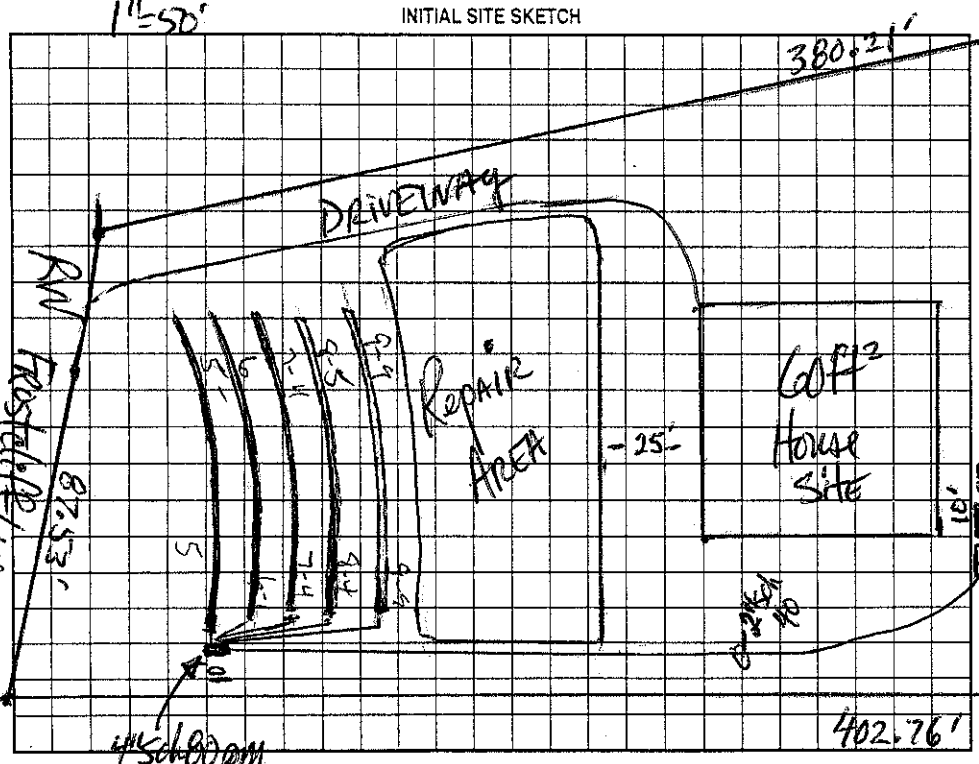

AS BUILT SKETCH

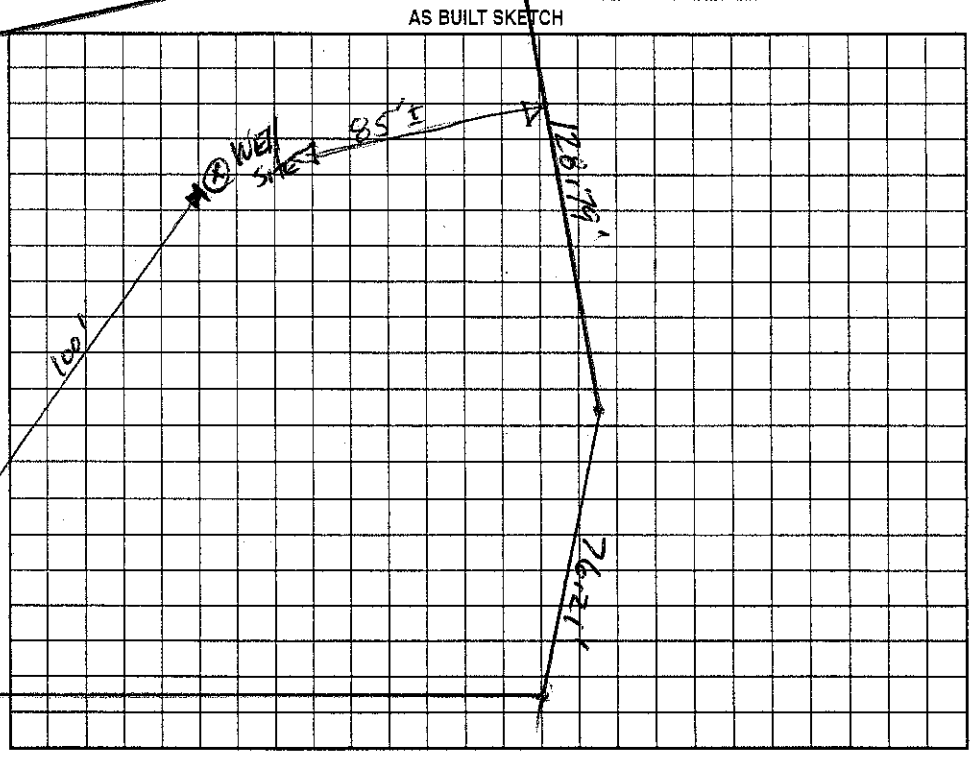

Permit can be suspended or revoked if any false information is supplied toward securing the permit/any unauthorized changes are made to the site/any unauthorized changes are made in the installation of the system. Improvement Permit with plat valid without expiration. Improvement Permit with site plan valid for sixty months. Authorization to Construct is valid for a period equal to that of Improvement Permit – not to exceed sixty months.

Signed: date 7-12-06 Installed by: Piedmont Backhoe Service

Improvement Permit by: RS date 6-24-04 Operation Permit by: Wesley Sparks R.S. date 2/16/07

Authorization to Construct by: RS date 8/25/06 Existing System Inspection by: date

HEALTH DEPT. COPY: WHITE OWNER COPY (FINAL): YELLOW OWNER COPY (INITIAL): PINK