2100

IREDELL COUNTY HEALTH DEPARTMENT

STATESVILLE 704-878-5305 MOORESVILLE 704-664-5281

IMPROVEMENT PERMIT / AUTHORIZATION TO CONSTRUCT / OPERATION PERMIT / EXISTING SYSTEM INSPECTION

PERMIT# Repair PIN# 4639-24-0590 DATE 9/26/2001

OWNER OR CONTRACTOR Bill Onsrud PHONE: Business Home 704 528-3748

ADDRESS 353 Marietta Mooresville, NC 28117

LOCATION Perth Rd TL Fern Hill TR Marietta just before Bullfinch

SUBDIVISION Beacon Pt BLOCK / SECTION II LOT 8 LOT AREA SITE CLASS. PS DESIGN FLOW 360gpd T.A.R.

Septic Tank: 1600 Gallons; STB Date

Pump Tank: 1000 Gallons; PT Date

Pump Make: Model Serial No.

Nitrification Field: No Fields 1 Square Feet 240 Linear Feet 80'

No Lines 1 Trench Width 36" Max Trench Bottom Depth 30" Gravel Depth N/A

☐ New System ☒ Repair System Type: I, II, III, IV, V, VI

System Description: Pump-Panel

Repair System Description: Same

Maintenance Agreement Required: ☒ Yes ☐ No

☐ House/Mod. Home No. Bedrooms 3

☐ Mobile Home No. Bathrooms 2.5

☐ Business No. Employees

☐ Other


☐ Slab ☒ Crawl Space ☐ Basement w/plumbing ☐ Basement wo/plumbing

Water Supply: ☐ Individual ☒ Public ☐ Community


Comments:/Conditions: Install 1-Panel line = 80' shut off valve to lowest Existing line.

Comments:/Conditions: Lowest Line cut off - 240 feet of Panel

INITIAL SITE SKETCH

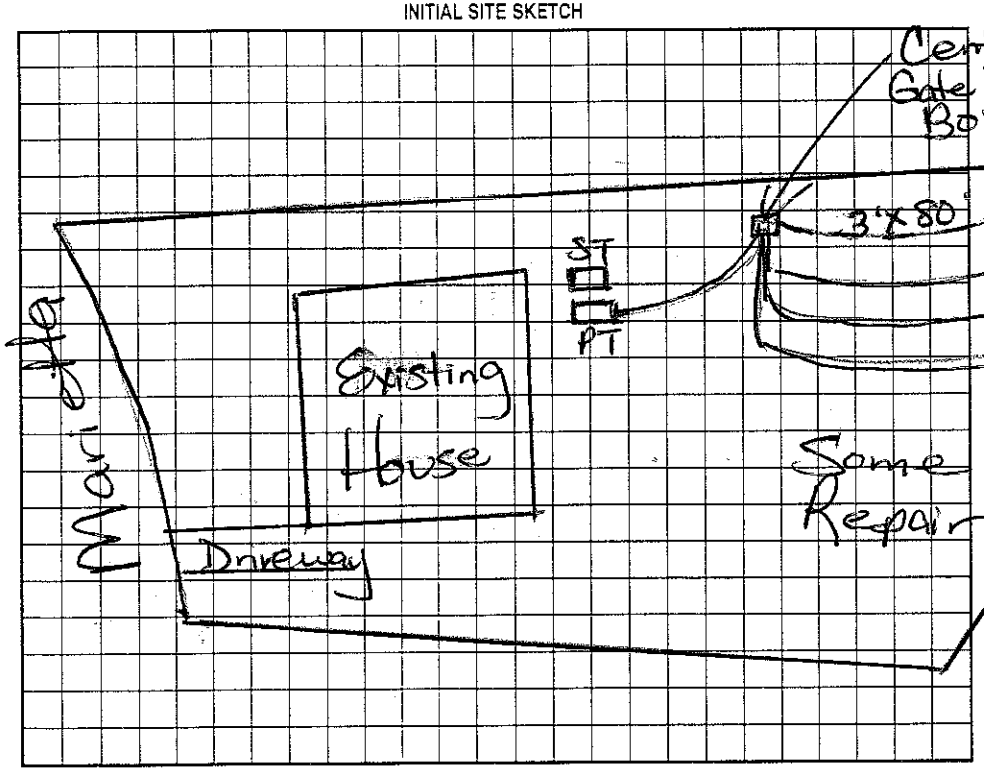

AS BUILT SKETCH

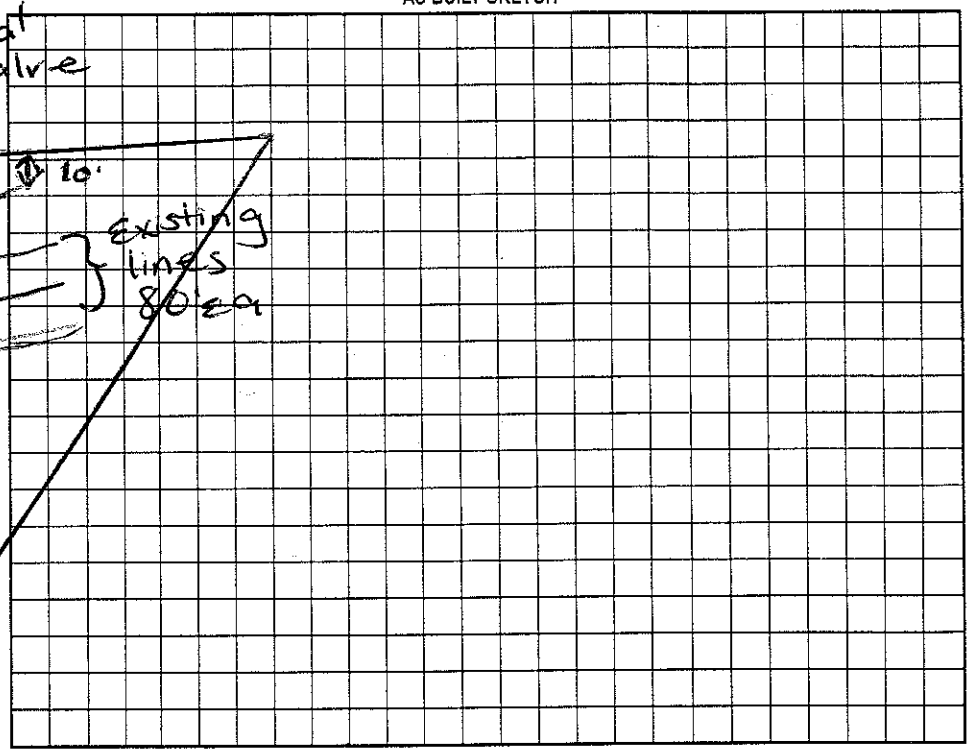

Permit can be suspended or revoked if any false information is supplied toward securing the permit/any unauthorized changes are made to the site/any unauthorized changes are made in the installation of the system. Improvement Permit with plat valid without expiration. Improvement Permit with site plan valid for sixty months. Authorization to Construct is valid for a period equal to that of Improvement Permit – not to exceed sixty months.

Signed: [signature] date 9/26/2001 Installed by: Reid Eudy

Improvement Permit by: Maria H. Hodgson RS date 9/26/2001 Operation Permit by: Wesley Sparks RS. date 9/28/01

Authorization to Construct by: Maria H. Hodgson RS date 9/26/2001 Existing System Inspection by: date

Repair

HEALTH DEPT. COPY: WHITE OWNER COPY (FINAL): YELLOW OWNER COPY (INITIAL): PINK

IREDELL COUNTY HEALTH DEPARTMENT

STATESVILLE 704-878-5305 MOORESVILLE 704-664-5281

IMPROVEMENT PERMIT / AUTHORIZATION TO CONSTRUCT / OPERATION PERMIT / EXISTING SYSTEM INSPECTIO

PERMIT# ~~[illegible]~~ 081655 PIN# 4639 24~~47~~96 0590 DATE 5/28/99

OWNER OR CONTRACTOR Crescent Resources PHONE: Business 663-6905 Home

ADDRESS P.O. Box 1003 Charlotte NC 28201 353 Marietta

LOCATION Perth Rd. TR Fern Hill TR Marrietta Rd lot on left

SUBDIVISION Beacon Point BLOCK / SECTION II LOT 8 LOT AREA .773 Acre SITE CLASS. PS DESIGN FLOW 360gpd L.T.A.R. .25-3

Septic Tank: 1000 Gallons; STB 794 Date 12-5-99
Pump Tank: 1000 Gallons; PT 27 Date 3-1-00
Pump Make: Zoeller Model N98 Serial No.
Nitrification Field: No Fields 1 Square Feet 720' Linear Feet 240'
No Lines 3 at 80' Trench Width 36" Max Trench Bottom Depth 30" Gravel Depth N/A

[X] New System [ ] Repair System Type: I, II, III, IV, V, VI
System Description: Pump-LPP- Panel Blk
Repair System Description: Same
Maintenance Agreement Required: [X] Yes [ ] No


[X] House/Mod. Home [ ] Mobile Home [ ] Business [ ] Other
No. Bedrooms 3 No. Bathrooms 3 No. Employees
[ ] Slab [ ] Crawl Space [ ] Basement w/plumbing [ ] Basement wo/plumbing

Water Supply: [ ] Individual [X] Public [X] Community


Comments:/Conditions: Keep Septic System at least 10' From PL & 5' from ~~bath~~ house.

Comments:/Conditions: Reviewed building plans 1/24/2000. Trenches checked, Tanks checked 5/18/2000

INITIAL SITE SKETCH Scale 1:50

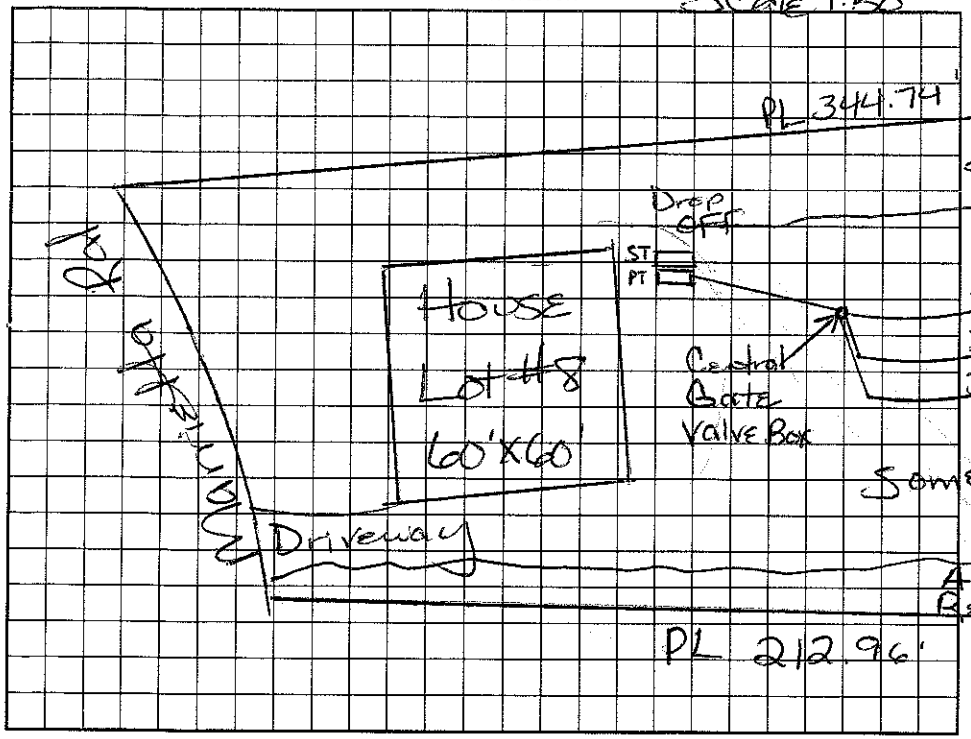

AS BUILT SKETCH

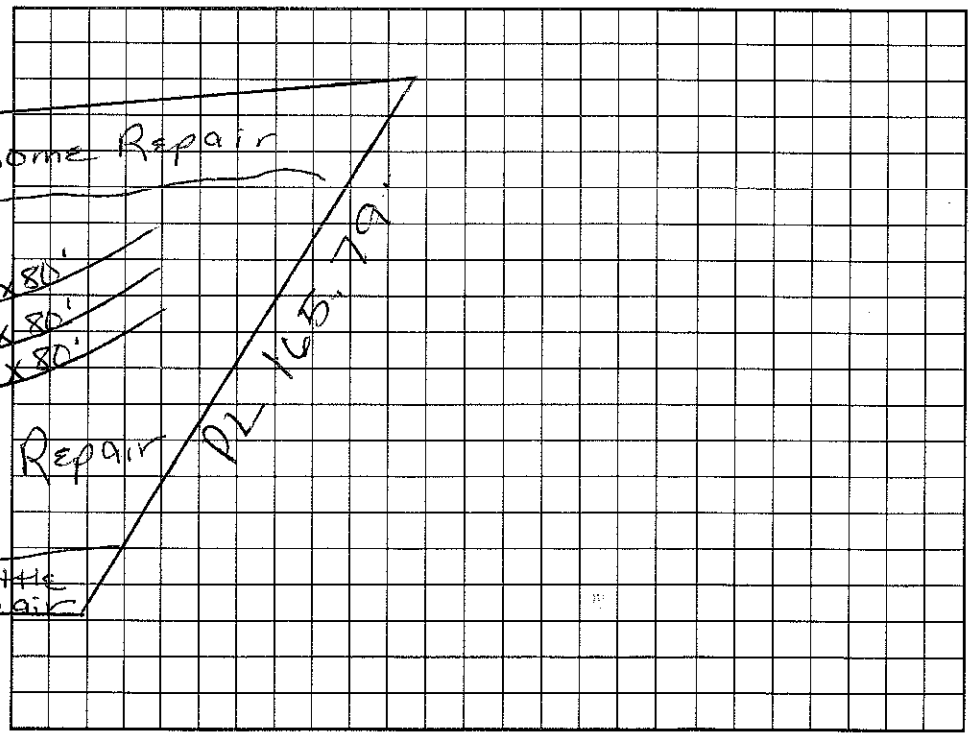

Permit can be suspended or revoked if any false information is supplied toward securing the permit/any unauthorized changes are made to the site/any unauthorized changes are made in the installation of the system. Improvement Permit with plat valid without expiration. Improvement Permit with site plan valid for sixty months. Authorization to Construct is valid for a period equal to that of Improvement Permit – not to exceed sixty months.

Signed: [signature] date 5-25-99 Installed by: Reade Eudy (704) 201-7039

Improvement Permit by: Maria H. Dotson date 5/28/99 Operation Permit by: Wesley Sparks R.S. date 6/15/00

Authorization to Construct by: Maria H. Dotson date 1/24/2000 Existing System Inspection by: date

HEALTH DEPT. COPY: WHITE OWNER COPY (FINAL): YELLOW OWNER COPY (INITIAL): PINK