# IREDELL COUNTY HEALTH DEPARTMENT

STATESVILLE 704-878-5305 MOORESVILLE 704-664-5281

## IMPROVEMENT PERMIT / AUTHORIZATION TO CONSTRUCT / OPERATION PERMIT / EXISTING SYSTEM INSPECTION

50.00 Pd 8/26/05

PERMIT# 114966 / 126972 PIN# 4639-23-5078.4 4639242076 DATE 8/26/05

OWNER OR CONTRACTOR Beacon Pt Partners PHONE: Business Home

ADDRESS PO Box 3658 Mooresville NC 28117

LOCATION Perth, TL Fern Hill, TR Bull Finch, TL Fox Hunt on Rt

SUBDIVISION Beacon Pt BLOCK / SECTION 3 LOT 4/4A LOT AREA 1.545AC. SITE CLASS. FS DESIGN FLOW 480 L.T.A.R. 0.3

Septic Tank: 1000 Gallons; STB ~~1500~~ Date 8/9/05

Pump Tank: 1000 Gallons; PT 302 Date 11/29/05

Pump Make: Zoeller Model N163 Serial No.

Nitrification Field: No Fields 1 Square Feet 1200 Linear Feet 400

No Lines 3@134' Trench Width 36" Max Trench Bottom Depth 36" Gravel Depth —

☒ New System ☐ Repair System Type: I, II, III, IV, V, VI

System Description: Pump 25% Reduct.

Repair System Description: Same

Maintenance Agreement Required: ☐ Yes ☒ No

☒ House/Mod. Home No. Bedrooms 4

☐ Mobile Home No. Bathrooms

☐ Business No. Employees

☐ Other


☐ Slab ☐ Crawl Space ☑ Basement w/plumbing ☐ Basement wo/plumbing

Water Supply: ☒ Individual ☐ Public ☐ Community

Comments:/Conditions:

1"=60'


INITIAL SITE SKETCH

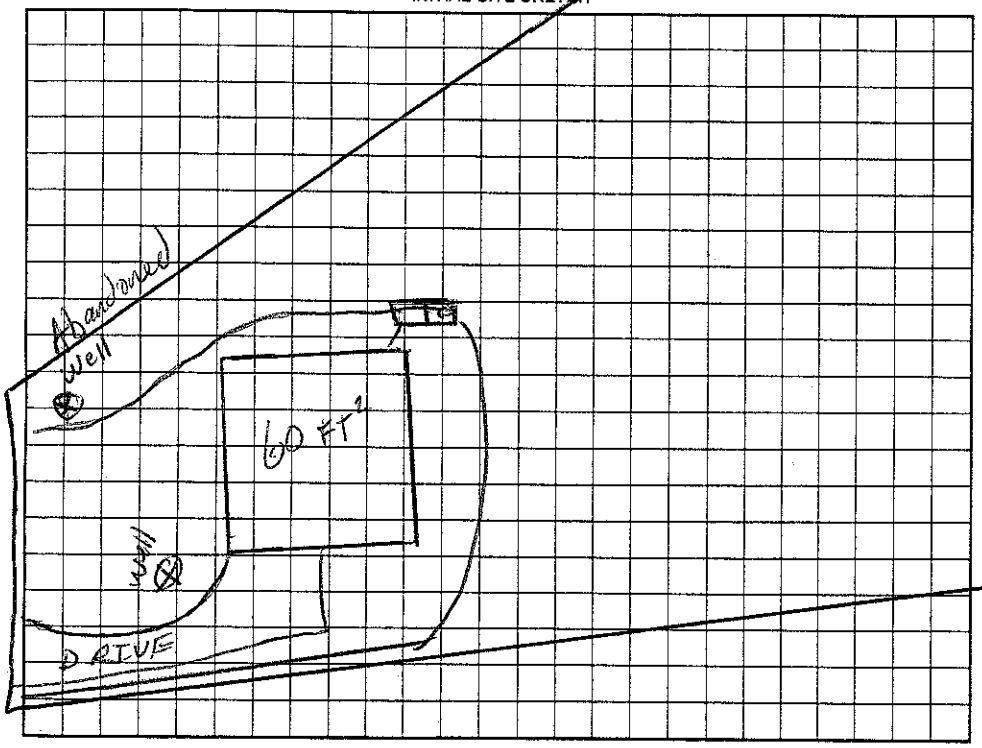


Comments:/Conditions:

Quick 4 Installed

AS BUILT SKETCH

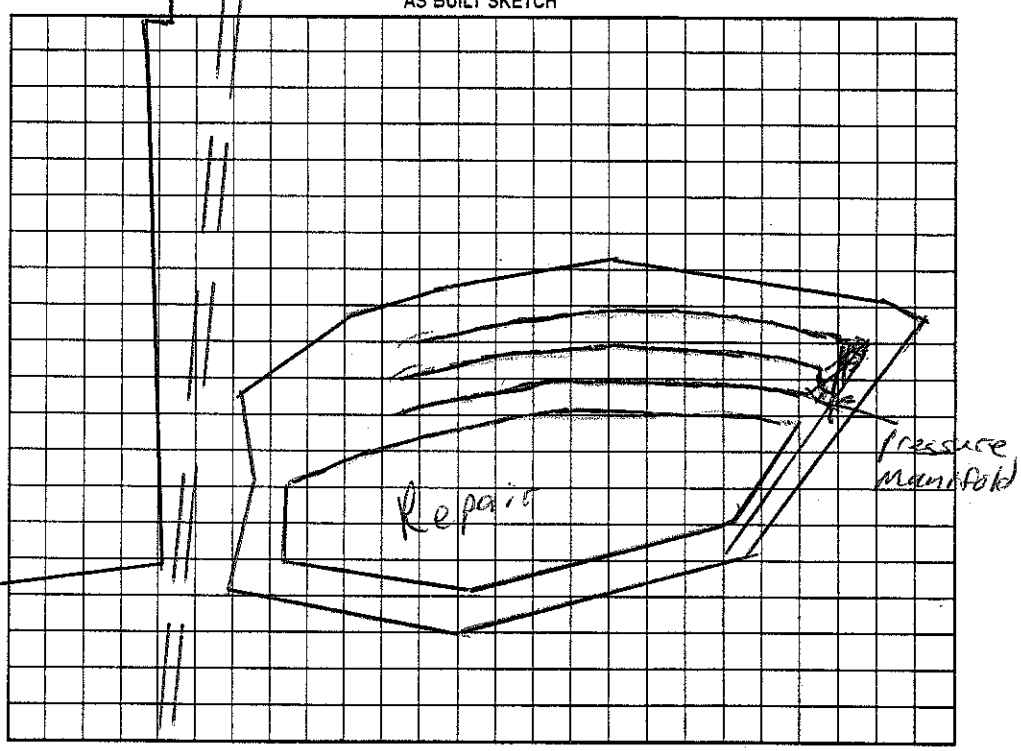


Permit can be suspended or revoked if any false information is supplied toward securing the permit/any unauthorized changes are made to the site/any unauthorized changes are made in the installation of the system. Improvement Permit with plat valid without expiration. Improvement Permit with site plan valid for sixty months. Authorization to Construct is valid for a period equal to that of Improvement Permit – not to exceed sixty months.

Signed: John Tinkham date 08/29/05 Installed by: Rowan Septic

Improvement Permit by: RS date 8/26/05 Operation Permit by: RS date 5/2/06

Authorization to Construct by: RS date 8/26/05 Existing System Inspection by: date

HEALTH DEPT. COPY: WHITE OWNER COPY (FINAL): YELLOW OWNER COPY (INITIAL): PINK