IREDELL COUNTY HEALTH DEPARTMENT

STATESVILLE 704-878-5305 MOORESVILLE 704-664-5281

IMPROVEMENT PERMIT / AUTHORIZATION TO CONSTRUCT / OPERATION PERMIT / EXISTING SYSTEM INSPE

N

PERMIT# 081653 PIN# 4639 24 34 07 664-6096 DATE 5/27

OWNER OR CONTRACTOR Crescent Resources/John White PHONE: Business 663-6905 Home

ADDRESS P.O. Box 1003 Charlotte, NC 28201

LOCATION Perth Rd TL Fern Hill TR Bullfinch DN RT

SUBDIVISION Beacon Point BLOCK / SECTION II LOT 7 LOT AREA .953 Acre SITE CLASS. PS DESIGN FLOW 480 gpd L.T.A.R. .4

Septic Tank: 1000 Gallons; STB Date

Pump Tank: Gallons; PT Date

Pump Make: Model Serial No.

Nitrification Field: No Fields 1 Square Feet 1200' Linear Feet 400'

No Lines 4 at 100' Trench Width 36" Max Trench Bottom Depth Gravel Depth 12"

☒ New System ☐ Repair System Type: I, II, III, IV, V, VI

System Description: Gravity - Conventional

Repair System Description: Grav. - 25% Reduction

Maintenance Agreement Required: ☐ Yes ☒ No

☒ House/Mod. Home ☐ Mobile Home ☐ Business ☐ Other

No. Bedrooms 4 No. Bathrooms 4 No. Employees


☐ Slab ☒ Crawl Space ☐ Basement w/plumbing ☐ Basement wo/plumbing

Water Supply: ☐ Individual ☒ Public ☒ Community


Comments/Conditions: Old Road bed in house location must be filled for Gravity Flow System, if any grading done to lot, System will have to be pumped

Comments:/Conditions:

INITIAL SITE SKETCH

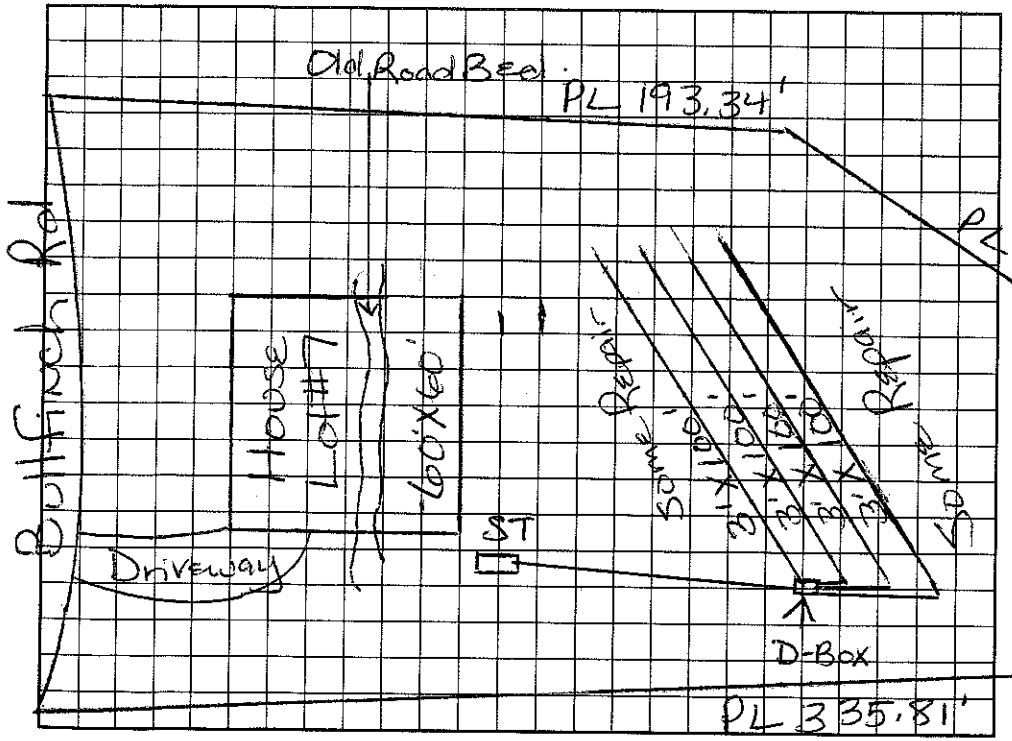

AS BUILT SKETCH

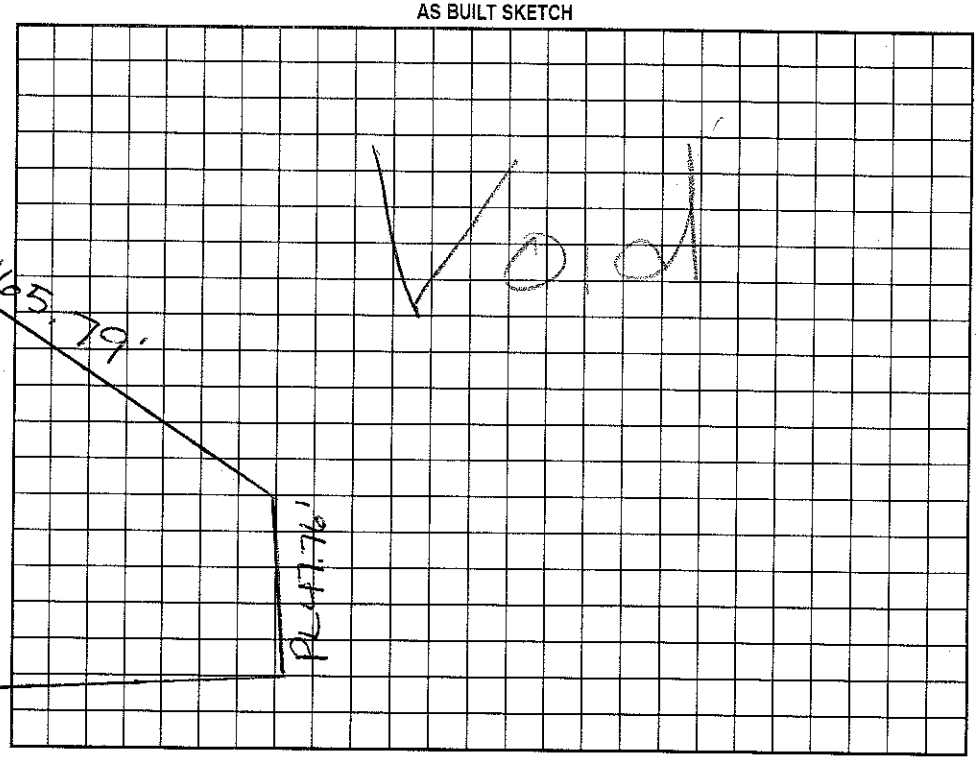

Permit can be suspended or revoked if any false information is supplied toward securing the permit/any unauthorized changes are made to the site/any unauthorized changes are made in the installation of the system. Improvement Permit with plat valid without expiration. Improvement Permit with site plan valid for sixty months. Authorization to Construct is valid for a period equal to that of Improvement Permit – not to exceed sixty months.

Signed: Tony Jacobs date 6/2/99

Improvement Permit by: Marion H. Watson RS date 5/27/99

Authorization to Construct by: date

Installed by:

Operation Permit by: date

Existing System Inspection by: date

HEALTH DEPT. COPY: WHITE OWNER COPY (FINAL): YELLOW OWNER COPY (INITIAL): PINK