$130

IREDELL COUNTY HEALTH DEPARTMENT

STATESVILLE 704-878-5305 MOORESVILLE 704-664-5281

IMPROVEMENT PERMIT / AUTHORIZATION TO CONSTRUCT / OPERATION PERMIT / EXISTING SYSTEM INSPECTION

PERMIT# 114965 PIN# 4639-23-5078.3 4639244107 DATE Dec 17, 03

OWNER OR CONTRACTOR Beacon Point Partners / VICTORIA DEVELOPMENT PHONE: Business _____ Home _____

ADDRESS P.O. Box 3608 Mooresville, N.C. 28117

LOCATION Peeth Rd. N. TL FERN Hill TR Bullfinch TL Fox Hunt Ct. on Right

SUBDIVISION Beacon Point BLOCK / SECTION 3 LOT 3/3A LOT AREA 1.34Ac +.354Ac SITE CLASS. PS SFE3A DESIGN FLOW 480gpd L.T.A.R. .3 SFE 3A

Septic Tank: 1000 Gallons; STB 825 Date 3/9/05
Pump Tank: 1000 Gallons; PT 302 Date 11/29/05
Pump Make: Zoeller Model 4976-7 & 34.37 Serial No N163
Nitrification Field: No Fields 1 Square Feet 1200 Linear Feet 400
No Lines 3 Trench Width 36" Max Trench Bottom Depth 36" Gravel Depth N/A

☑ New System ☐ Repair System Type: I, II, III, IV, V, VI
System Description: pm - 25% Reduction
Repair System Description: pm - 25% Reduction
Maintenance Agreement Required: ☐ Yes ☑ No

☑ House/Mod. Home No. Bedrooms 4
☐ Mobile Home No. Bathrooms 4
☐ Business No. Employees ____
☐ Other ____


☐ Slab ☐ Crawl Space ☑ Basement w/plumbing ☐ Basement wo/plumbing

Water Supply: ☑ Individual ☐ Public ☐ Community


Comments:/Conditions:

Comments:/Conditions: 3/10/05 Plans meet essential requirements

INITIAL SITE SKETCH 1"=60'

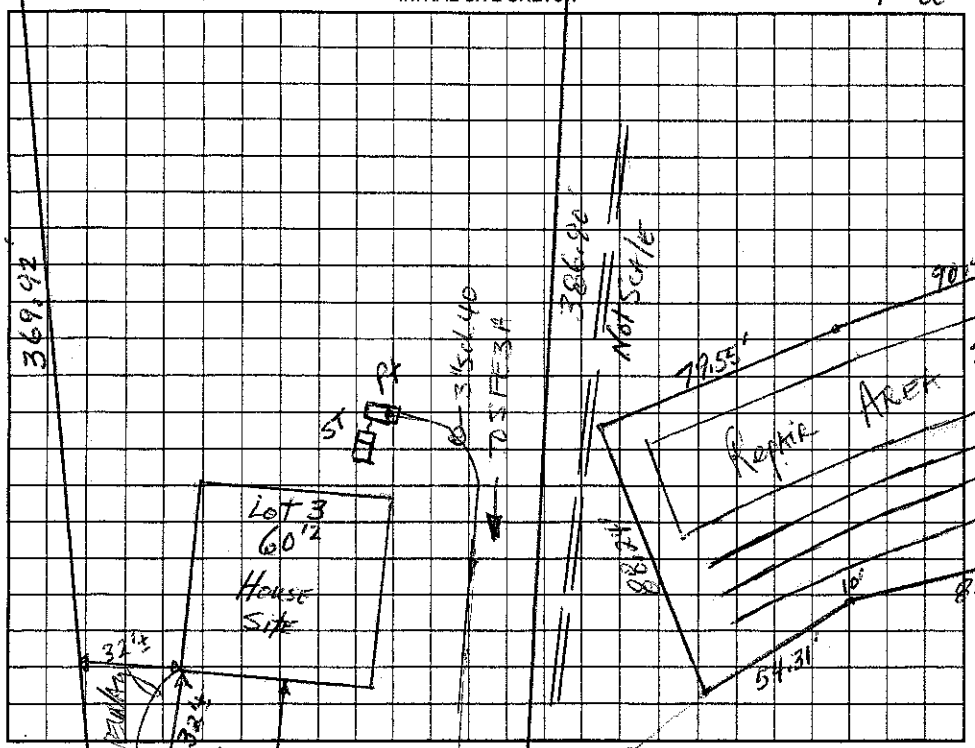

AS BUILT SKETCH

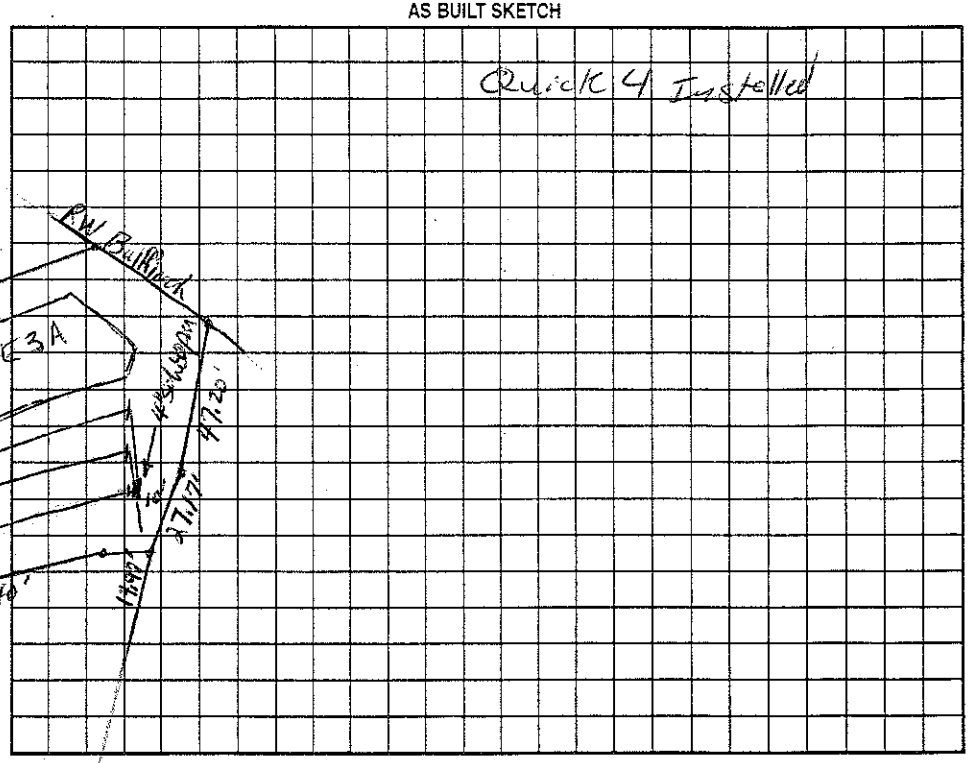

Permit can be suspended or revoked if any false information is supplied toward securing the permit/any unauthorized changes are made to the site/any unauthorized changes are made in the installation of the system. Improvement Permit with plat valid without expiration. Improvement Permit with site plan valid for sixty months. Authorization to Construct is valid for a period equal to that of Improvement Permit – not to exceed sixty months.

Signed: _____ date 1-9-05 Installed by: Rowan Septic

Improvement Permit by: _____ date Dec 17, 03 Operation Permit by: Andy Mitchell date 8-22-06

Authorization to Construct by: 134.12' Wesley Sparks R.S. date 3/10/05 Existing System Inspection by: _____ date _____

HEALTH DEPT. COPY: WHITE OWNER COPY (FINAL): YELLOW OWNER COPY (INITIAL): PINK