IREDELL COUNTY HEALTH DEPARTMENT

STATESVILLE 704-878-5305 MOORESVILLE 704-664-5281

Yard 50.00 Redraw

IMPROVEMENT PERMIT / AUTHORIZATION TO CONSTRUCT / OPERATION PERMIT / EXISTING SYSTEM INSPECTION

PERMIT# 078838 PIN# 4639245535

OWNER OR CONTRACTOR Crescent Resources / Ray Short PHONE: Business 664-1010 DATE 4/14/2000

ADDRESS P.O. Box 1003 Charlotte, NC 28201 Home ~~Ray Short~~ 2025555568

LOCATION Perth Rd TL Fern Hill TR Bullfinch on Rt.

SUBDIVISION Beacon Pt BLOCK / SECTION II LOT 5 LOT AREA .721 Acre SITE CLASS. RS DESIGN FLOW 360gpd L.T.A.R. .3

Septic Tank: 1000 Gallons; STB 825 Date 6-19-00

Pump Tank: 1000 Gallons; PT 302 Date 7-11-60

Pump Make: Zoeller Model N137-C Serial No. 137-0002

Nitrification Field: No Fields 1 Square Feet 900' Linear Feet 300'

No Lines 3 at 100' Trench Width 36" Max Trench Bottom Depth 24-36" Gravel Depth N/A

☒ New System ☐ Repair System Type: I, II, III, IV, V, VI

System Description: Pump-PM-25% Reduction

Repair System Description: Pump-Innovative

Maintenance Agreement Required: ☒ Yes ☐ No

☒ House/Mod. Home ☐ Mobile Home ☐ Business ☐ Other

No. Bedrooms 3 No. Bathrooms 3 No. Employees


Water Supply: ☐ Individual ☒ Public ☒ Community

☐ Slab ☒ Crawl Space ☐ Basement w/plumbing ☐ Basement wo/plumbing


Comments:/Conditions: Keep Septic System at least 10' from PL & 5' from house

Comments:/Conditions: Tanks & lines checked MD Press, Elect & alarm checked

INITIAL SITE SKETCH Scale 1:50'

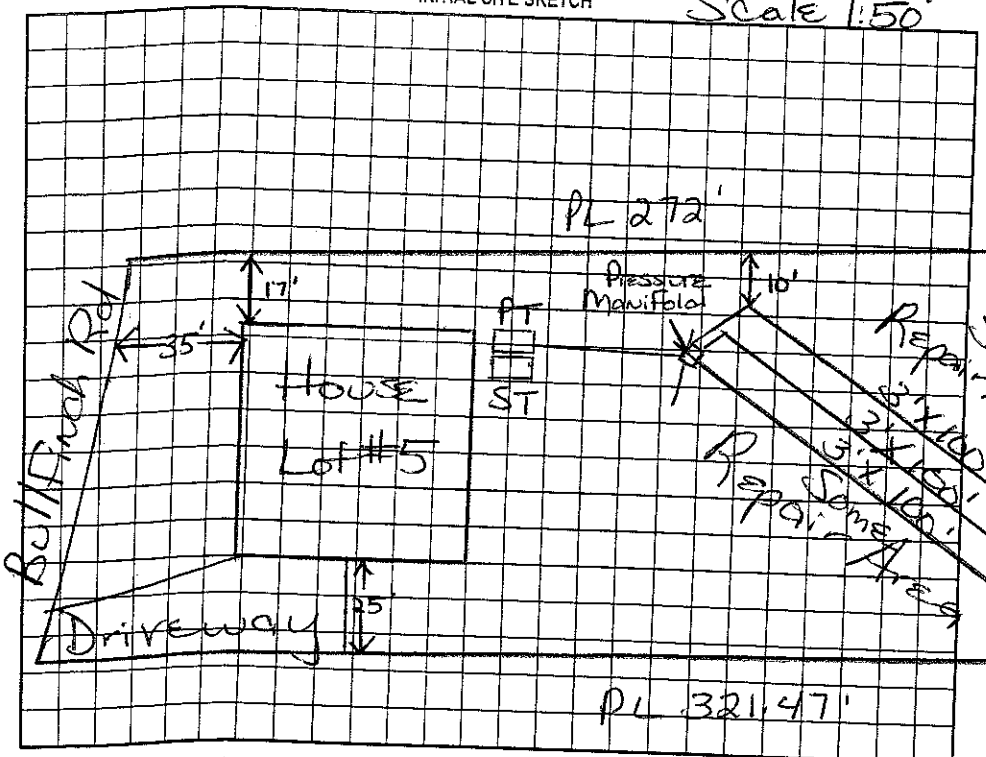

AS BUILT SKETCH

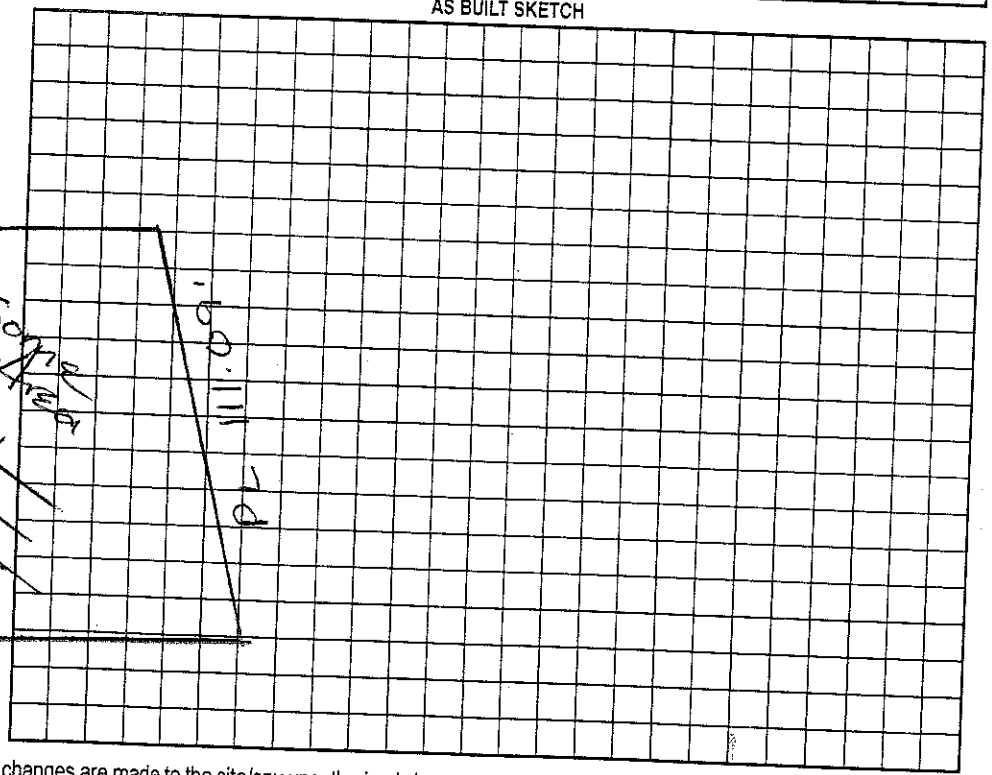

Permit can be suspended or revoked if any false information is supplied toward securing the permit/any unauthorized changes are made to the site/any unauthorized changes are made in the installation of the system. Improvement Permit with plat valid without expiration? Improvement Permit with site plan valid for sixty months. Authorization to Construct is valid for a period equal to that of Improvement Permit – not to exceed sixty months.

Signed: [signature] date 4/17/00

Improvement Permit by: Maria H. Dotson RS date 4/17/00

Authorization to Construct by: Maria H. Dotson RS date 4/17/2000

Installed by: ~~Tommy Frye~~ Wayne Cook

Operation Permit by: Maria H. Dotson RS date 10/13/00

Existing System Inspection by: _____ date _____

HEALTH DEPT. COPY: WHITE OWNER COPY (FINAL): YELLOW OWNER COPY (INITIAL): PINK