$375

IREDELL COUNTY HEALTH DEPARTMENT

STATESVILLE 704-878-5305 MOORESVILLE 704-664-5281

IMPROVEMENT PERMIT / AUTHORIZATION TO CONSTRUCT / OPERATION PERMIT / EXISTING SYSTEM INSPECTION

PERMIT# 11496 PIN# 4639-23-5078 4639-24-7222 DATE December 16, 03

OWNER OR CONTRACTOR Beacon Point Partnership LLC / David Dowdy PHONE: Business Home

ADDRESS P.O. Box 3608, Mooresville N.C. 28117

LOCATION Peth Rd. N. TL Fern Hill Rd. TR on Bullfinch TL on Foxhunt Ct. on Right

SUBDIVISION Beacon Point BLOCK / SECTION 3 LOT 1 LOT AREA 1.40 Ac SITE CLASS PS DESIGN FLOW 460 gpd L.T.A.R. .025

Septic Tank: 1000 Gallons; STB 10/2 Date 7/10/05

Pump Tank: 1000 Gallons; PT 17 Date 7/6/05

Pump Make: Model Serial No.

Nitrification Field: No Fields 1 Square Feet 640 Linear Feet 320

No Lines 4 Trench Width 24"@6c Max Trench Bottom Depth 36" Gravel Depth NA

☑ New System ☐ Repair System Type: I, II, III, (IV) V, VI

System Description: LPPPBPS

Repair System Description: LPPPBPS

Maintenance Agreement Required: ☑ Yes ☐ No

☑ House/Mod. Home No. Bedrooms 4

☐ Mobile Home No. Bathrooms 4

☐ Business No. Employees

☐ Other

☐ Slab ☐ Crawl Space ☑ Basement w/plumbing ☐ Basement wo/plumbing


Water Supply: ☑ Individual ☐ Public ☐ Community

Comments:/Conditions:


Comments:/Conditions:

1"=60'

INITIAL SITE SKETCH

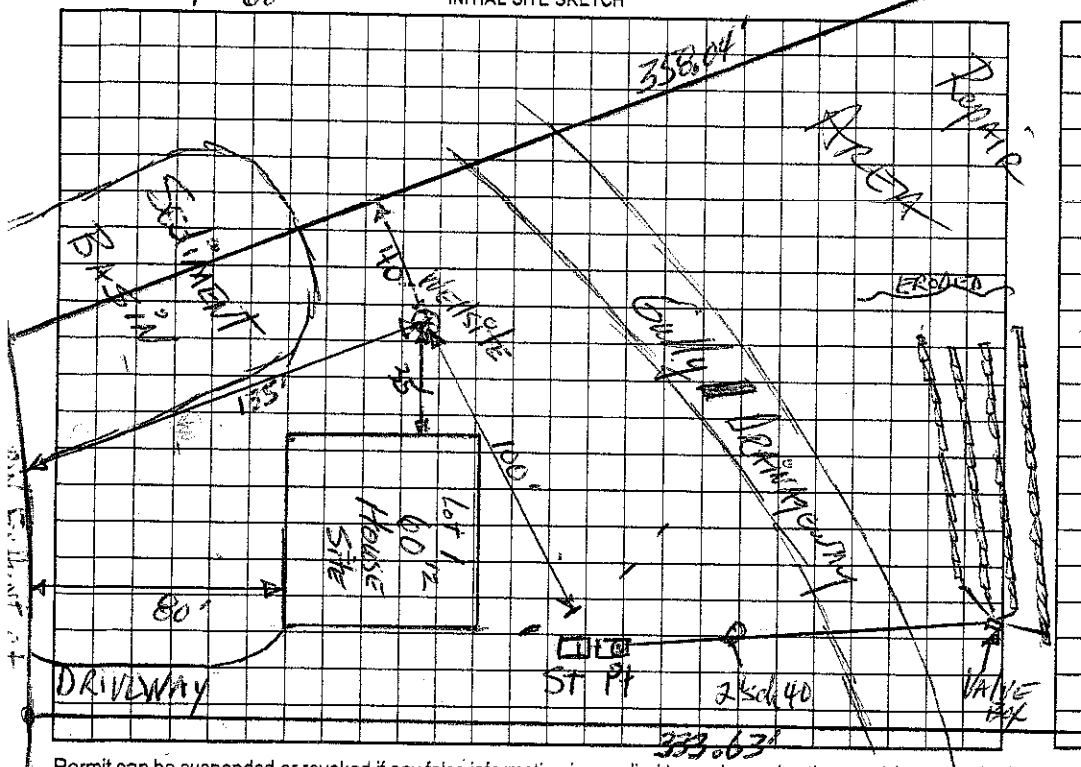

AS BUILT SKETCH

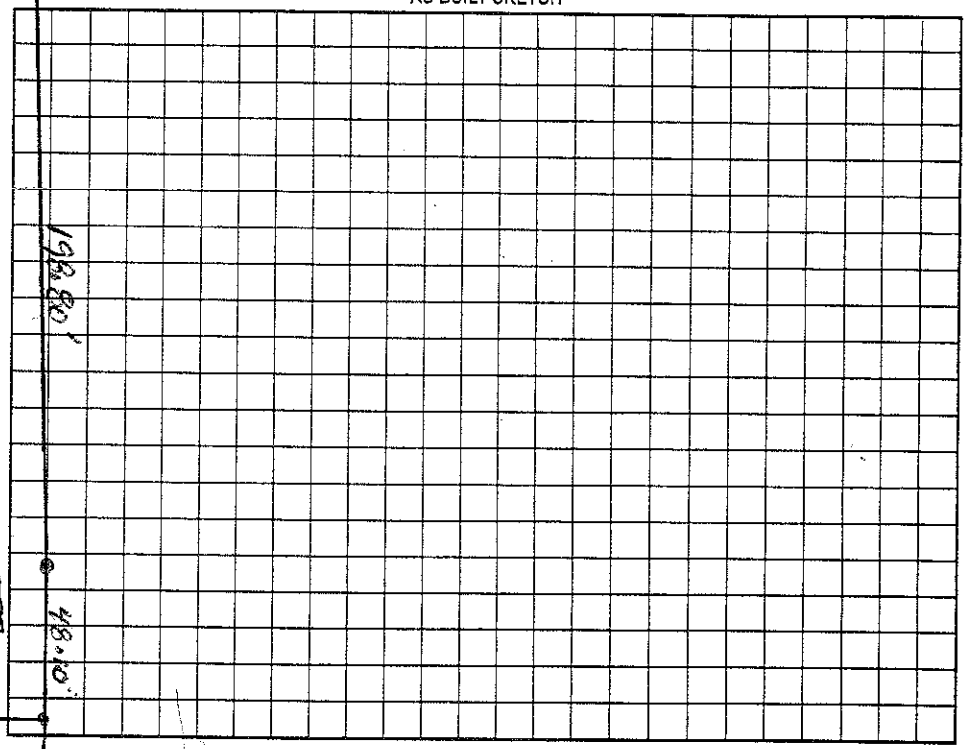

Permit can be suspended or revoked if any false information is supplied toward securing the permit/any unauthorized changes are made to the site/any unauthorized changes are made in the installation of the system. Improvement Permit with plat valid without expiration. Improvement Permit with site plan valid for sixty months. Authorization to Construct is valid for a period equal to that of Improvement Permit – not to exceed sixty months.

Signed: date 1-4-04 Installed by: Craig Thompson

Improvement Permit by: date 12-16-03 Operation Permit by: RS date 5/18/06

Authorization to Construct by: RS date 6/10/05 Existing System Inspection by: date

HEALTH DEPT. COPY: WHITE OWNER COPY (FINAL): YELLOW OWNER COPY (INITIAL): PINK