2:00 325

[illegible] COUNTY HEALTH DEPARTMENT

STATESVILLE 704-878-5305 MOORESVILLE 704-664-5281

[illegible]ROVEMENT PERMIT / AUTHORIZATION TO CONSTRUCT / OPERATION PERMIT / EXISTING SYSTEM INSPECTION

PERMIT# 078869 PIN# 4639251358 DATE 5/26/99

OWNER OR CONTRACTOR Crescent Resources/Lake Norman PHONE: Business 664-1010 Home

ADDRESS P.O. Box 1003 Char. Lotte NC 28201 Construction Inc / 293 Mewette Rd

LOCATION Perth Rd, TL Fern Hill TR Marietta on left

SUBDIVISION Beacon Point BLOCK / SECTION II LOT 19 LOT AREA .739 Acre SITE CLASS. PS DESIGN FLOW 480gpd L.T.A.R. .3

Septic Tank: 1000 Gallons; STB 799 Date 4/14/03

Pump Tank: 1000 Gallons; PT 27 Date 4/14/03

Pump Make: Zoeller Model N-137C Serial No.

Nitrification Field: No Fields 1 Square Feet 810' Linear Feet 270'

No Lines 4 Trench Width 36" Max Trench Bottom Depth 30" Gravel Depth N/A

☒ New System ☐ Repair System Type: I, II, III, IV, V, VI

System Description: LPP – Panel Blk ☆

Repair System Description: Pump-LPP-Panel Blk

Maintenance Agreement Required: ☒ Yes ☐ No

☒ House/Mod. Home ☐ Mobile Home ☐ Business ☐ Other

No. Bedrooms 4 No. Bathrooms 4 No. Employees

☐ Slab ☐ Crawl Space ☐ Basement w/plumbing ☐ Basement wo/plumbing


Water Supply: ☐ Individual ☒ Public ☐ Community

Comments:/Conditions: Keep Septic System at least 10' from PL & 5' from House


Comments:/Conditions: ☆ 50% Reduction in Drainfield area.

Building plans reviewed 10/4/2002. (No bathroom by kings room & no closet)

INITIAL SITE SKETCH Scale 1:50

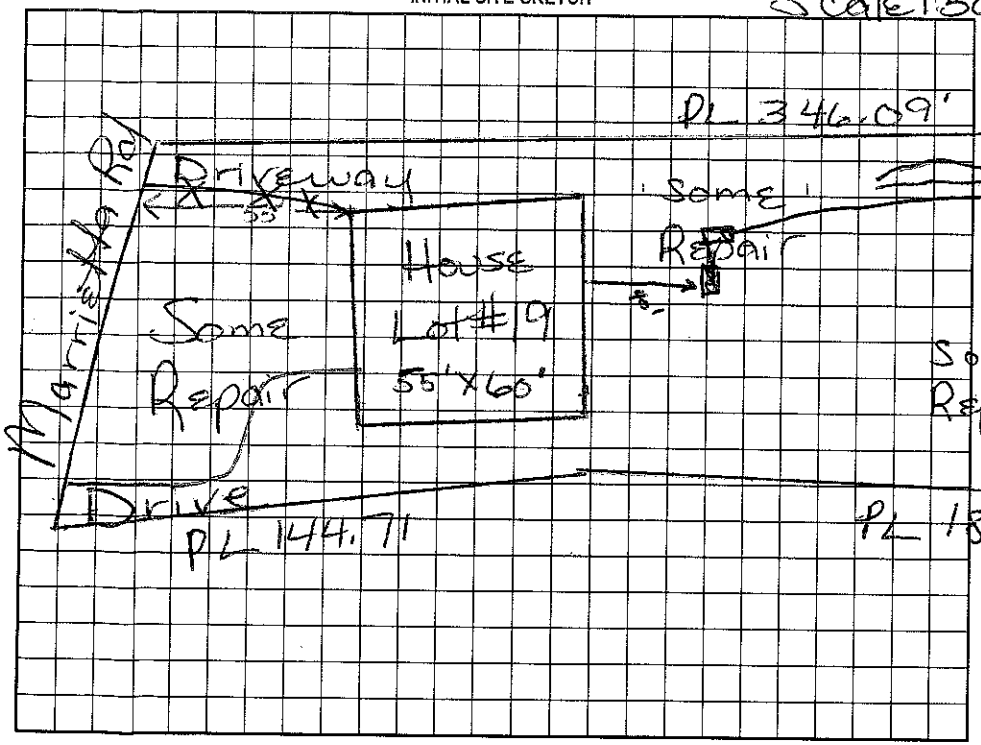

AS BUILT SKETCH

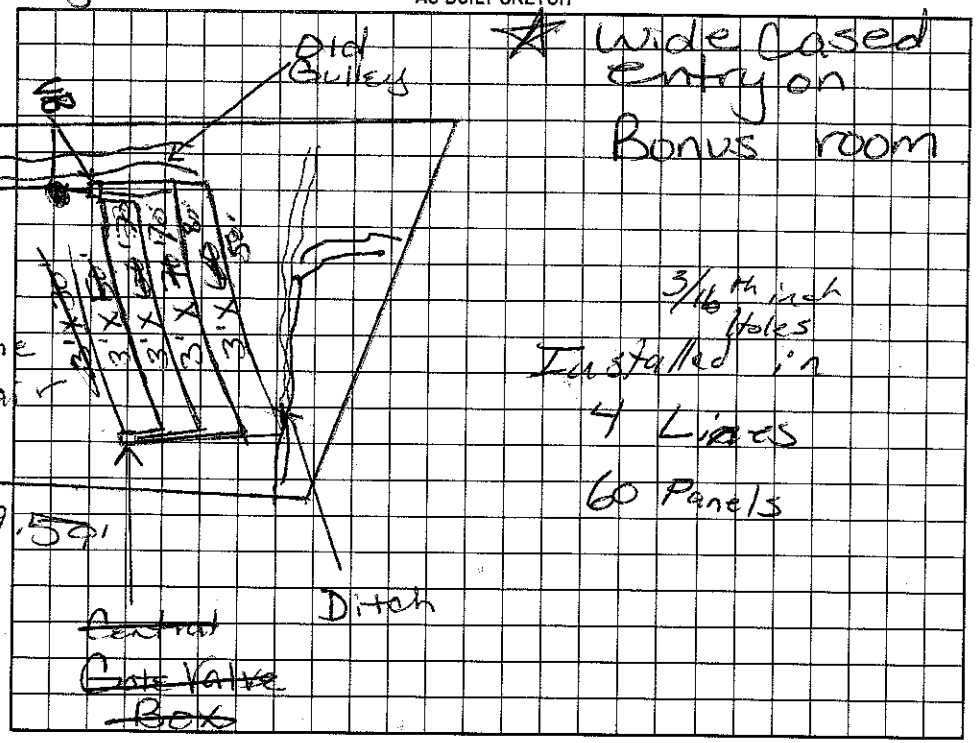

Permit ~~can be suspended~~ or revoked if any false information is supplied toward securing the permit/any unauthorized changes are made to the site/any unauthorized changes are made in the installation of the system. Improvement Permit with plat valid without expiration. Improvement Permit with site plan valid for sixty months. Authorization to Construct is valid for a period equal to that of Improvement Permit – not to exceed sixty months.

Signed: [signature] date 5-28-99 Installed by: Dave Clark

Improvement Permit by: Maria H. Dotson RS. date 5/26/99 Operation Permit by: Wesley Sparks RS. date 6/19/03

Authorization to Construct by: Maria H. Dotson RS. date 10/4/2002 Existing System Inspection by: date

HEALTH DEPT. COPY: WHITE OWNER COPY (FINAL): YELLOW OWNER COPY (INITIAL): PINK