2:00 325

[illegible] COUNTY HEALTH DEPARTMENT

STATESVILLE 704-878-5305 MOORESVILLE 704-664-5281

[illegible]ROVEMENT PERMIT / AUTHORIZATION TO CONSTRUCT / OPERATION PERMIT / EXISTING SYSTEM INSPECTION

PERMIT# 07887 69 PIN# 4639251358 John Kwiatkowski DATE 5/26/99

OWNER OR CONTRACTOR Crescent Resources/Lake Norman PHONE Business 664-1010 Home

ADDRESS P.O. Box 1003 Charlotte, NC 28201 Construction Inc / 293 Meadow Rd.

LOCATION Perth Rd TL Fern Hill TR Marietta on left

SUBDIVISION Beacon Point BLOCK / SECTION II LOT 19 LOT AREA .739Acre SITE CLASS. PS DESIGN FLOW 480gpd L.T.A.R. .3

Septic Tank: 1000 Gallons; STB 799 Date 4/14/03
Pump Tank: 1000 Gallons; PT 27 Date 4/14/03
Pump Make: Zoeller Model N-137C Serial No.
Nitrification Field: No Fields 1 Square Feet 810' Linear Feet 270'
No Lines 4 Trench Width 36" Max Trench Bottom Depth 30" Gravel Depth N/A

☒ New System ☐ Repair System Type: I, II, III, IV, V, VI
System Description: LPP – Panel Blk ★
Repair System Description: Pump-LPP-Panel Blk
Maintenance Agreement Required: ☒ Yes ☐ No


☒ House/Mod. Home No. Bedrooms 4
☐ Mobile Home No. Bathrooms 4
☐ Business No. Employees
☐ Other
☐ Slab ☐ Crawl Space ☐ Basement w/plumbing ☐ Basement wo/plumbing

Water Supply: ☐ Individual ☒ Public ☐ Community


Comments/Conditions: Keep Septic System at least 10' from PL & 5' from House

Comments/Conditions: ★ 50% Reduction in Drainfield area.
Building plans reviewed 10/4/2002. (No bathroom by bonus room & no closet)

INITIAL SITE SKETCH Scale 1:50

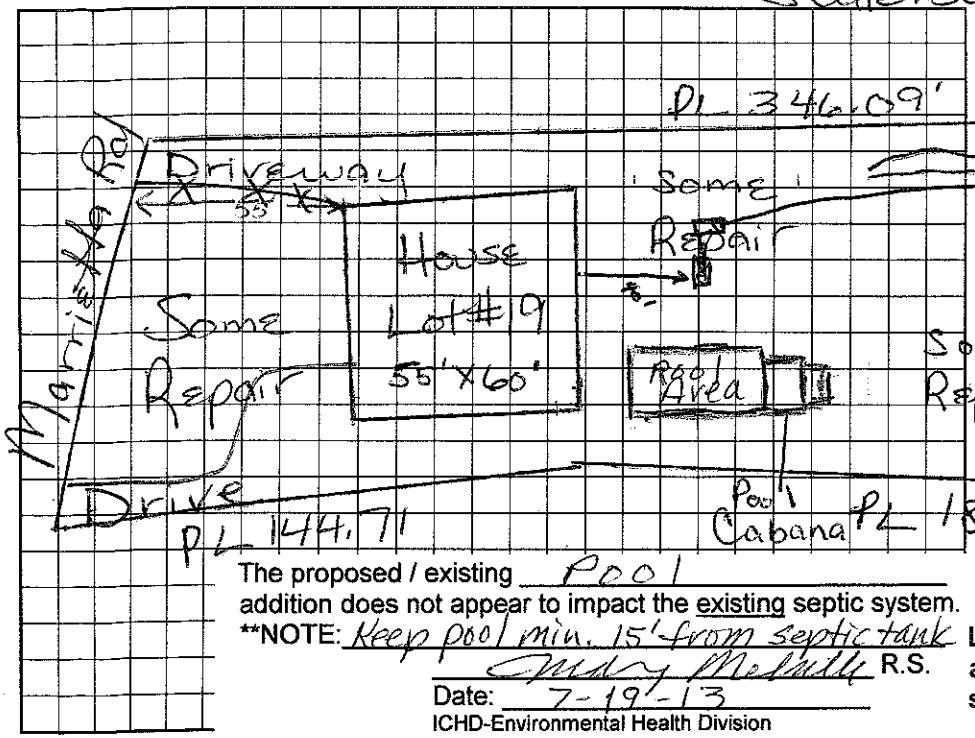

AS BUILT SKETCH

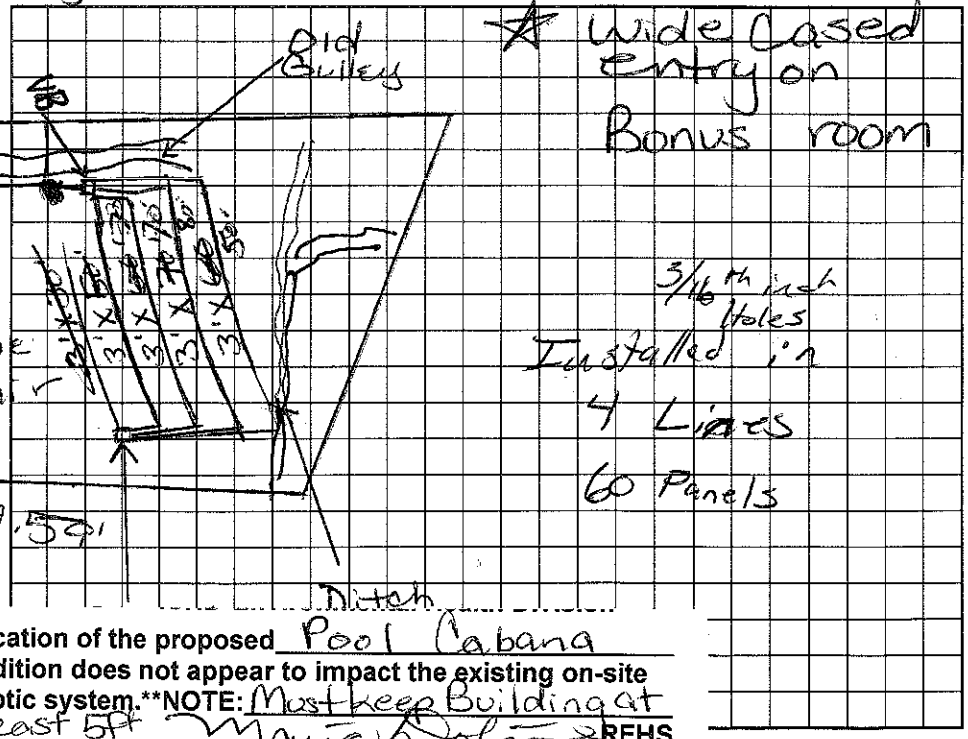

The proposed / existing Pool addition does not appear to impact the existing septic system.
**NOTE: Keep pool min. 15' from septic tank
Wesley McAuley R.S.
Date: 7-19-13
ICHD-Environmental Health Division

Location of the proposed Pool Cabana addition does not appear to impact the existing on-site septic system. **NOTE: Must keep Building at least 5ft from Septic
Maria Dolan REHS
Date: 8/6/13
ICHD-Environmental Health Division

Permit can be suspended or revoked if any false information is supplied toward securing the permit/any unauth[illegible] n of the system. Improvement Permit with plat valid without expiration. Improvement Permit with site plan valid for sixty months. Authorizatic[illegible] sixty months.

Signed: Pat G Perry date 5-28-99 Installed by: Dave Clark

Improvement Permit by: Maria H. Dolan RS date 5/26/99 Operation Permit by: Wesley Apple RS. date 6/19/03

Authorization to Construct by: Maria H. Dolan RS date 10/4/2002 Existing System Inspection by: date

HEALTH DEPT. COPY: WHITE OWNER COPY (FINAL): YELLOW OWNER COPY (INITIAL): PINK