# IREDELL COUNTY HEALTH DEPARTMENT

STATESVILLE 704-878-5305 MOORESVILLE 704-664-5281

125

## IMPROVEMENT PERMIT / AUTHORIZATION TO CONSTRUCT / OPERATION PERMIT / EXISTING SYSTEM INSPECTION

PERMIT# 078872 PIN# 4639252057 DATE 5/22/99

OWNER OR CONTRACTOR Crescent Resources PHONE: Business 664-1010 Home

ADDRESS P.O. Box 1003 Charlotte NC 28201

LOCATION North Rd TL Fern Hill TR Marrietta on left

SUBDIVISION Beacon Pointe BLOCK / SECTION II LOT 22 LOT AREA 1.02 Acre SITE CLASS. PS DESIGN FLOW 480gpd L.T.A.R. .3

Septic Tank: 1000 Gallons; STB Date

Pump Tank: 1000 Gallons; PT Date

Pump Make: Model Serial No.

Nitrification Field: No Fields 1 Square Feet 1260' Linear Feet 420'

No Lines Eat 70' Trench Width 36" Max Trench Bottom Depth 36" Gravel Depth N/A

X New System ☐ Repair System Type: I, II, III, IV, V, VI

System Description: Pump-PM-25% Reduction

Repair System Description: Pump to Innovative

Maintenance Agreement Required: ☐ Yes X No

X House/Mod. Home No. Bedrooms 4

☐ Mobile Home No. Bathrooms 4

☐ Business No. Employees

☐ Other


☐ Slab X Crawl Space ☐ Basement w/plumbing ☐ Basement wo/plumbing

Water Supply: ☐ Individual X Public X Community


Comments:/Conditions: Keep Septic System at least 10' From PL & 5' From House

Comments:/Conditions:

INITIAL SITE SKETCH Scale 1:50

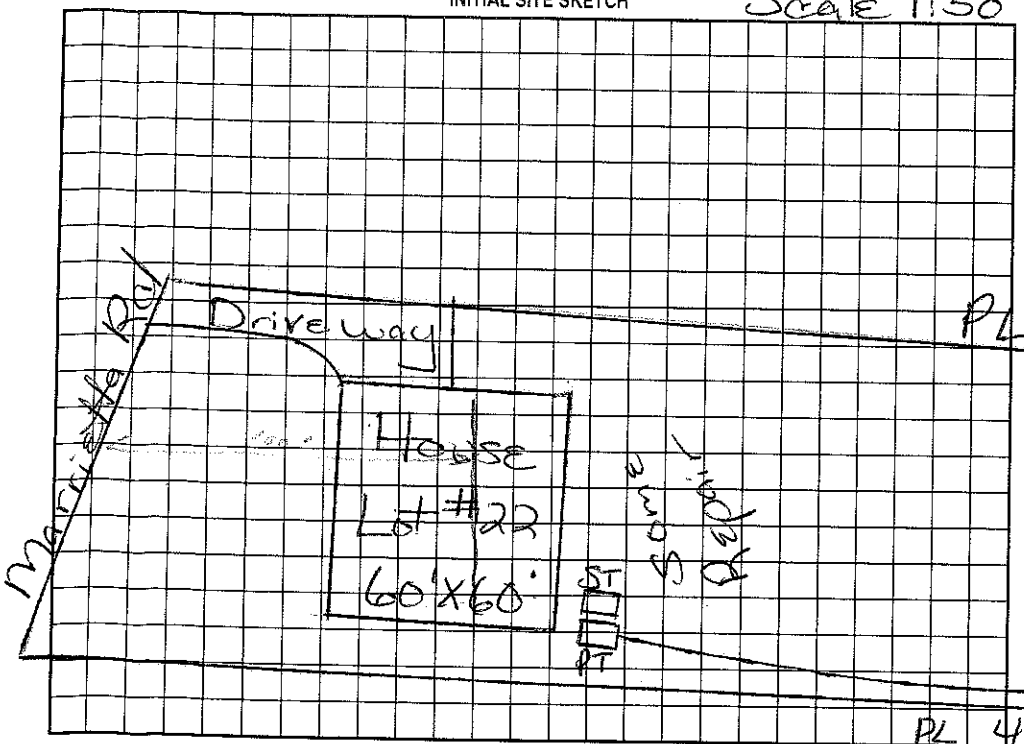


AS BUILT SKETCH

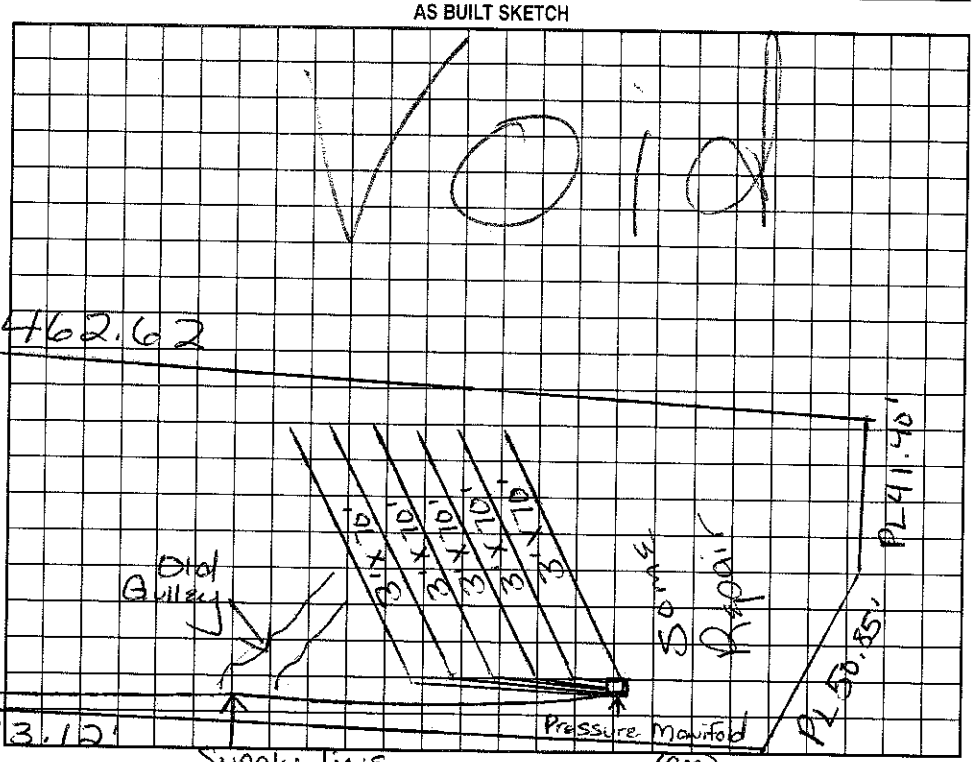


Permit can be suspended or revoked if any false information is supplied toward securing the permit/any unauthorized changes are made to the site/any unauthorized changes are made in the installation of the system. Improvement Permit with plat valid without expiration. Improvement Permit with site plan valid for sixty months. Authorization to Construct is valid for a period equal to that of Improvement Permit – not to exceed sixty months.

Signed: Paul G. Penny date 5-28-99 Installed by:

Improvement Permit by: Marie H. Dolson RS. date 5/22/99 Operation Permit by: date

Authorization to Construct by: date Existing System Inspection by: date

HEALTH DEPT. COPY: WHITE OWNER COPY (FINAL): YELLOW OWNER COPY (INITIAL): PINK