IREDELL COUNTY HEALTH DEPARTMENT

STATESVILLE 704-878-5305 MOORESVILLE 704-664-5281

IMPROVEMENT PERMIT / AUTHORIZATION TO CONSTRUCT / OPERATION PERMIT / EXISTING SYSTEM INSPECTION

PERMIT# 86034 PIN# 4639 25 4483 DATE 2/28/03

OWNER OR CONTRACTOR Donnie Poole PHONE: Business 663-6905 Home

ADDRESS PO Box 1009 Trantman, NC. 28166

LOCATION Perth N TL Fern Hill TR Mountain to 5th on (R) past Raymond Rd.

SUBDIVISION CL+T BLOCK / SECTION 16 LOT 940 LOT AREA 1.08 Ac SITE CLASS PS DESIGN FLOW 480 L.T.A.R. .3

Septic Tank: 1000 Gallons; STB 1012 Date 8/5/02
Pump Tank: 1000 Gallons; PT 19 Date 12/20/02
Pump Make: GOULDS Model WE0-311M Serial No.
Nitrification Field: No Fields 1 Square Feet 1200 Linear Feet 400
No Lines 3@100 Trench Width 3 Max Trench Bottom Depth 3' Gravel Depth No


[X] New System [ ] Repair System Type: I, II, (III), IV, V, VI
System Description: PM - Type 3 Discharge
Repair System Description: Pump - 16" PPBPS
Maintenance Agreement Required: [ ] Yes [X] No

[X] House/Mod. Home No. Bedrooms 4
[ ] Mobile Home No. Bathrooms 4
[ ] Business No. Employees
[ ] Other
[ ] Slab [ ] Crawl Space [X] Basement w/plumbing [ ] Basement wo/plumbing

Water Supply: [X] Individual [ ] Public [ ] Community


Comments:/Conditions:

INITIAL SITE SKETCH (1" = 50')

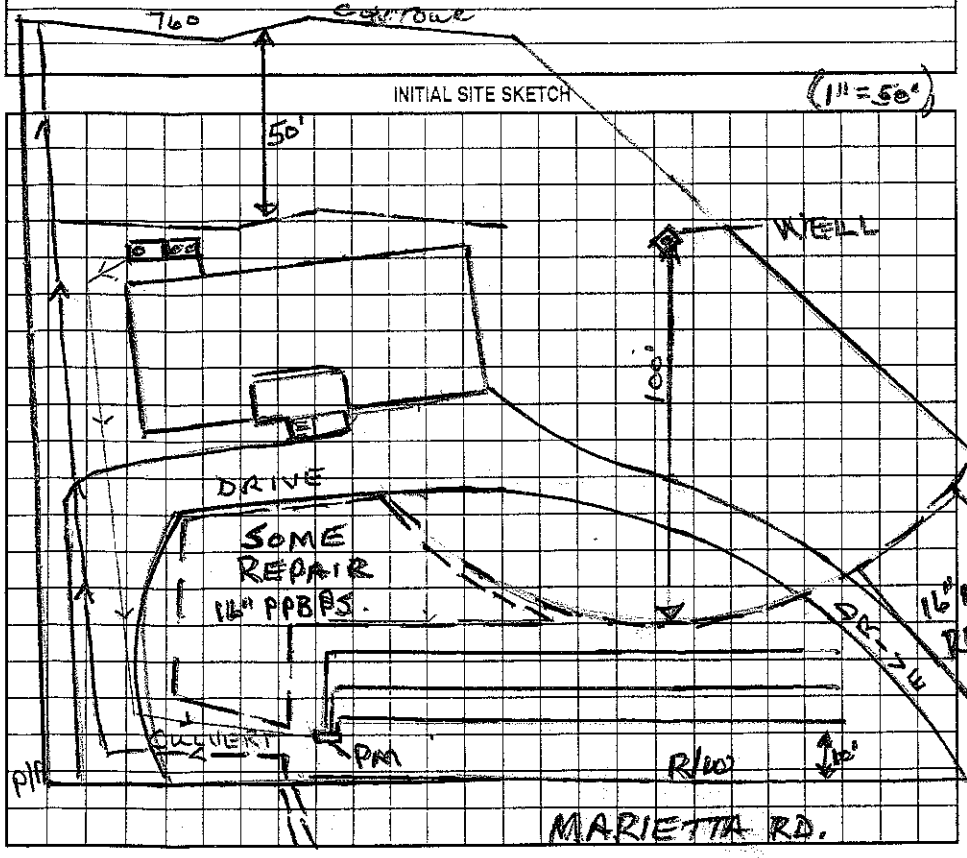

Comments:/Conditions:

AS BUILT SKETCH

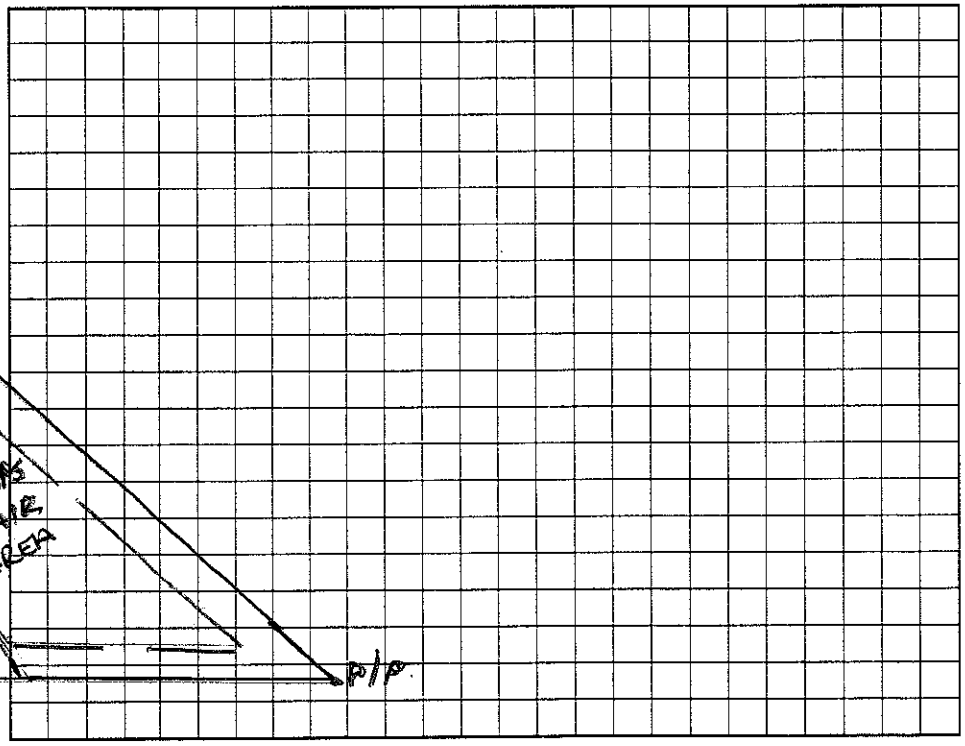

Permit can be suspended or revoked if any false information is supplied toward securing the permit/any unauthorized changes are made to the site/any unauthorized changes are made in the installation of the system. Improvement Permit with plat valid without expiration. Improvement Permit with site plan valid for sixty months. Authorization to Construct is valid for a period equal to that of Improvement Permit – not to exceed sixty months.

Signed: Donnie Poole date

Improvement Permit by: B. FREEMAN date 11/99

Authorization to Construct by: Wesley Sparks RS. date 8/8/01

Installed by: A-1 Backhoe

Operation Permit by: [signature] RS date 4/24/03

Existing System Inspection by: date

HEALTH DEPT. COPY: WHITE OWNER COPY (FINAL): YELLOW OWNER COPY (INITIAL): PINK