IREDELL COUNTY HEALTH DEPARTMENT

STATESVILLE 704-878-5305 MOORESVILLE 704-664-5281

IMPROVEMENT PERMIT / AUTHORIZATION TO CONSTRUCT / OPERATION PERMIT / EXISTING SYSTEM INSPECTION

PERMIT# 086035 (9432 0) PIN# 4639255199 DATE Dec 20, 01

OWNER OR CONTRACTOR William Katibah PHONE: Business Home

ADDRESS 234 Marietta Rd. Mooresville N.C.

LOCATION Peeth Road North TL Fern Hill Road TR Marietta Rd. ~1/4 mile on Right

SUBDIVISION CRI BLOCK / SECTION LOT 939 LOT AREA 1.19Ac SITE CLASS. RSprings6 DESIGN FLOW 360gpd L.T.A.R. .3

Septic Tank: 1000 Gallons; STB 794 Date 10-8-01
Pump Tank: 1000 Gallons; PT 283 Date 10-30-01
Pump Make Gould's Model WED3111M Serial No. 5-7-01
Nitrification Field: No Fields 1 Square Feet 400/600 Linear Feet 200
No Lines 3 Trench Width 24" min 60c Max Trench Bottom Depth 30" Gravel Depth NA

☑ New System ☐ Repair System Type: I. II. III. IV. V. VI
System Description: LPPBPS
Repair System Description: SAME
Maintenance Agreement Required: ☑ Yes ☐ No


☑ House/Mod. Home No. Bedrooms 3
☐ Mobile Home No. Bathrooms 3
☐ Business No. Employees
☐ Other
☐ Slab ☐ Crawl Space ☑ Basement w/plumbing ☐ Basement wo/plumbing

Water Supply: ☑ Individual ☐ Public ☐ Community

Comments/Conditions: OR 36" MAX 9'oc House was started & nearly complete without Authorization to construct from Health Dept. This permit Replaces one now voided IP issued to CRI. Remove gravel driveway as shown. Drill well exactly where shown. Pre construction conference Required. Basement level has 1" ≈ 50' five lift station


Comments/Conditions: Filter installed
Checked tanks, lines & press. 12/31/01
Electrical & Alarm Checked 3/4/2002

INITIAL SITE SKETCH which was unnecessary due to the necessity of pumping anyway.

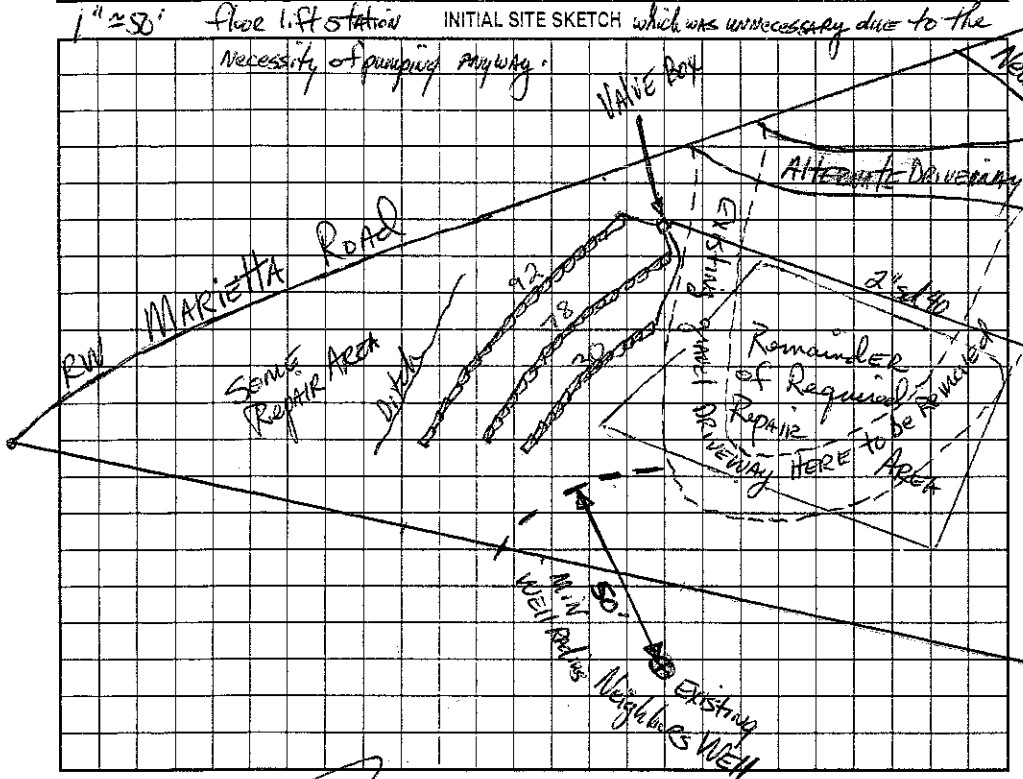

AS BUILT SKETCH

Installed as Drawn

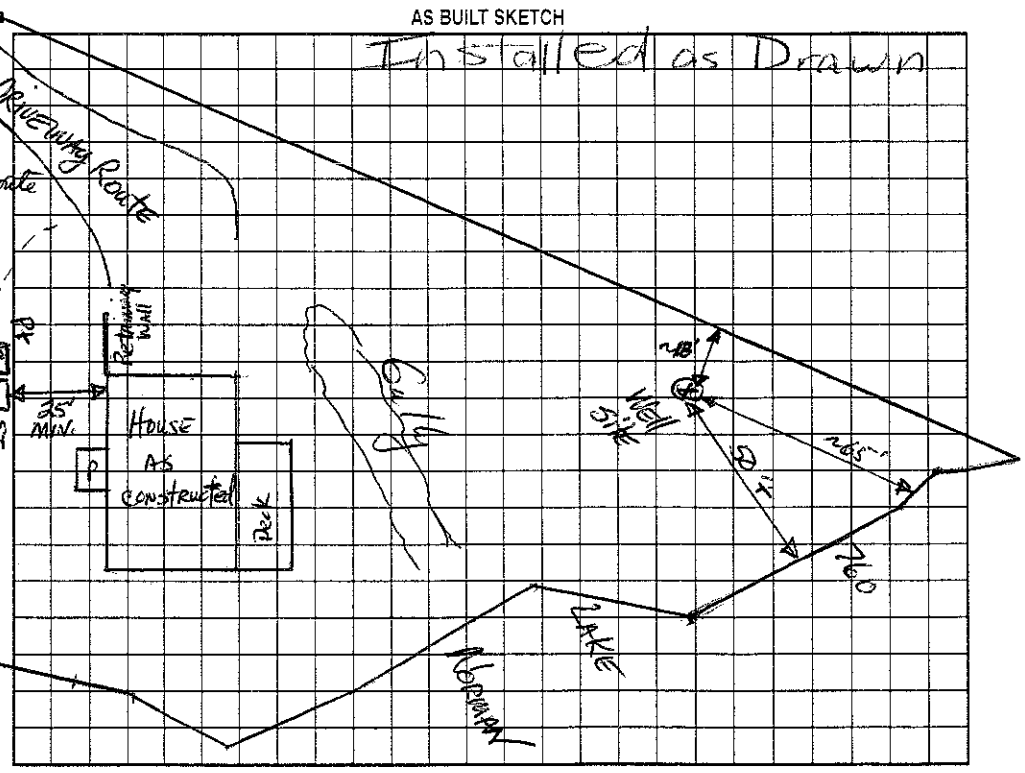

Permit can be suspended or revoked if any false information is supplied toward securing the permit/any unauthorized changes are made to the site/any unauthorized changes are made in the installation of the system. Improvement Permit with plat valid without expiration. Improvement Permit with site plan valid for sixty months. Authorization to Construct is valid for a period equal to that of Improvement Permit – not to exceed sixty months.

Signed: date 12-24-01 Installed by: Bobby McCarver

Improvement Permit by: date 12-20-01 Operation Permit by:

Authorization to Construct by: date 12-20-01 Existing System Inspection by:

HEALTH DEPT. COPY: WHITE OWNER COPY (FINAL): YELLOW OWNER COPY (INITIAL): PINK