ELL COUNTY HEALTH DEPARTMENT

STATESVILLE 704-878-5305 $280.00 paid Upgrade MOORESVILLE 704-664-5281

PROVEMENT PERMIT / AUTHORIZATION TO CONSTRUCT / OPERATION PERMIT / EXISTING SYSTEM INSPECTION

PERMIT# 105263 PIN# 4639258260 Cell DATE 4/3/2002

OWNER OR CONTRACTOR Sam & Donna Burgard PHONE: Business 661-1455 Home (704) 548-8845

ADDRESS 1931 Dembrigh Ln Charlotte NC 28262

LOCATION 186 Marietta Perth Rd North TL Fern Hill Rd TR Marietta ~ 1/3 mile on right

SUBDIVISION C L & T BLOCK / SECTION 16 LOT 937 LOT AREA SITE CLASS PS DESIGN FLOW 480gpd L.T.A.R. .37

Septic Tank: Existing Gallons; STB Date

Pump Tank: Gallons; PT Date

Pump Make: Model Serial No.

Nitrification Field: No Fields 1 Square Feet 300' Linear Feet 100'

No Lines 1 Trench Width 36" Max Trench Bottom Depth 24"-36" Gravel Depth N/A

☒ New System ☐ Repair System Type: I, II, III, IV, V, VI AW3

System Description: Gravity - ~~25% Reduction~~

Repair System Description: Pump - Innorative

Maintenance Agreement Required: ☐ Yes ☒ No

☒ House/Mod. Home ☐ Mobile Home ☐ Business ☐ Other

No. Bedrooms 4 No. Bathrooms 3 No. Employees

☐ Slab ☒ Crawl Space ☐ Basement w/plumbing ☐ Basement wo/plumbing

Water Supply: ☒ Individual exist. ☐ Public ☐ Community


Add 1 line 25% Red

Comments/Conditions: Upgrading Existing drainfield to 4 Bedroom.


Comments/Conditions: INSTALLED 100' X 3' CONVENTIONAL TRENCH AWS

Scale 1:50

INITIAL SITE SKETCH

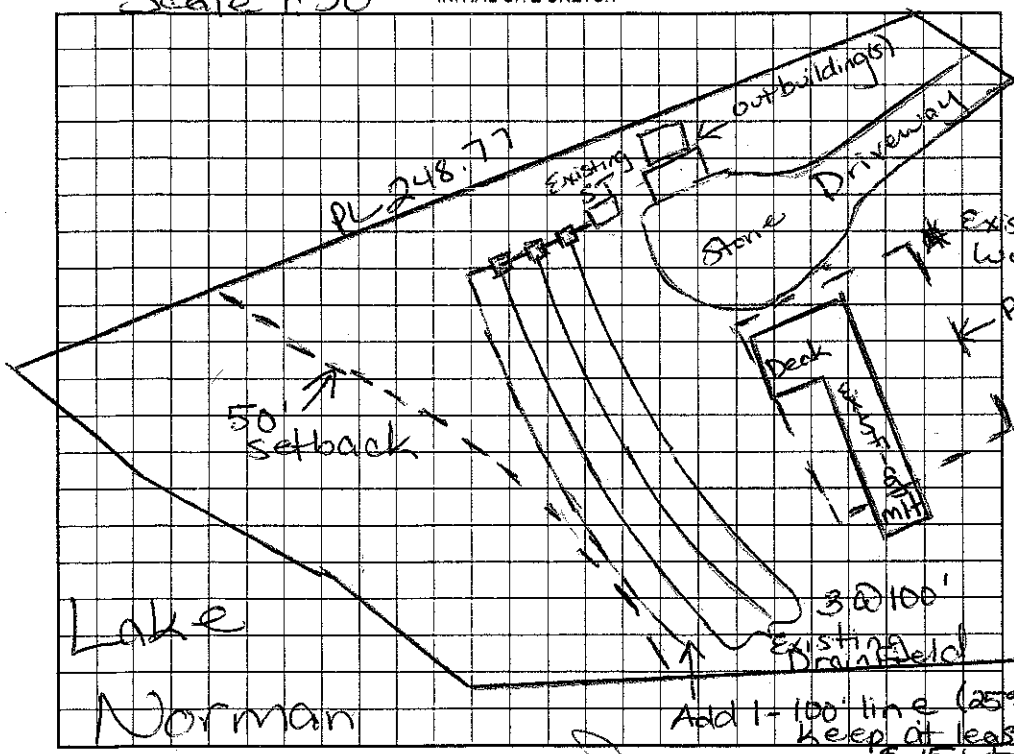

AS BUILT SKETCH

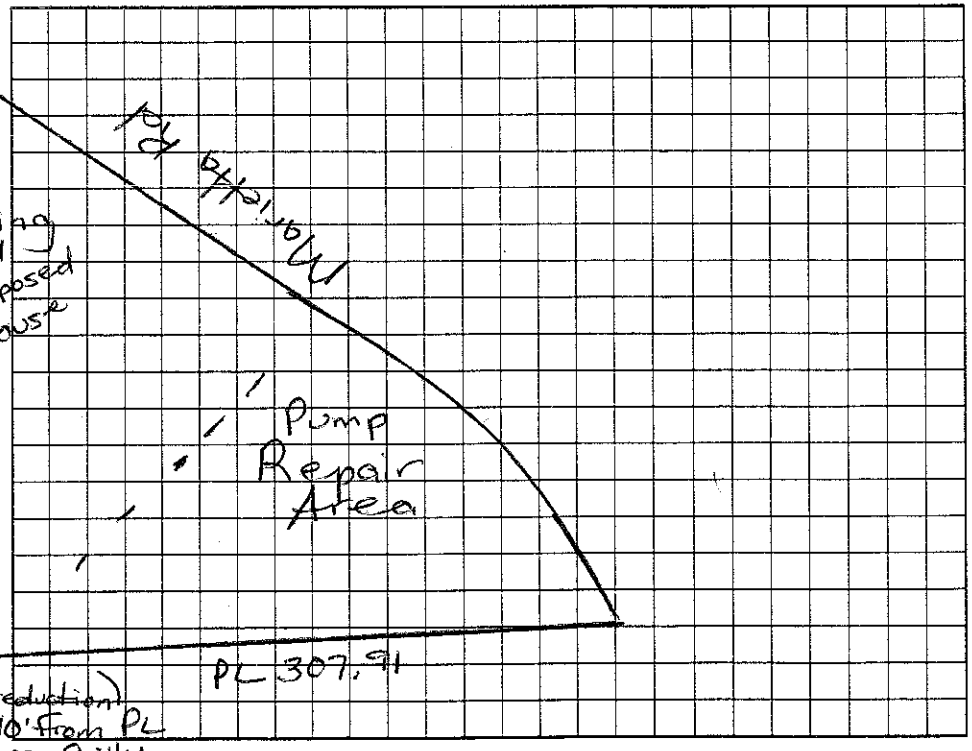

Permit can be suspended or revoked if any false information is supplied toward securing the permit/any unauthorized changes are made to the site/any unauthorized changes are made in the installation of the system. Improvement Permit with plat valid without expiration. Improvement Permit with site plan valid for sixty months. Authorization to Construct is valid for a period equal to that of Improvement Permit – not to exceed sixty months.

Signed: [signature] date 4-4-02 Installed by: Danny Lanning - Wayne County

Improvement Permit by: Maina M. Wilson RS date 4/3/2002 Operation Permit by: Wesley Sparkes RS. date 8/16/02

Authorization to Construct by: Maina M. Wilson RS date 4/3/2002 Existing System Inspection by: date

HEALTH DEPT. COPY: WHITE OWNER COPY (FINAL): YELLOW OWNER COPY (INITIAL): PINK