1.50

IREDELL COUNTY HEALTH DEPARTMENT

STATESVILLE 704-878-5305 MOORESVILLE 704-664-5281

IMPROVEMENT PERMIT / AUTHORIZATION TO CONSTRUCT / OPERATION PERMIT / EXISTING SYSTEM INSPECTION

PERMIT# 86037 PIN# 4639248440 4639-25-8440 DATE 11/19/99

OWNER OR CONTRACTOR CRESCENT RESOURCES / Todd Zieg PHONE: Business 663-6905 Home Todd's wk 664-3800

ADDRESS PO BOX 1003 CHARLOTTE NC 28201

LOCATION PERTH RD (N) - TL FERN HILL - TR MARIETTA - AT CORNER OF RAYMOND

SUBDIVISION CL LT BLOCK / SECTION LOT 936 LOT AREA .97AC SITE CLASS. PS DESIGN FLOW 480GD L.T.A.R. .3 gal/ft²

Septic Tank: 1000 Gallons; STB 825 Date 5-19-01

Pump Tank: 1000 Gallons; PT 302 Date 6-5-01

Pump Make: Zoeller Model N137C Serial No LCSA 115V 1PH

Nitrification Field: No Fields 1 Square Feet 1200 Linear Feet 400

No Lines 3@133' Trench Width 36" Max Trench Bottom Depth 36" Gravel Depth N/A

☑ New System ☐ Repair System Type: I, II, III, IV, V, VI

System Description: PUMP 25% REDUCTION

Repair System Description: PUMP SAME

Maintenance Agreement Required: ☐ Yes ☑ No

☑ House/Mod. Home No. Bedrooms 4

☐ Mobile Home No. Bathrooms 4

☐ Business No. Employees

☐ Other

☐ Slab ☑ Crawl Space ☑ Basement w/plumbing ☐ Basement wo/plumbing


Water Supply: ☑ Individual ☐ Public ☐ Community

Comments:/Conditions:

1" = 50'


SLEEVE WITH DUCTILE IRON OR EQUIVALENT UNDER DRIVE. 24'

INITIAL SITE SKETCH

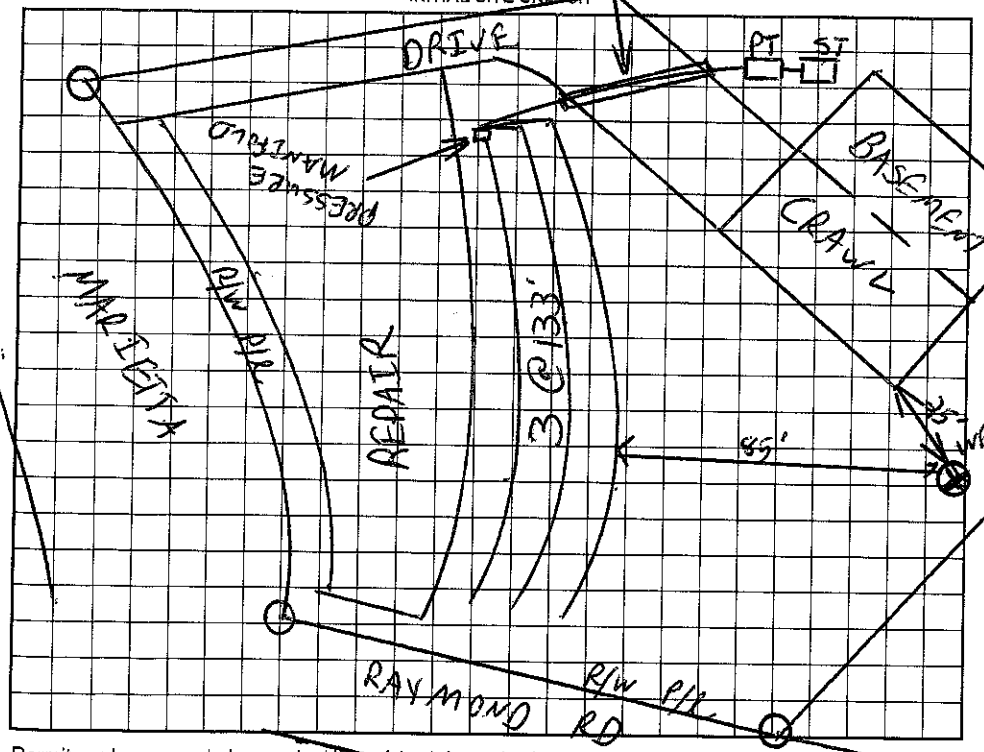

Comments:/Conditions: PARTIAL

AS BUILT SKETCH

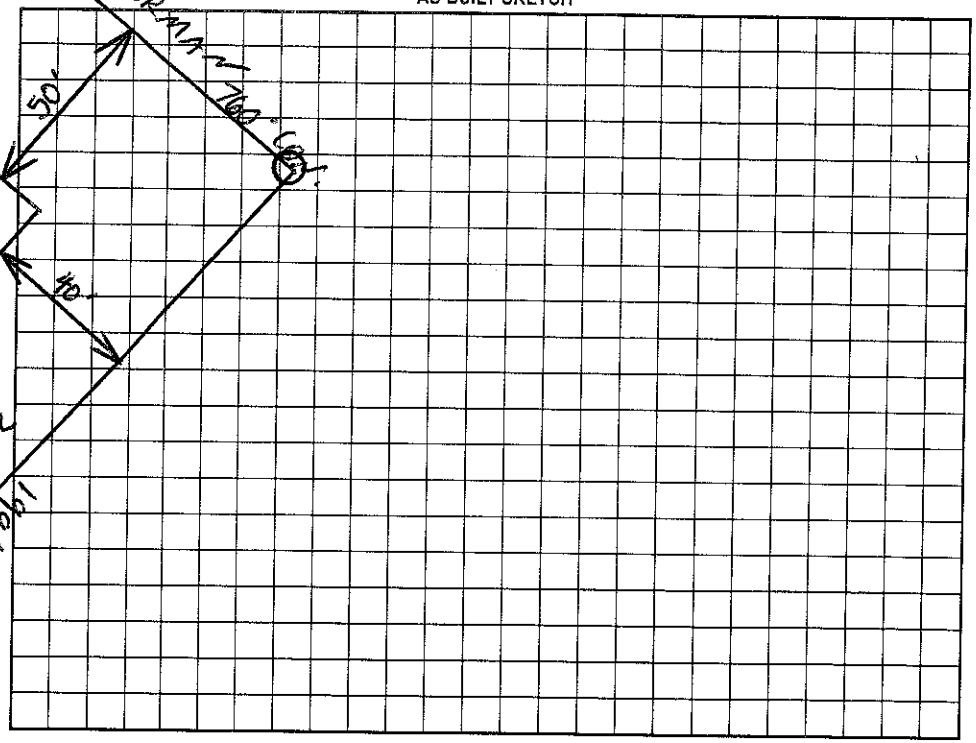

Permit can be suspended or revoked if any false information is supplied toward securing the permit/any unauthorized changes are made to the site/any unauthorized changes are made in the installation of the system. Improvement Permit with plat valid without expiration. Improvement Permit with site plan valid for sixty months. Authorization to Construct is valid for a period equal to that of Improvement Permit – not to exceed sixty months.

Signed: Tony C Jones date 11-24-99 Installed by: Joe Thompson

Improvement Permit by: C. Ray Zahn RS date 11/19/99 Operation Permit by: RS date 10/2/01

Authorization to Construct by: Wesley Sparks RS. date 3/22/01 Existing System Inspection by: date

HEALTH DEPT. COPY: WHITE OWNER COPY (FINAL): YELLOW OWNER COPY (INITIAL): PINK