IREDELL COUNTY HEALTH DEPARTMENT

Statesville Office (704) 878-5305 Mooresville Office (704) 660-3625 PERMIT # 209867

IMPROVEMENT PERMIT / AUTHORIZATION TO CONSTRUCT / OPERATION PERMIT / EXISTING SYSTEM

PIN # 4639281808

APPLICANT: Michael Halford APPLICANT ADDRESS: 131 Crown Court

SITE ADDRESS: 120 Crown Court PHONE: 704-929-6889 ALT. PHONE: N/A

SITE DIRECTIONS: State Park Rd TL Morrison Farm Rd TL Apache TL Crown Ct.

SUBDIVISION: N/A SECTION: N/A LOT # N/A LOT AREA: 1.017 acres DESIGN FLOW: 360gpd L.T.A.R.: 0.3

Septic Tank	1000 (gal)	STB	825-1000	Date	1-24-16	☑ New System	☐ Repair	☐ Expansion	System Type: I II (III) IV V VI
Pump Tank	1000 (gal)	PT	302-1000	Date	10-1-15	System Description:	50% Reduction		
Pump Make	Zoeller	Model	152B	Serial #		Repair System Description:	Pretreatment DRIP		
# Nitrification Fields	1	# Lines	4	Linear Ft:	200	Maintenance Agreement Required:	☐ YES	☑ NO	
Trench Width	24"	Max. Trench Bottom Depth	36"	Gravel Depth	N/A		☐ GRAVITY	☑ PRESSURE	

☑ Residence	No. Bedrooms	3	Water Supply	
☐ Business	No. Persons	6	☐ Private	
☐ Other	No. Employees		☑ Public	
☐ Slab	☐ Crawl Space		☐ Community	
☑ Basement w/plumbing			☐ Basement w/o plumbing	

Comments / Conditions: - Submit Floor plan prior to issuance of CA

INITIAL SITE SKETCH

Refer to Attached Plan by:

Michael Athanas + Associates

AS BUILT SKETCH

- Blue Tuf-Tite Filter installed
- Force Main installed @ 48" under driveway
- PTBTS Chambers installed as drawn

	Date	Initials
Drain Lines Checked	5-10-16	JH
Tanks Checked	5-10-16	JH
Pressure Manifold or Valve Box Checked	5-10-16	JH
Pressure Head Set	5-10-16	JH
Electrical Checked		
Floats Set	5-10-16	JH
Alarm Checked	6-22-16	HS
Maintenance Contract Y / N	N/A	
Comments:		

Permit can be suspended or revoked if any false information is supplied toward securing the permit / any unauthorized changes are made to the site / any unauthorized changes are made in the installation of the system. **CONTACT A LOCATOR SERVICE PRIOR TO ANY EXCAVATION**

☐ **IMPROVEMENT PERMIT** *with plat valid without expiration.* ☑ **IMPROVEMENT PERMIT** *with site plan valid for 60 mos.* ☑ **AUTHORIZATION TO CONSTRUCT** *valid for period equal to IMPROVEMENT PERMIT--not to exceed 60 mo.*


Owner / Applicant Signature: [signature] Date: 10-8-15 Installed by: JS Key Enterprises

IMPROVEMENT PERMIT by: Justin Henderson Date: 5-14-15 OPERATION PERMIT by: [signature] Date: 06/22/16

AUTHORIZATION TO CONSTRUCT by: Justin Henderson Date: 10-8-15 Existing System Inspected by: Date:

Health Dept. Copy - WHITE Applicant (Final Approval) - YELLOW Applicant (Conditional Approval) - PINK

EPARED IN ACCORDANCE WITH G.S. 89-C
SIGNATURE, REGISTRATION NUMBER AND
_____, 2015.

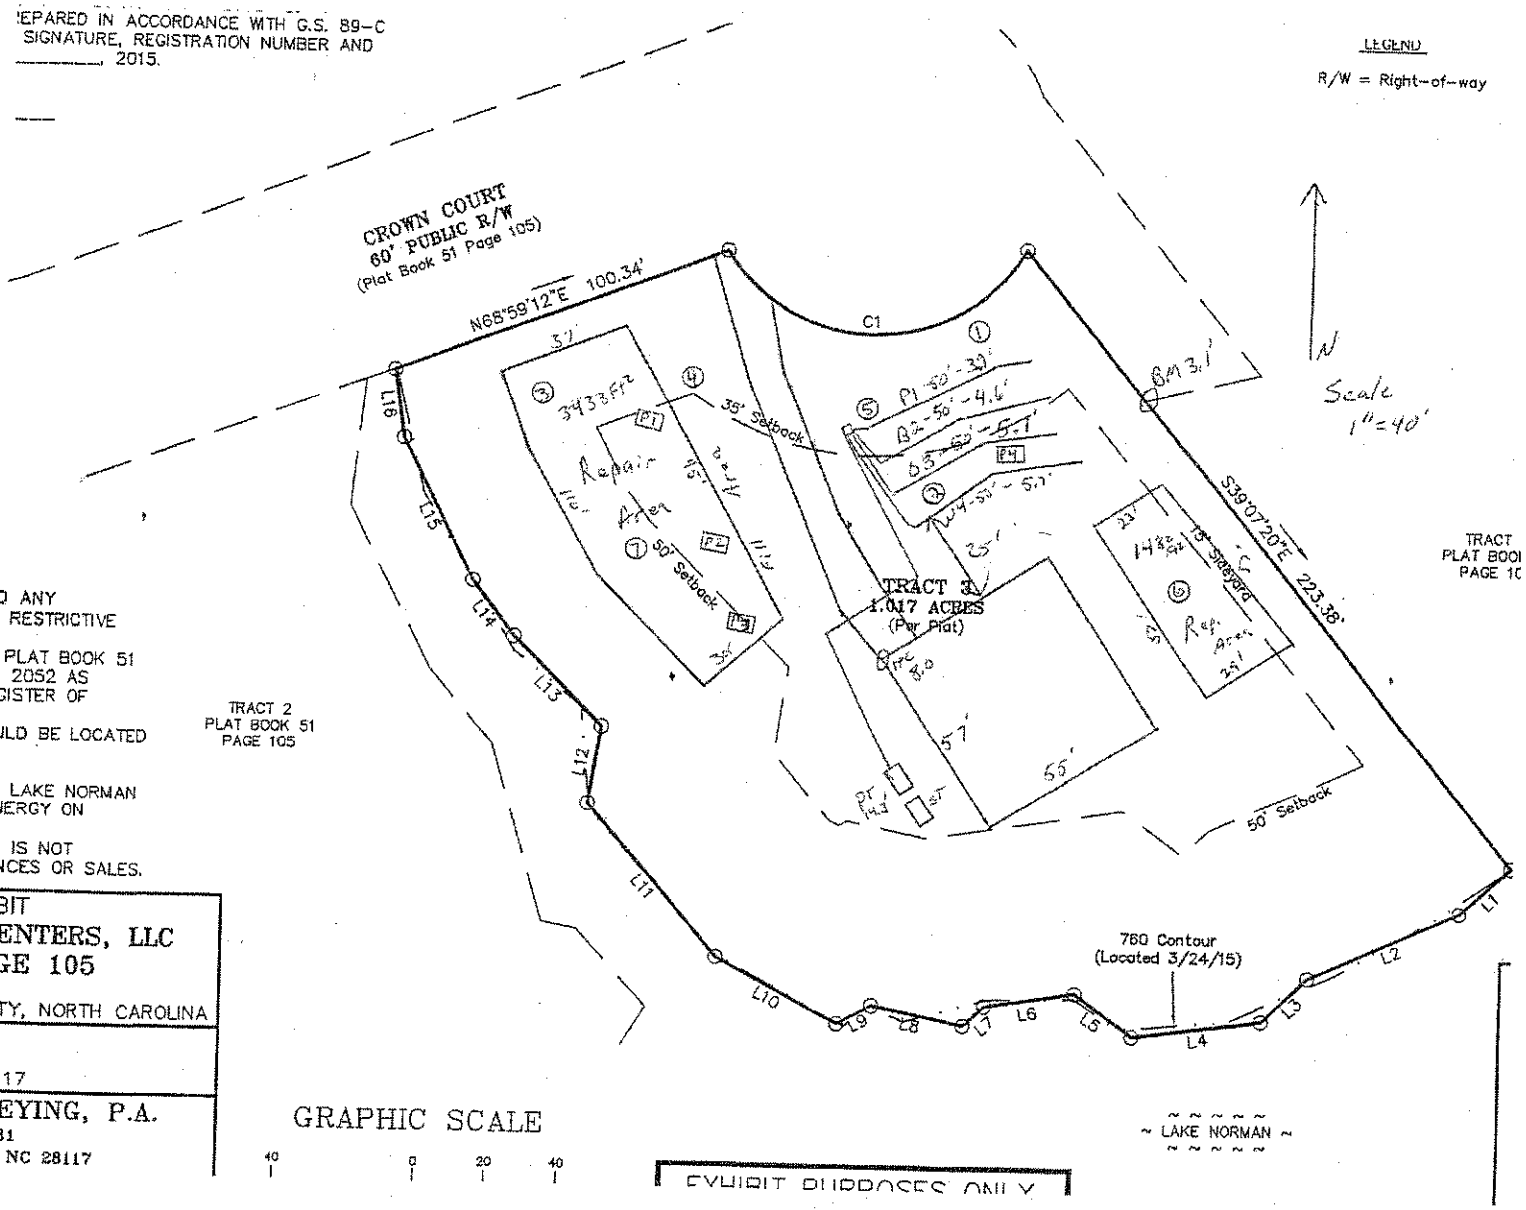

D ANY
RESTRICTIVE

PLAT BOOK 51
2052 AS
GISTER OF

JLD BE LOCATED

I LAKE NORMAN
NERGY ON

D IS NOT
NCES OR SALES.

TRACT 2
PLAT BOOK 51
PAGE 105

TRACT
PLAT BOO
PAGE 10

BIT
ENTERS, LLC
GE 105
NTY, NORTH CAROLINA

T
3117
VEYING, P.A.
031
, NC 28117