IREDELL COUNTY HEALTH DEPARTMENT

STATESVILLE 704-878-5305 MOORESVILLE 704-664-5281

IMPROVEMENT PERMIT / AUTHORIZATION TO CONSTRUCT / OPERATION PERMIT / EXISTING SYSTEM INSPECTION

PERMIT# 76570 PIN# 4639-28-2129

OWNER OR CONTRACTOR Olivia Sanchez PHONE: Business 528 4564 Home DATE 9-25-98

ADDRESS 132 Dawn Lane Troutman, N.C.

LOCATION Perth Rd TR State PK

SUBDIVISION Lake Norman BLOCK / SECTION 18 LOT 58 LOT AREA .99 SITE CLASS. P5 DESIGN FLOW 360 L.T.A.R. .3

Septic Tank: 1000 Gallons; STB Date

Pump Tank: Gallons; PT Date

Pump Make: Model Serial No.

Nitrification Field: No Fields 1 Square Feet 300 Linear Feet 100

No Lines 2 Trench Width 36" Max Trench Bottom Depth 36" Gravel Depth 12"

☑ New System ☐ Repair System Type: I, II, III, IV, V, VI

System Description: Addition Conv. Gravity

Repair System Description: Pump to Conv.

Maintenance Agreement Required: ☐ Yes ☑ No

☑ House/Mod. Home No. Bedrooms 3

☐ Mobile Home No. Bathrooms 3

☐ Business No. Employees

☐ Other


☐ Slab ☑ Crawl Space ☐ Basement w/plumbing ☐ Basement wo/plumbing

Water Supply: ☑ Individual ☐ Public ☐ Community

Comments:/Conditions:

Lake Norman

INITIAL SITE SKETCH

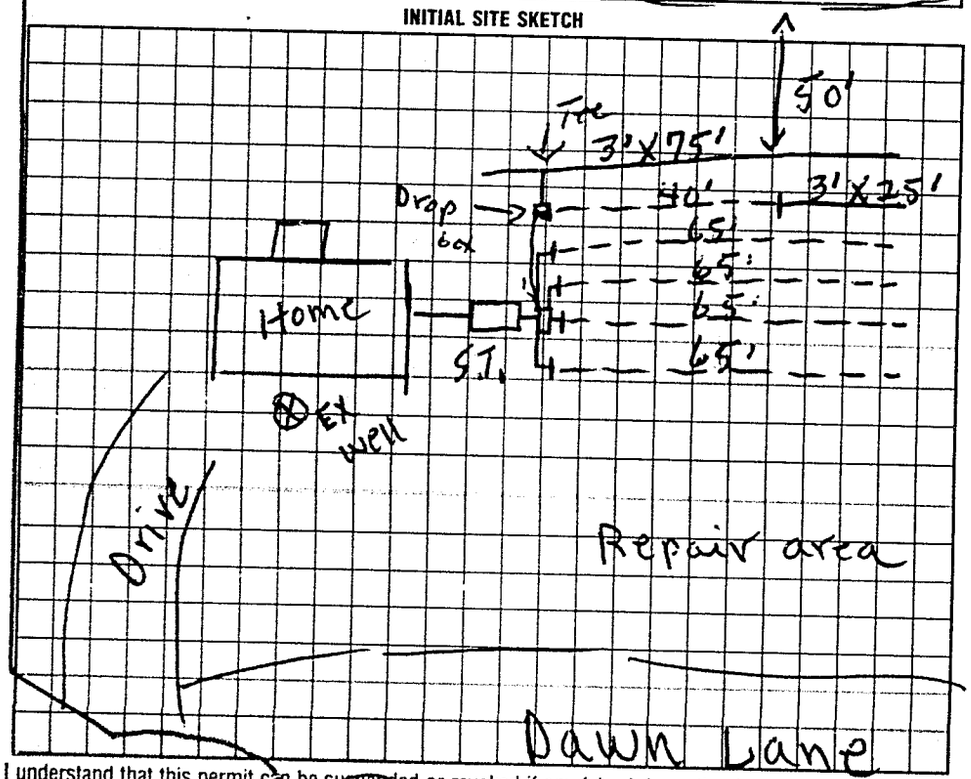

Comments:/Conditions: Renovating Ex Home To 3 bedroom upgrading System installed under upgrading Larry's Kiger 10-14-93

AS BUILT SKETCH

1000 gal 300' Drain line upgrading To 400'

Same as initial sketch

I understand that this permit can be suspended or revoked if any false information is supplied toward securing the permit/any unauthorized changes are made to the site/any unauthorized changes are made in the installation of the system. Improvement Permit with plat valid without expiration. Improvement Permit with site plan valid for sixty months. Authorization to Construct is valid for a period equal to that of Improvement Permit – not to exceed sixty months.

Signed: X date

Improvement Permit by: P.C. Moore date 9-25-98

Authorization to Construct by: P.C. Moore date 9-25-98

Installed by: K+K Grading

Operation Permit by: P.C. Moore date 11-6-98

Existing System Inspection by: date

HEALTH DEPT. COPY: WHITE INSPECTION COPY (FINAL): GREEN OWNER COPY (FINAL): YELLOW INSPECTION COPY (INITIAL): PINK OWNER COPY (INITIAL): GOLD