IREDELL COUNTY HEALTH DEPARTMENT

STATESVILLE 704-878-5305 MOORESVILLE 704-664-5281

IMPROVEMENT PERMIT / CERTIFICATE OF COMPLETION / OPERATION PERMIT / EXISTING SYSTEM INSPECTION

PROPERTY DESCRIPTION NO. Repair DATE 10-14-93 TAX MAP NO. Repair Watershed: ☐ Yes ☑ No

OWNER OR CONTRACTOR Larry Kiger PHONE: Business Home (919) 741-7993

ADDRESS

LOCATION Skatepark Rd TL Morrison Farm Rd TL Apache Lane TL Dawn Lane 2nd to last home on R.

SUBDIVISION Crescent Prop. BLOCK / SECTION 18 LOT 58 LOT AREA .99 acres SITE CLASS. P.S. DESIGN FLOW 240 L.T.A.R. .3 gpd/ft²

Septic Tank: 1000 Gallons; STB 794 Date 8-20-93
Pump Tank: — Gallons; PT — Date —
Pump Make: — Model — Serial No. —
Nitrification Field: No. Lines 1 Square Feet 900 Linear Feet 300'
No Lines 5 Trench Width 36" Max Trench Bottom Depth 36'

☐ New System ☑ Repair System Type: I ☐ II, III, IV, V, VI
System Description: conventional, gravity
Repair System Description: Pump PPBPS
Maintenance Agreement Required: ☐ Yes ☑ No
Gravel Depth 12" ☐ Slab ☑ Crawl Space ☐ Basement w/plumbing ☐ Basement wo/plumbing

☑ House/Mod. Home No. Bedrooms 2
☐ Mobile Home No. Bathrooms 2
☐ Business No. Employees
☐ Other


Water Supply: ☑ Individual ☐ Community ☐ Public

Comments:

Comments: System installed to accomidate 2 bedroom home instead of a 3 bedroom which was permit for originally. 100% Repair Area above system, pump to PPBPS.

INITIAL SITE SKETCH

AS BUILT SKETCH

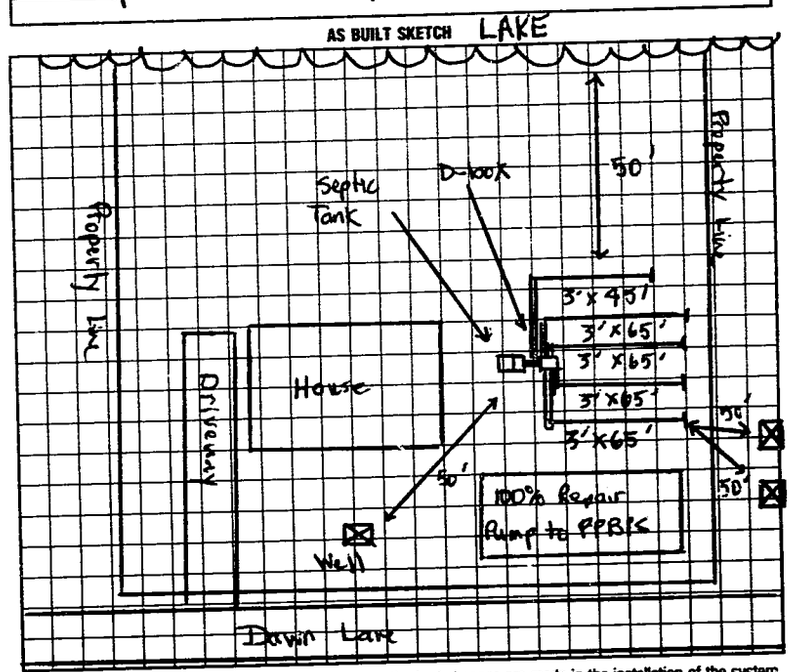

walls

I understand that this permit can be suspended or revoked if any false information is supplied toward securing the permit/any unauthorized changes are made to the site/any unauthorized changes are made in the installation of the system. Improvement Permit is valid for 60 months from date of issuance.

Signed:

Improvement Permit by: Michael L. Dennis date 5-21-93

Existing System Inspection by: date

Installed by: Wes Lytton

Certificate of Completion by: Michael L. Dennis / Steve Hedrick date 10-14-93

Operation Permit by: date

HEALTH DEPT. COPY: WHITE INSPECTION COPY (FINAL): GREEN OWNER COPY (FINAL): YELLOW INSPECTION COPY (INITIAL): PINK OWNER COPY (INITIAL): GOLD