IREDELL COUNTY HEALTH DEPARTMENT

STATESVILLE 704-878-5305 MOORESVILLE 704-664-5281

IMPROVEMENT PERMIT / AUTHORIZATION TO CONSTRUCT / OPERATION PERMIT / EXISTING SYSTEM INSPECTION

PERMIT# 130147 PIN# 4639283972 DATE 9-20-05

OWNER OR CONTRACTOR Mike Halford PHONE: Business 704-528-7562 Home 704 872-0000

ADDRESS 131 Crown Ct., Troutman, NC 28166

LOCATION Steele Park RD, to Morrison to Apache to Crown ~~Ct~~ court end

SUBDIVISION CLT BLOCK / SECTION 18 LOT 64 LOT AREA _____ SITE CLASS PS DESIGN FLOW 360 L.T.A.R. 1.2

Septic Tank: 1000 Gallons; STB Existing Date Existing

Pump Tank: _____ Gallons; PT _____ Date _____

Pump Make: _____ Model _____ Serial No. _____

Nitrification Field: No Fields ___ Square Feet 1200 Linear Feet 200

No Lines 4 Trench Width 36" Max Trench Bottom Depth 36" Gravel Depth _____

☐ New System ☐ Repair System Type: I (II) III, IV, V, VI

System Description: 50% Gravel

Repair System Description: 50% Gravel

Maintenance Agreement Required: ☐ Yes ☐ No

☐ House/Mod. Home No. Bedrooms 3

☐ Mobile Home No. Bathrooms ___

☐ Business No. Employees ___

☐ Other _____


☐ Slab ☑ Crawl Space ☐ Basement w/plumbing ☐ Basement wo/plumbing

Water Supply: ☑ Individual ☐ Public ☐ Community


Comments:/Conditions: Install on Contour
Maintain all setbacks

Comments:/Conditions:

INITIAL SITE SKETCH

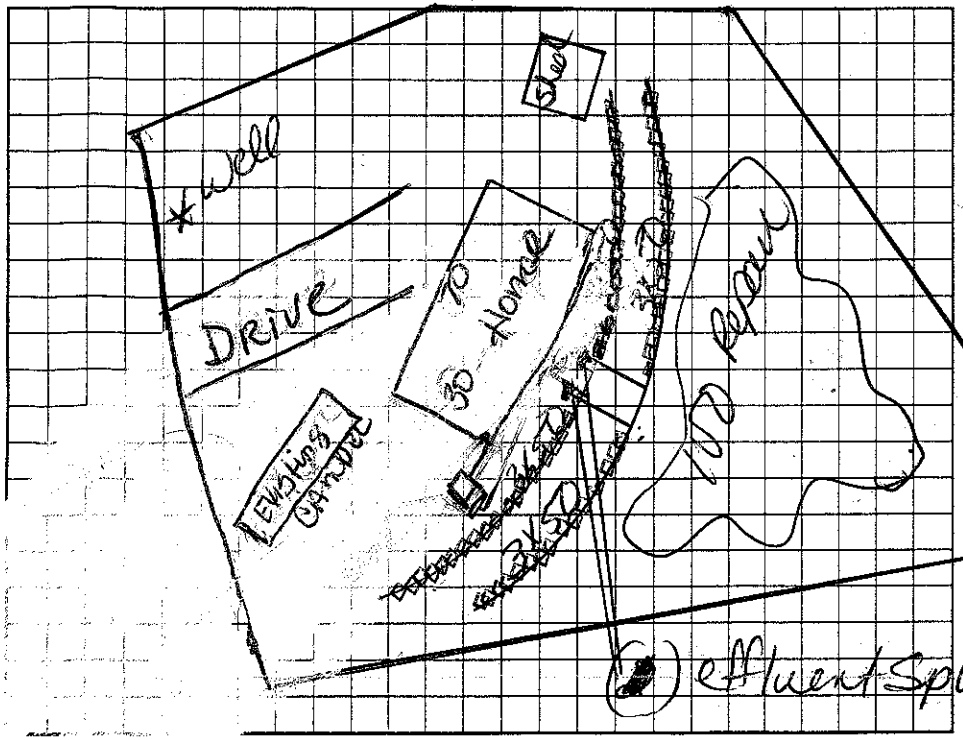

AS BUILT SKETCH

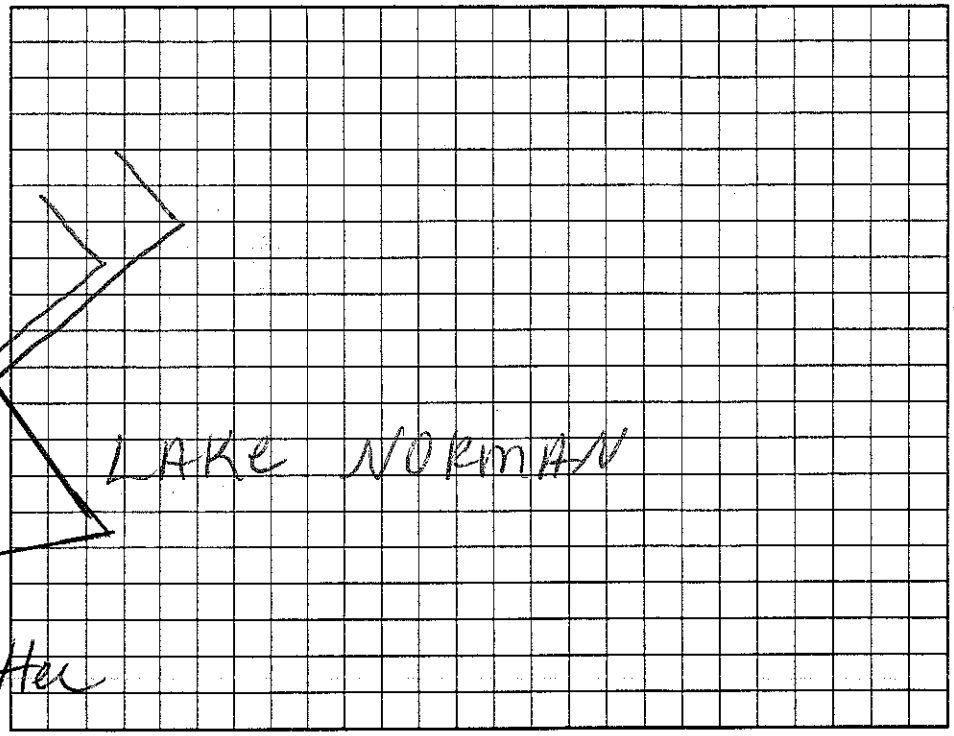

Permit can be suspended or revoked if any false information is supplied toward securing the permit/any unauthorized changes are made to the site/any unauthorized changes are made in the installation of the system. Improvement Permit is valid without expiration. Improvement Permit with site plan valid for sixty months. Authorization to Construct is valid for a period equal to that of Improvement Permit – not to exceed sixty months.

Sig Dennis Gaylor date 9-26-05 Installed by: A-1 Backhoe

Improvement Permit by: Kelly Cook date 9-20-05 Operation Permit by: Kelly Cook date 9-28-05

Authorization to Construct by: Kelly Cook date 9-20-05 Existing System Inspection by: _____ date _____

HEALTH DEPT. COPY: WHITE OWNER COPY (FINAL): YELLOW OWNER COPY (INITIAL): PINK