IREDELL COUNTY HEALTH DEPARTMENT

Statesville Phone TR 3-7271 Mooresville Phone NO 3-1271

PERMIT TO INSTALL SEPTIC TANK

Permit No. 68 Permit Date 5-19 1972

Owner Bob Troutman Address W. Jefferson N.C.

Installed By Sam Ostwalt Address Troutman N.C.

Location of Property Turn on Perth Church Road at Troutman T.L. on State Park Rd. T.L. on Rd #1321 T.L. 1st Road T.L. Again. Then T.R. at Tin Road Trailer on R

Tank		Capacity		Length of Lines		Fixtures	
Block	( )	1000	(✓)	225'	(✓)	No. of Baths	(1)
Precast	(✓)	1250	( )	250'	( )	Dishwasher	( )
		1500	( )	Other		Garbage Grdr.	( )
		Other				Other	

NOTIFY HEALTH DEPARTMENT AT LEAST EIGHT HOURS BEFORE TANK IS TO BE INSPECTED.

Final Inspection 5-19 1972 Approved (✓) Disapproved ( )

Remarks No well down yet

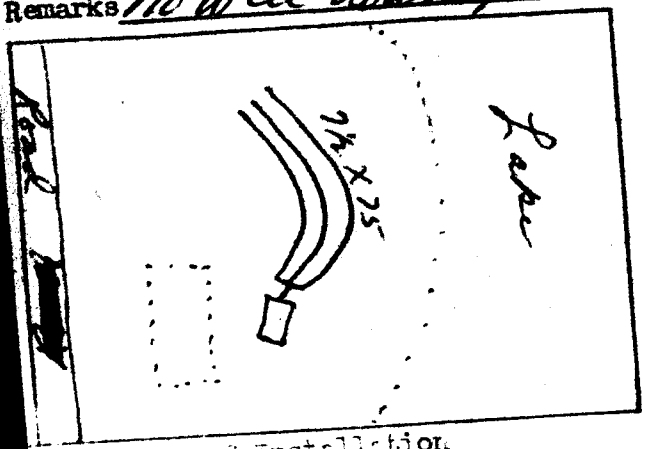


Diagram of Installation

E. A. Stevenson

Sanitarian