IREDELL COUNTY HEALTH DEPARTMENT

Statesville Office (704) 878-5305 Mooresville Office (704) 660-3625 PERMIT # 206228

IMPROVEMENT PERMIT / AUTHORIZATION TO CONSTRUCT / OPERATION PERMIT / EXISTING SYSTEM

PIN # 4639-30-5108

APPLICANT: Bryce Huffstetler APPLICANT ADDRESS: 419 Kenway Loop Rd

SITE ADDRESS: 419 Kenway Loop Rd PHONE: (704) 528 4264 ALT. PHONE: (980) 254-1955 (cell)

SITE DIRECTIONS: Go 150 W TR on Perth Rd TL on Jean Hill Rd

SUBDIVISION: C L & T SECTION: 15 LOT # 24 LOT AREA: DESIGN FLOW: 360 L.T.A.R.:

Septic Tank 1000 (gal) STB 760 Date 6-16-14
Pump Tank (gal) PT Date
Pump Make Model Serial #
Nitrification Fields # Lines Linear Ft:
Trench Width Max. Trench Bottom Depth Gravel Depth


☐ New System ☑ Repair ☐ Expansion System Type: I (II) III IV V VI
System Description: existing 5 x 125' conventional bed
Repair System Description: pump to area inside circle drive
Maintenance Agreement Required: ☐ YES ☑ NO
☑ GRAVITY ☐ PRESSURE

☑ Residence No. Bedrooms 3
☐ Business No. Persons
☐ Other No. Employees
☐ Slab ☐ Crawl Space
☑ Basement w/plumbing ☐ Basement w/o plumbing

Water Supply: ☑ Private ☐ Public ☐ Community

Comments / Conditions: Pump/Crush/Fill existing tank and replace with new tank w/riser. New tank can set as close as 5' from property line and minimum 15' from basement. Run solid pipe from new tank to clean gravel

INITIAL SITE SKETCH

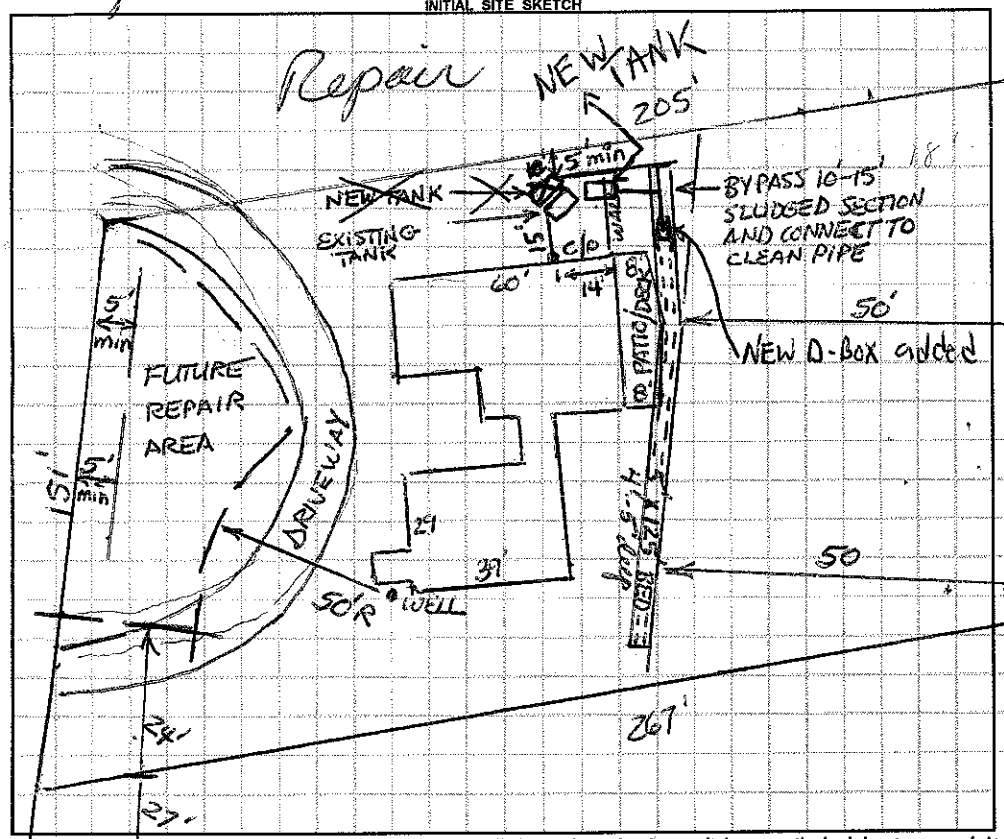

AS BUILT SKETCH

*A new D-Box was added approx. 18' from the beginning of original bed

* Risers were added to new Septic Tank

Permit can be suspended or revoked if any false information is supplied toward securing the permit / any unauthorized changes are made to the site / any unauthorized changes are made in the installation of the system. **CONTACT A LOCATOR SERVICE PRIOR TO ANY EXCAVATION**

☐ **IMPROVEMENT PERMIT** *with plat valid without expiration.* ☑ **IMPROVEMENT PERMIT** *with site plan valid for 60 mos.* ☑ **AUTHORIZATION TO CONSTRUCT** *valid for period equal to IMPROVEMENT PERMIT--not to exceed 60 mo.*

Owner / Applicant Signature: Date: Installed by: Lentz

IMPROVEMENT PERMIT by: Richard Farris Date: 10/20/14 OPERATION PERMIT by: Date: 10-21-14

AUTHORIZATION TO CONSTRUCT by: Richard Farris Date: 10/20/14 Existing System Inspected by: Date:

Health Dept. Copy - WHITE Applicant (Final Approval) - YELLOW Applicant (Conditional Approval) - PINK