IREDELL COUNTY HEALTH DEPARTMENT

Statesville Phone TR 3-7271 Mooresville Phone NO 3-1271

PERMIT TO INSTALL SEPTIC TANK

Permit No. 64 Permit Date 6-14 1971

Owner HERMAN Mayberry Address Rt. 10 - STATESVILLE -

Installed By ADAMS Address TAYLORSVILLE, NC

Location of Property

FERN HILL Church Rd.


SECTION 15 - LOT - 16 ?

Tank		Capacity		Length of Lines		Fixtures	
Block	( )	1000	(✓)	225'	(✓)	No. of Baths	(✓)
Precast	(✓)	1250	( )	250'	( )	Dishwasher	( )
		1500	( )	Other		Garbage Grdr.	( )
		Other				Other	

NOTIFY HEALTH DEPARTMENT AT LEAST EIGHT HOURS BEFORE TANK IS TO BE INSPECTED.

Final Inspection 6 - 14 1971 Approved (✓) Disapproved ( )

Remarks

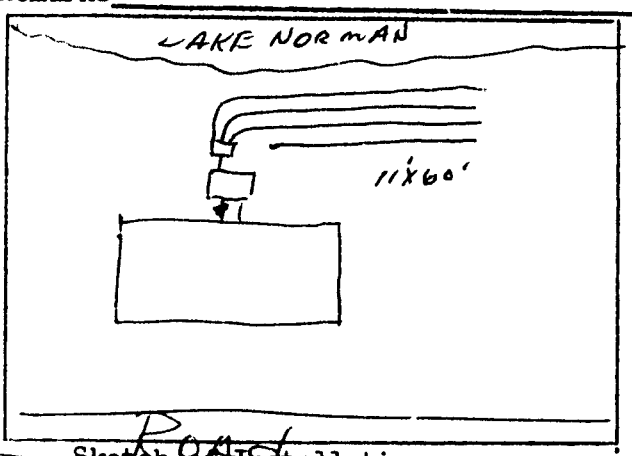

Sketch of Installation

Sanitarian