375 3:00

IREDELL COUNTY HEALTH DEPARTMENT

STATESVILLE 704-878-5305 MOORESVILLE 704-664-5281

IMPROVEMENT PERMIT / AUTHORIZATION TO CONSTRUCT / OPERATION PERMIT / EXISTING SYSTEM INSPECTION

PERMIT# 35560 PIN# 4639 29 9711.059 4639-31-5688 DATE June 9, 2006

OWNER OR APPLICANT Woodbridge Gardens LLC / Quest Home PHONE: Business _____ Home _____

ADDRESS P.O. Box 3608, Mooresville N.C. 28117

LOCATION Sterling Rd. (N) to Fern Hill Tr. Kenway Loop on Right #354 Kenway

SUBDIVISION Woodleaf BLOCK / SECTION _____ LOT 59 LOT AREA .987 ac SITE CLASS. RS DESIGN FLOW 400gpd L.T.A.R. .03

Septic Tank: 1000 Gallons: STB 1012 Date 9-11-01

Pump Tank: 1000 Gallons: PT 17 Date 2-28-08

Pump Make: Goulds Model: WE03111M Serial No. _____

Nitrification Field: No Fields 1 Square Feet 1200 Linear Feet 400

No Lines 5@80' Trench Width 36" Max Trench Bottom Depth 36" Gravel Depth NA ☐ Gravity ☒ Pressure

☒ New System ☐ Repair ☐ Expansion System Type: I, II, III, IV, V, VI

System Description: pm 25% Reduction

Repair System Description: LPPPBPS

Maintenance Agreement Required: ☐ Yes ☒ No Initially

☒ House/Mod. Home ☐ Mobile Home ☐ Business ☐ Other _____

No. Bedrooms 4 No. Persons _____ No. Employees _____

Water Supply: ☒ Individual ☐ Public ☐ Community

☐ Slab ☒ Crawl Space ☐ Basement w/plumbing ☐ Basement wo/plumbing

Comments:/Conditions: 5/1/07 Reviewed floor plans, essentially in compliance with I.P. 6/12/08 2ft pressure set

Comments:/Conditions: Okay to move tanks to other side of house

4/17/08 Checked tanks & lines

INITIAL SITE SKETCH

Per Craig replaced Tri-Check

SEE PLAN from SAME

AS BUILT SKETCH

Installed 4 lines @ 100ft ea Quick 4


Permit can be suspended or revoked if any false information is supplied toward securing the permit/any unauthorized changes are made to the site/any unauthorized changes are made in the installation of the system. Improvement Permit with plat valid without expiration ☐ Improvement Permit with site plan valid for sixty months ☒ Authorization to Construct is valid for a period equal to that of Improvement Permit – not to exceed sixty months.

Signed: _____ date 6-29-06 Installed by: Craig Thompson

Improvement Permit by: _____ date 6-9-06 Operation Permit by: Marian Nelson RS date 9/25/08

Authorization to Construct by: Marian Nelson RS date 5/1/07 Existing System Inspection by: _____ date _____

HEALTH DEPT. COPY: WHITE OWNER COPY (FINAL): YELLOW OWNER COPY (INITIAL): PINK

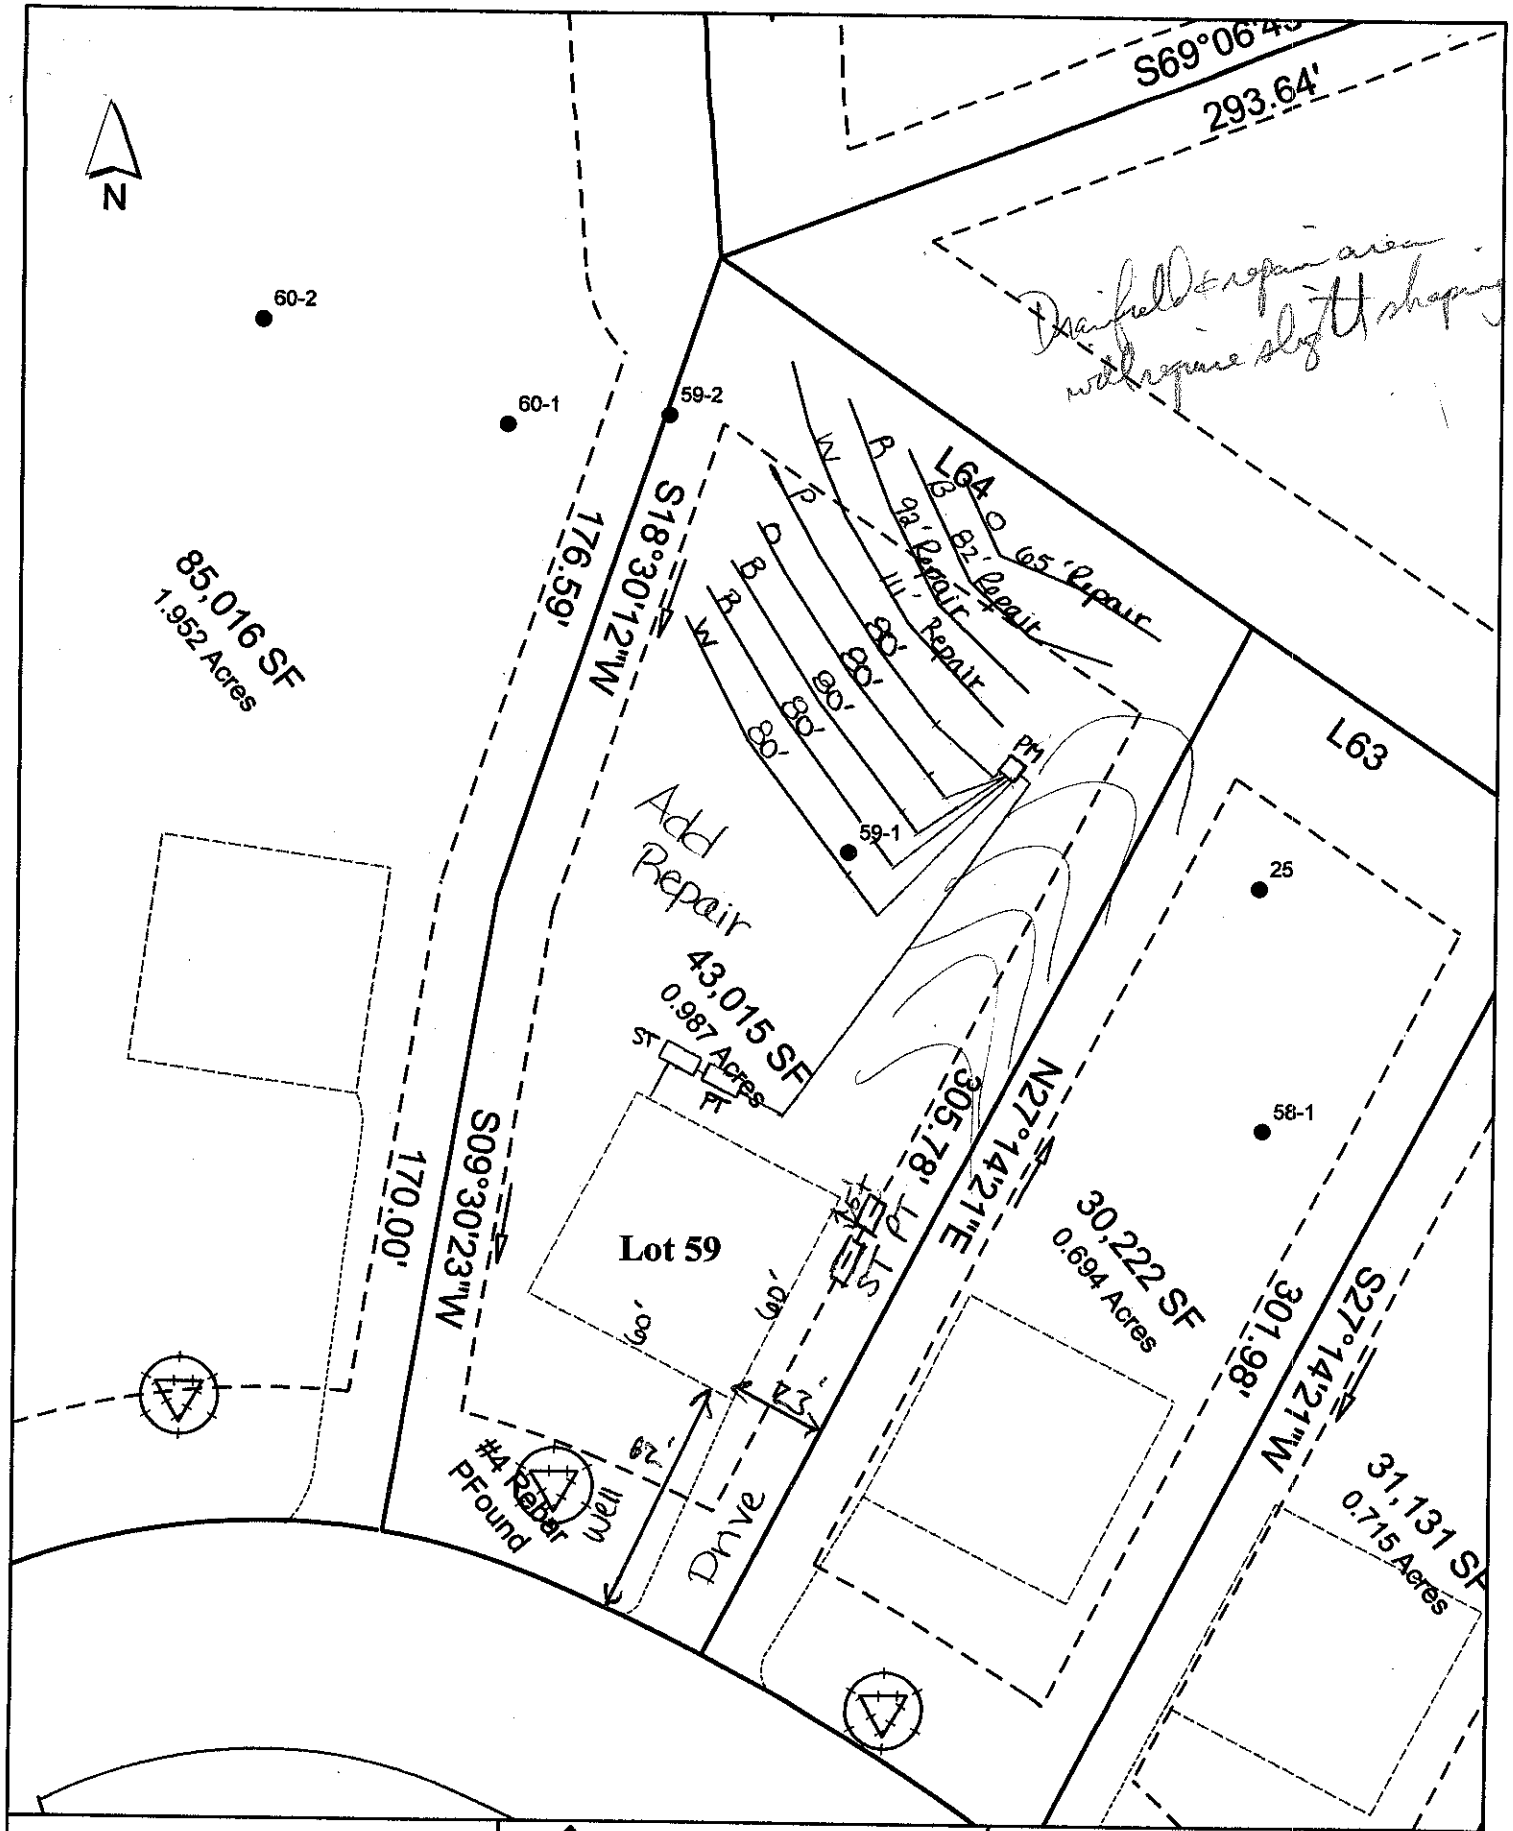

Scale: 1 inch equals 50 feet	S&ME ENVIRONMENTAL SERVICES · ENGINEERING · TESTING	Woodleaf - Phase I	FIGURE 1
Drawn by: JBP		Lot 59	
Reviewed by: PGP		Iredell County, NC	
Date: May, 2006		S&ME Project #1588-05-121	