IREDELL COUNTY HEALTH DEPARTMENT

STATESVILLE 704-878-5305 MOORESVILLE 704-664-5281

IMPROVEMENT PERMIT / ~~CERTIFICATE OF COMPLETION~~ / OPERATION PERMIT / EXISTING SYSTEM INSPECTION

Authorization to Construct 4639316204

PROPERTY DESCRIPTION NO. 22730 DATE 1/3/96 TAX MAP NO. 25 5A 19 Watershed: X Yes ☐ No

OWNER OR CONTRACTOR T W Steele PHONE: Business Home 528-4678

ADDRESS 381 Kenway Loop Mooresville NC 28115

LOCATION Perth Rd N TL Ferd Hilp Rd. TL Bagley Rd. TL Kenway Loop, 2 lots past #381 on (R)

SUBDIVISION C L + T BLOCK / SECTION 15 LOT 10,30 LOT AREA ~1.6Ac SITE CLASS. PS DESIGN FLOW 360 L.T.A.R. 3

Septic Tank: 1000 Gallons; STB 825 Date 6/11/96

Pump Tank: Gallons; PT Date

Pump Make: Model Serial No.

Nitrification Field: No Fields 1 Square Feet 1200 Linear Feet *300 (400)

No Lines 3 Trench Width 36" Max Trench Bottom Depth 36" Gravel Depth 6" SAND

X New System ☐ Repair System Type: I, II, III, IV, V, VI

System Description: Conv. w/infiltrator

Repair System Description: None

Maintenance Agreement Required: X Yes ☐ No 5 YR.

X House/Mod. Home ☐ Mobile Home ☐ Business ☐ Other

No. Bedrooms 3 No. Bathrooms 3 No. Employees


☐ Slab ☐ Crawl Space X Basement w/plumbing ☐ Basement wo/plumbing

Water Supply: X Individual ☐ Community ☐ Public


Comments: *25% Reduction for infiltrator use
Sand backfill required to top of louvers on each panel section
WAIVED NORMAN

Comments:

INITIAL SITE SKETCH

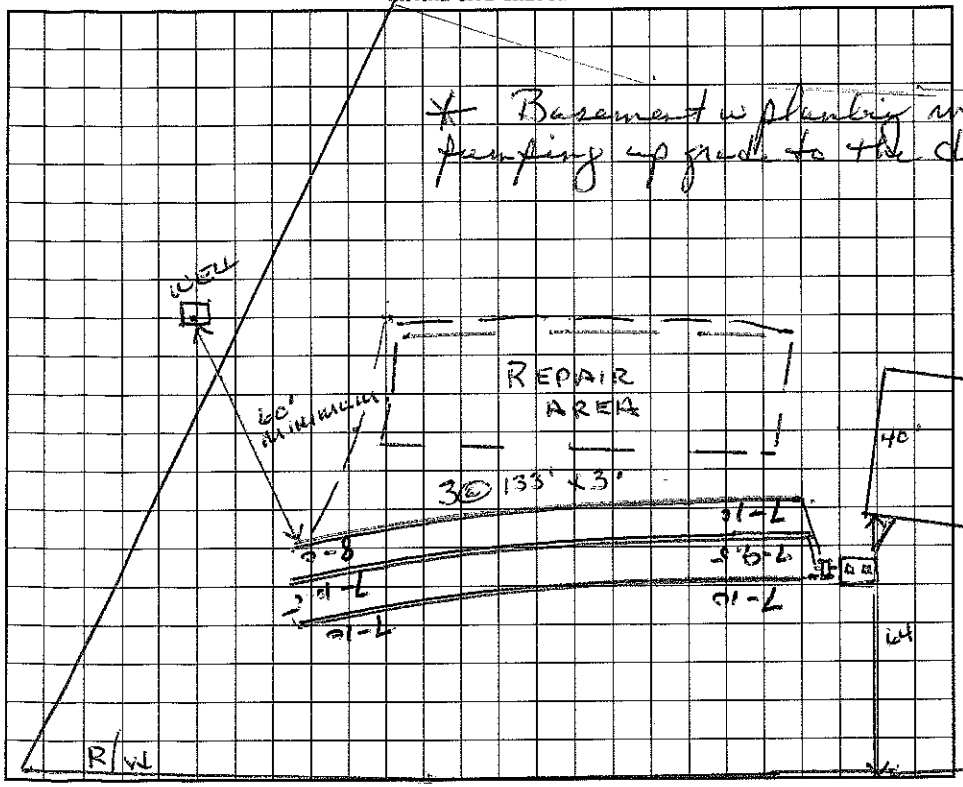

AS BUILT SKETCH

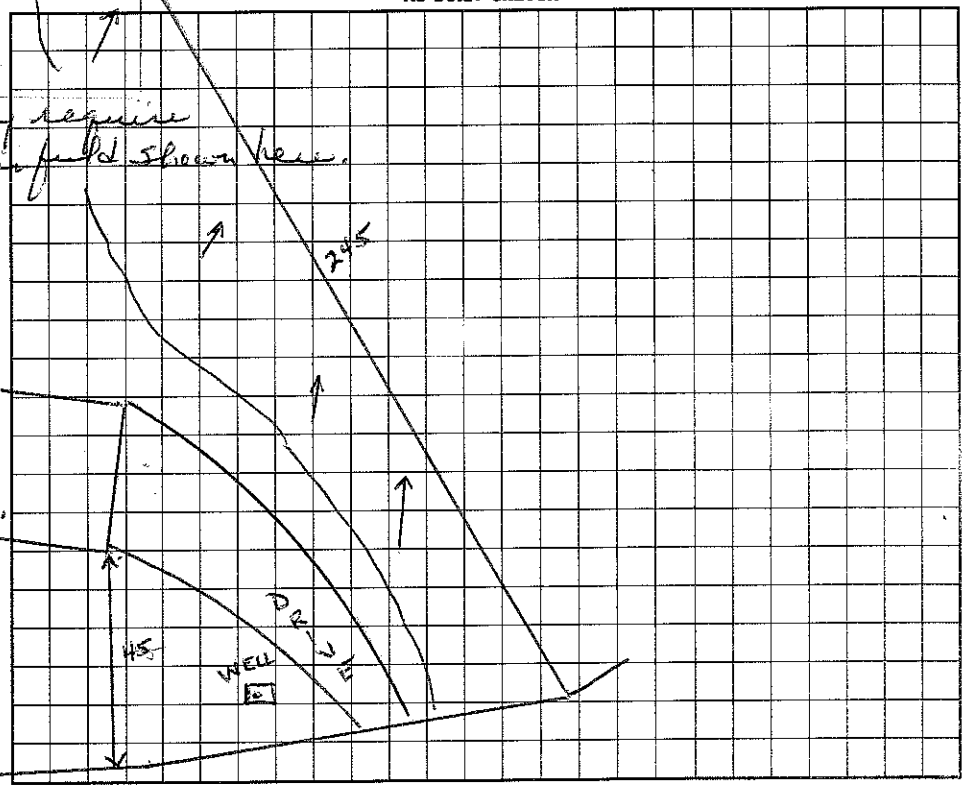

I understand that this permit can be suspended or revoked if any false information is supplied toward securing the permit/any unauthorized changes are made to the site/any unauthorized changes are made in the installation of the system.

X Signed: T. W. Steele Kenway Loop. Rd.

Improvement Permit by: Wesley Sparks R.S. date 1/13/96

Authorization to Construct Existing System Inspection by: Wesley Sparks R.S. date 1/13/96

Installed by: Wayne Clontz.

Certificate of Completion by: date

Operation Permit by: Wesley Sparks R.S. date 8/5/96

HEALTH DEPT. COPY: WHITE INSPECTION COPY (FINAL): GREEN OWNER COPY (FINAL): YELLOW INSPECTION COPY (INITIAL): PINK OWNER COPY (INITIAL): GOLD